


BOTH SIDES

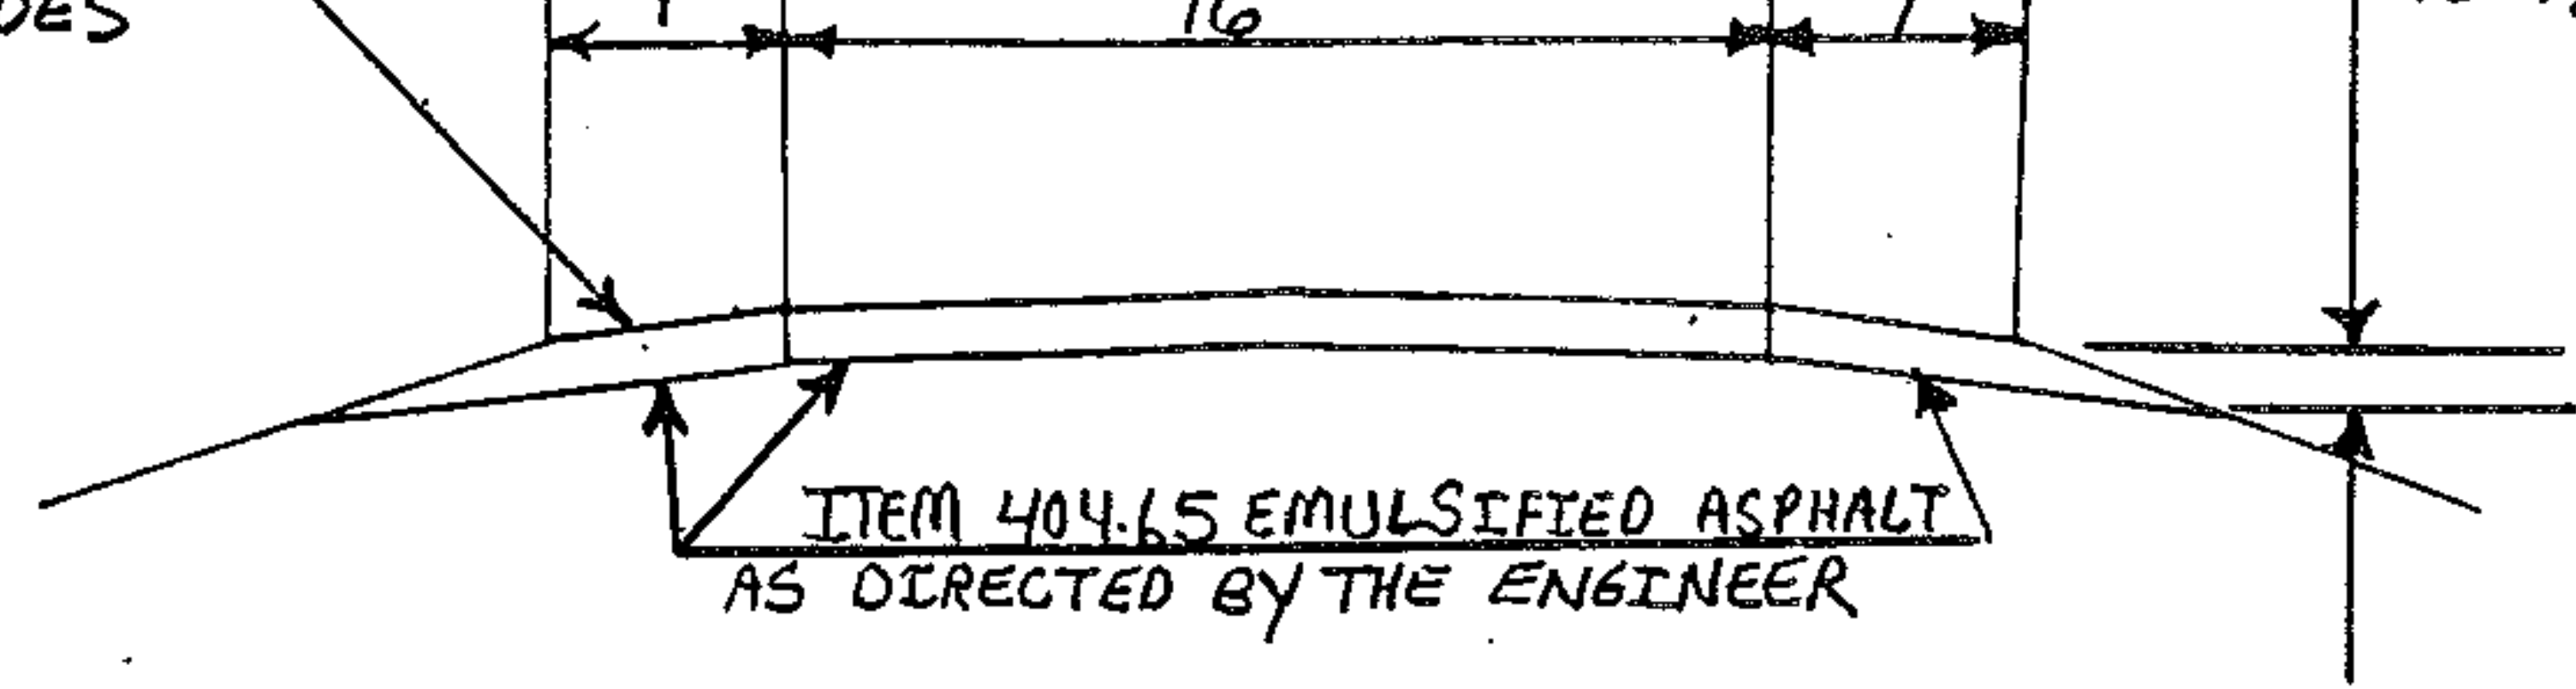

RAMP LETTER	EXCHANGE NUMBER	LENGTH FEET	1982 ADT	LEVEL COURSE DEPTH	LANE	BOTH PAVED SHOULDER WIDTH	WIDTH OF TRAVELWAY	TOWN
E	2	1359	720	1/2"	EAST BOUND	4'	16'	FAIR HAVEN
F	2	1152	240	1/2"	EAST BOUND	4'	16'	FAIR HAVEN
G	2	1613	240	1/2"	WEST BOUND	4'	16'	FAIR HAVEN
H	2	1354	720	1/2"	WEST BOUND	4'	16'	FAIR HAVEN
K	3	1057	345	1/2"	EAST BOUND	4'	16'	FAIR HAVEN
L	3	1236	345	1/2"	WEST BOUND	4'	16'	FAIR HAVEN
N	4	1600	420	1/2"	EAST BOUND	4'	16'	CASTLETON
P	4	1490	1210	1/2"	EAST BOUND	4'	16'	CASTLETON
Q	4	1420	350	1/2"	WEST BOUND	4'	16'	CASTLETON
R	4	1292	1140	1/2"	WEST BOUND	4'	16'	CASTLETON

PROJECT FAIR HAVEN - CASTLETON

NO. F020-1(16)
SHEET 6 OF 40