


AS DIRECTED BY THE ENGINEER  
3/4" WEARING COURSE TYPE IV

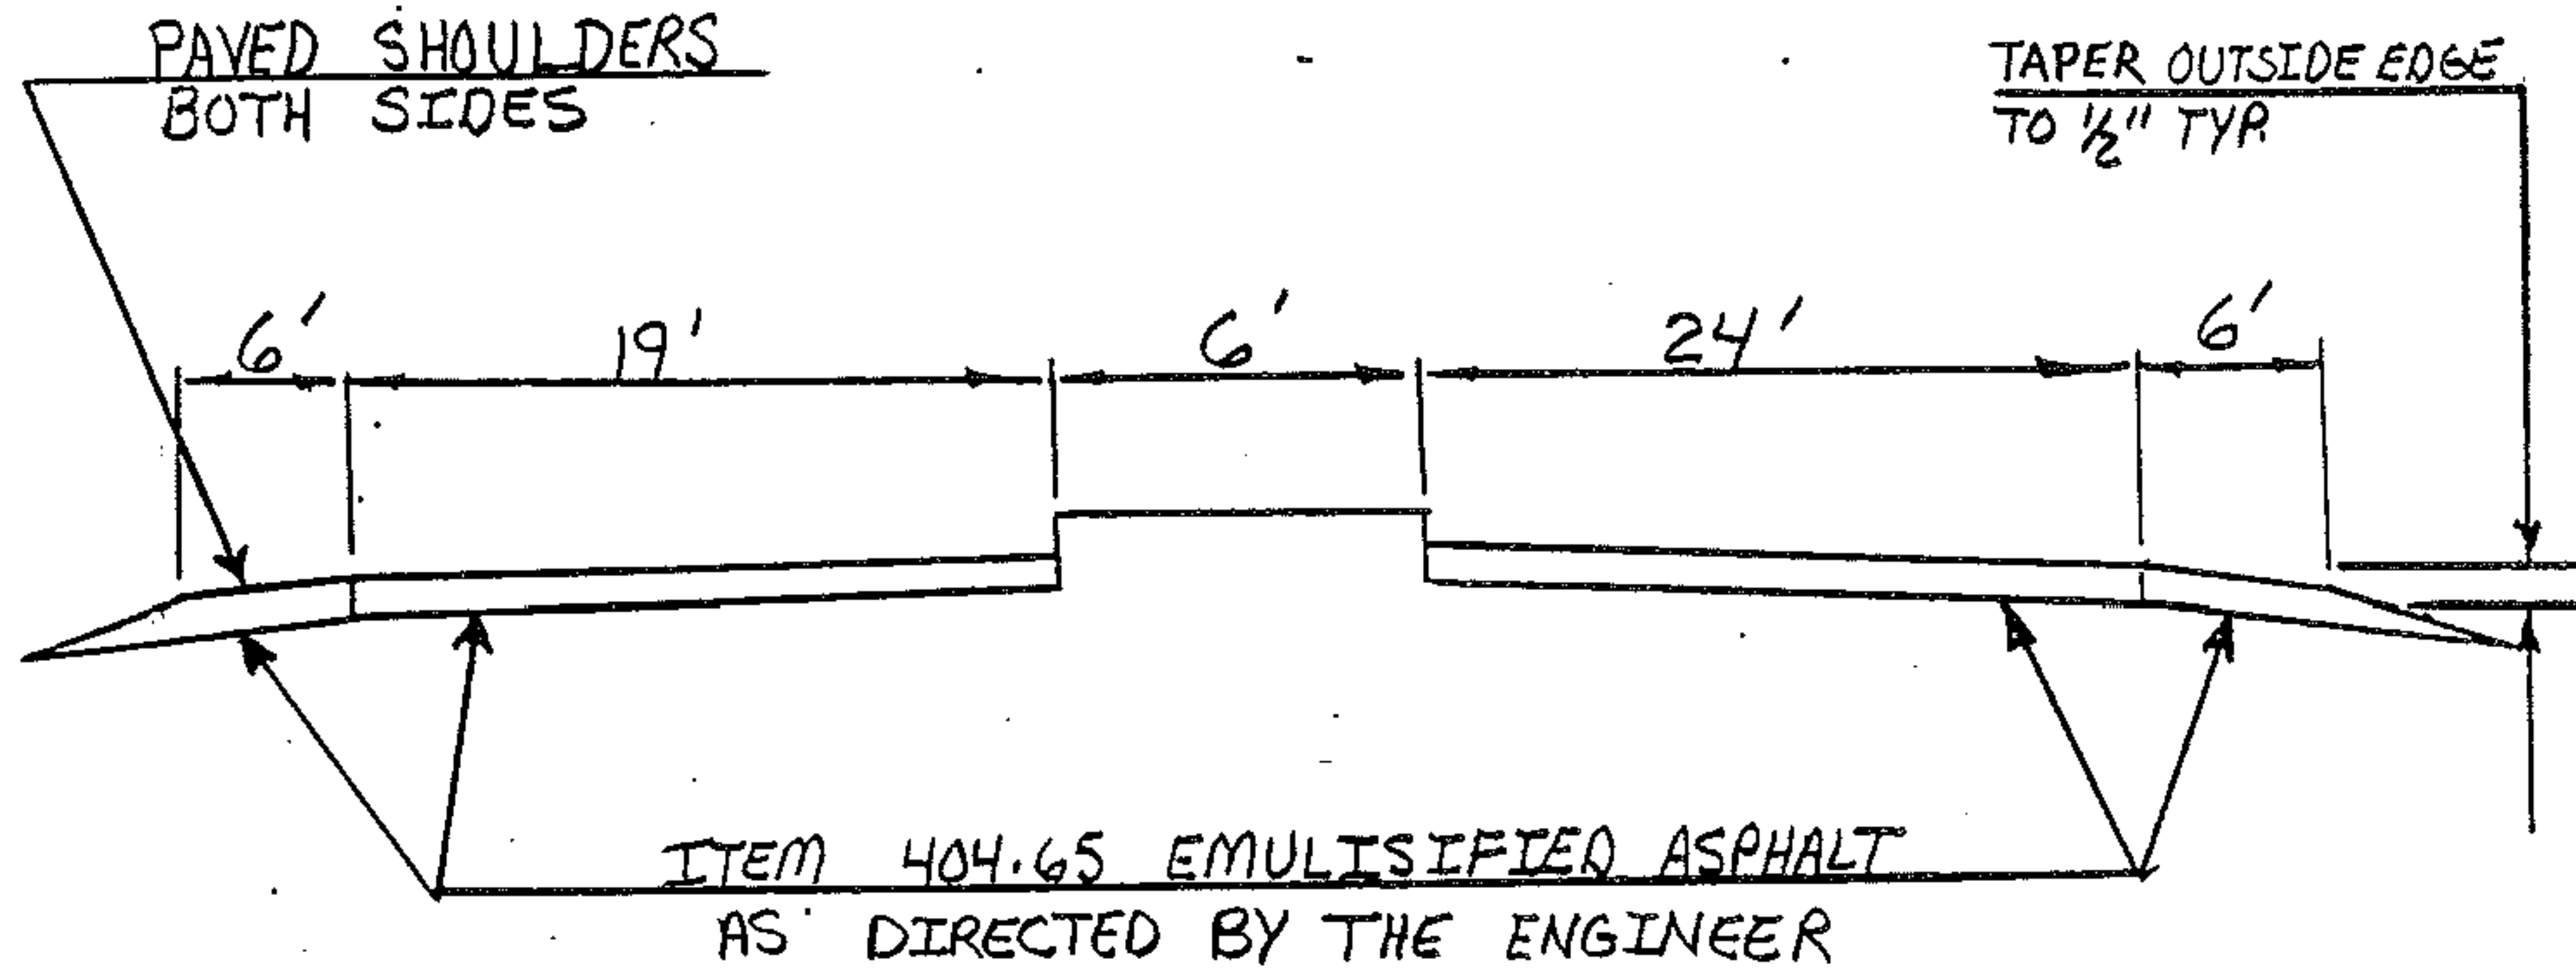

VT. 4-A

mm 0.097 ~ mm 0.142

PROJECT FAIR HAYEN - CASTLETON

NO. F 020-1(16)

SHEET 9 OF 40 SHEETS