


3/4" WEARING COURSE TYPE IV

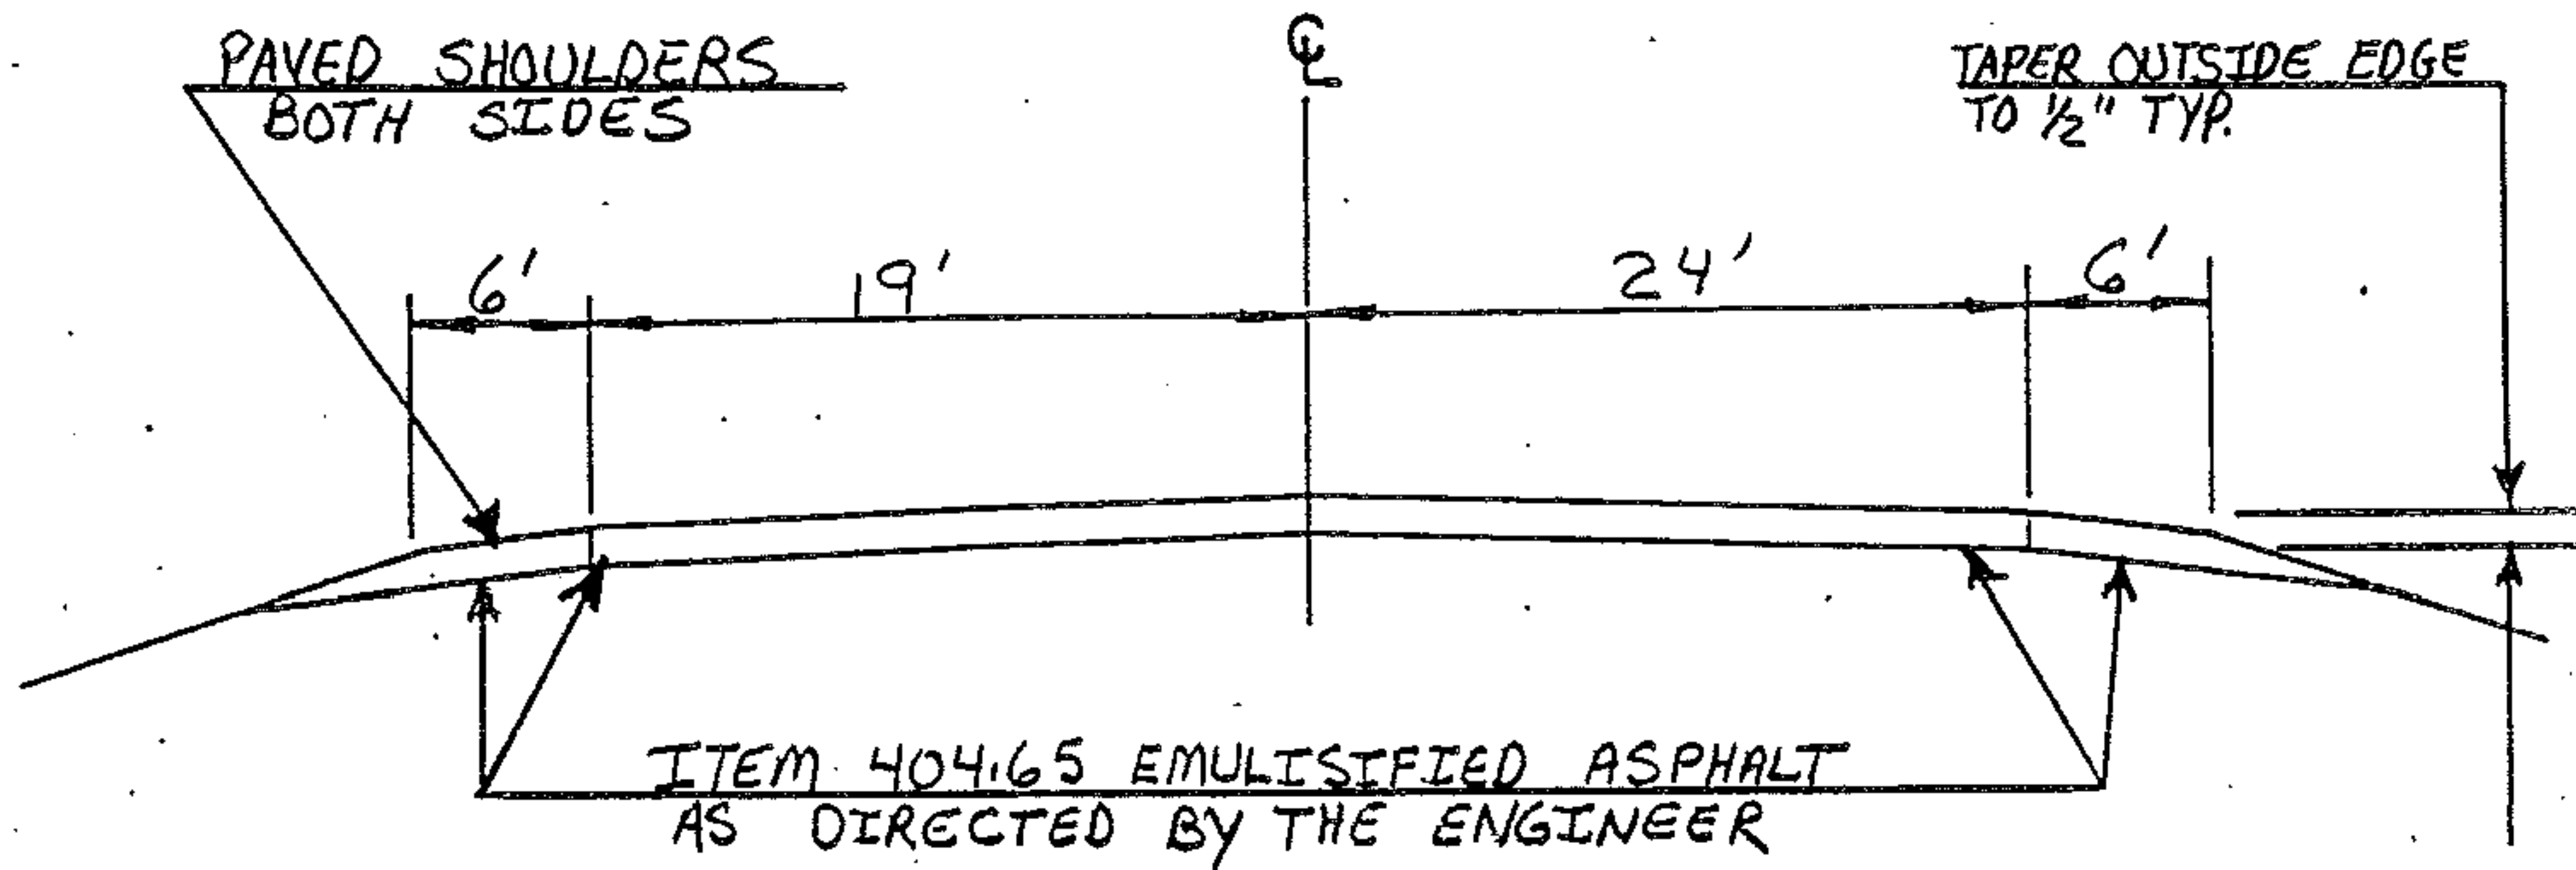

VT. 4-A
mm 0.142 ~ mm 0.243

PROJECT FAIR HAVEN - CASTLETON

NO. F020-1 (16)
SHEET 10 OF 40 SHEETS