


INTERCHANGE #2

SURVEYED BY	DATE
DRAWN BY REDMOND	DATE 7-85
TRACED BY REDMOND	DATE 1-85
U.S. 4	
FAIR HAVEN-CASTLETON	
PROJ. NO.	
SHEET 15	OF 40

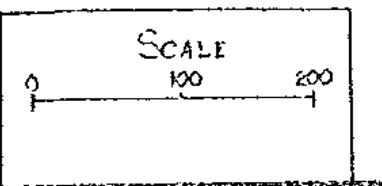

DATUM	
VERTICAL	
HORIZONTAL	