


INTERCHANGE #3
 US ROUTE 4
 FAIR HAVEN-CASTLETON

SURVEYED BY _____ DATE _____
 DRAWN BY _____ DATE _____
 TRACED BY E. BAUMGARTNER DATE _____

PROJ. NO.
 SHEET 16 OF 40

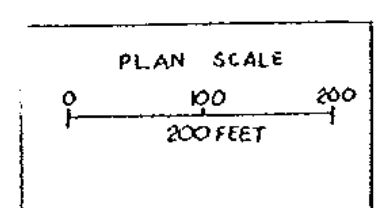

DATUM _____
 VERTICAL _____
 HORIZONTAL _____