


COLORS
 LEGEND AND BORDER - GREEN
 WHITE SYMBOL ON BLUE BACKGROUND
 BACKGROUND - WHITE
 FOR MATERIALS, SEE STD. E-15B

SURVEYED BY _____ DATE _____
 DRAWN BY 7B DATE 5-85
 TRACED BY _____ DATE _____
 FAIR HAVEN - CASTLETON
 PROJ. NO. 020-1(16)
 SHEET 18 OF 40

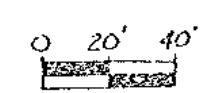

DATUM _____
 VERTICAL _____
 HORIZONTAL _____