



OBL. 4"  
YELLOW  
CENTERLINE

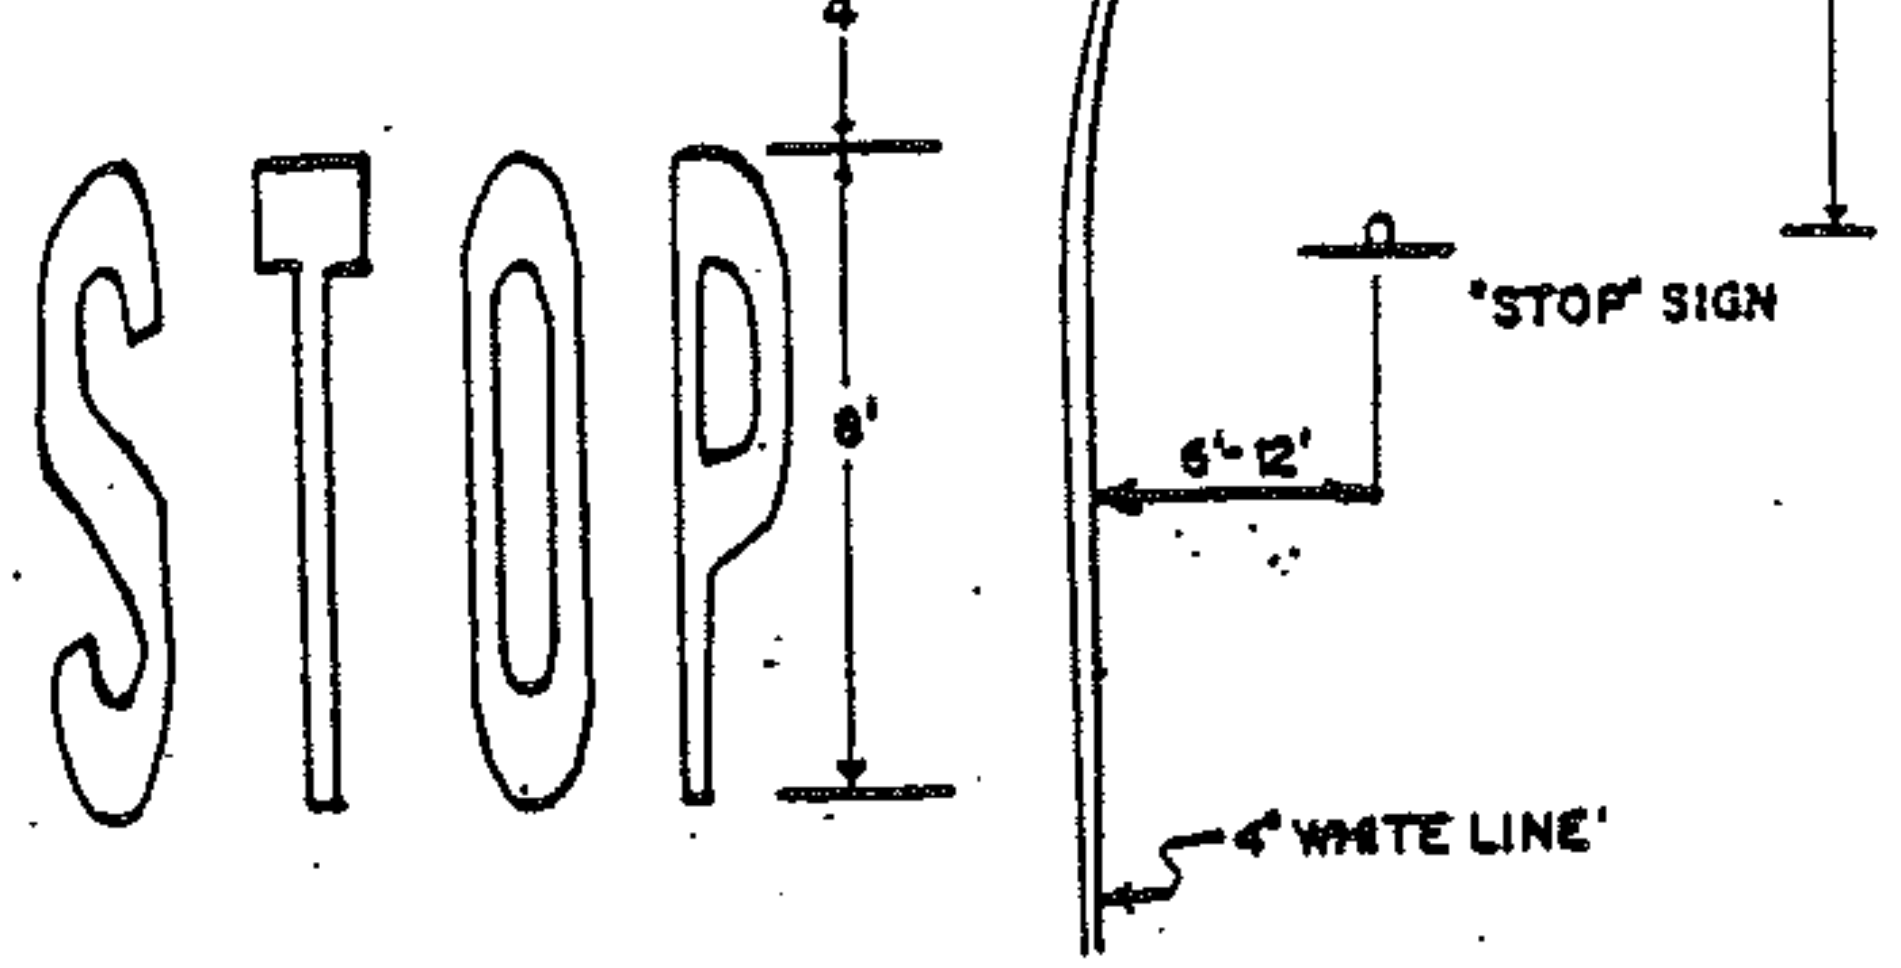

NOTE. PAVEMENT MARKING DETAILS

1. THE STOP LINE SHOULD BE PLACED AT THE DESIRED STOPPING POINT, IN NO CASE MORE THAN 30 FEET OR LESS THAN 4' FROM THE NEAREST EDGE OF THE INTERSECTING ROADWAY.

*With Signal*

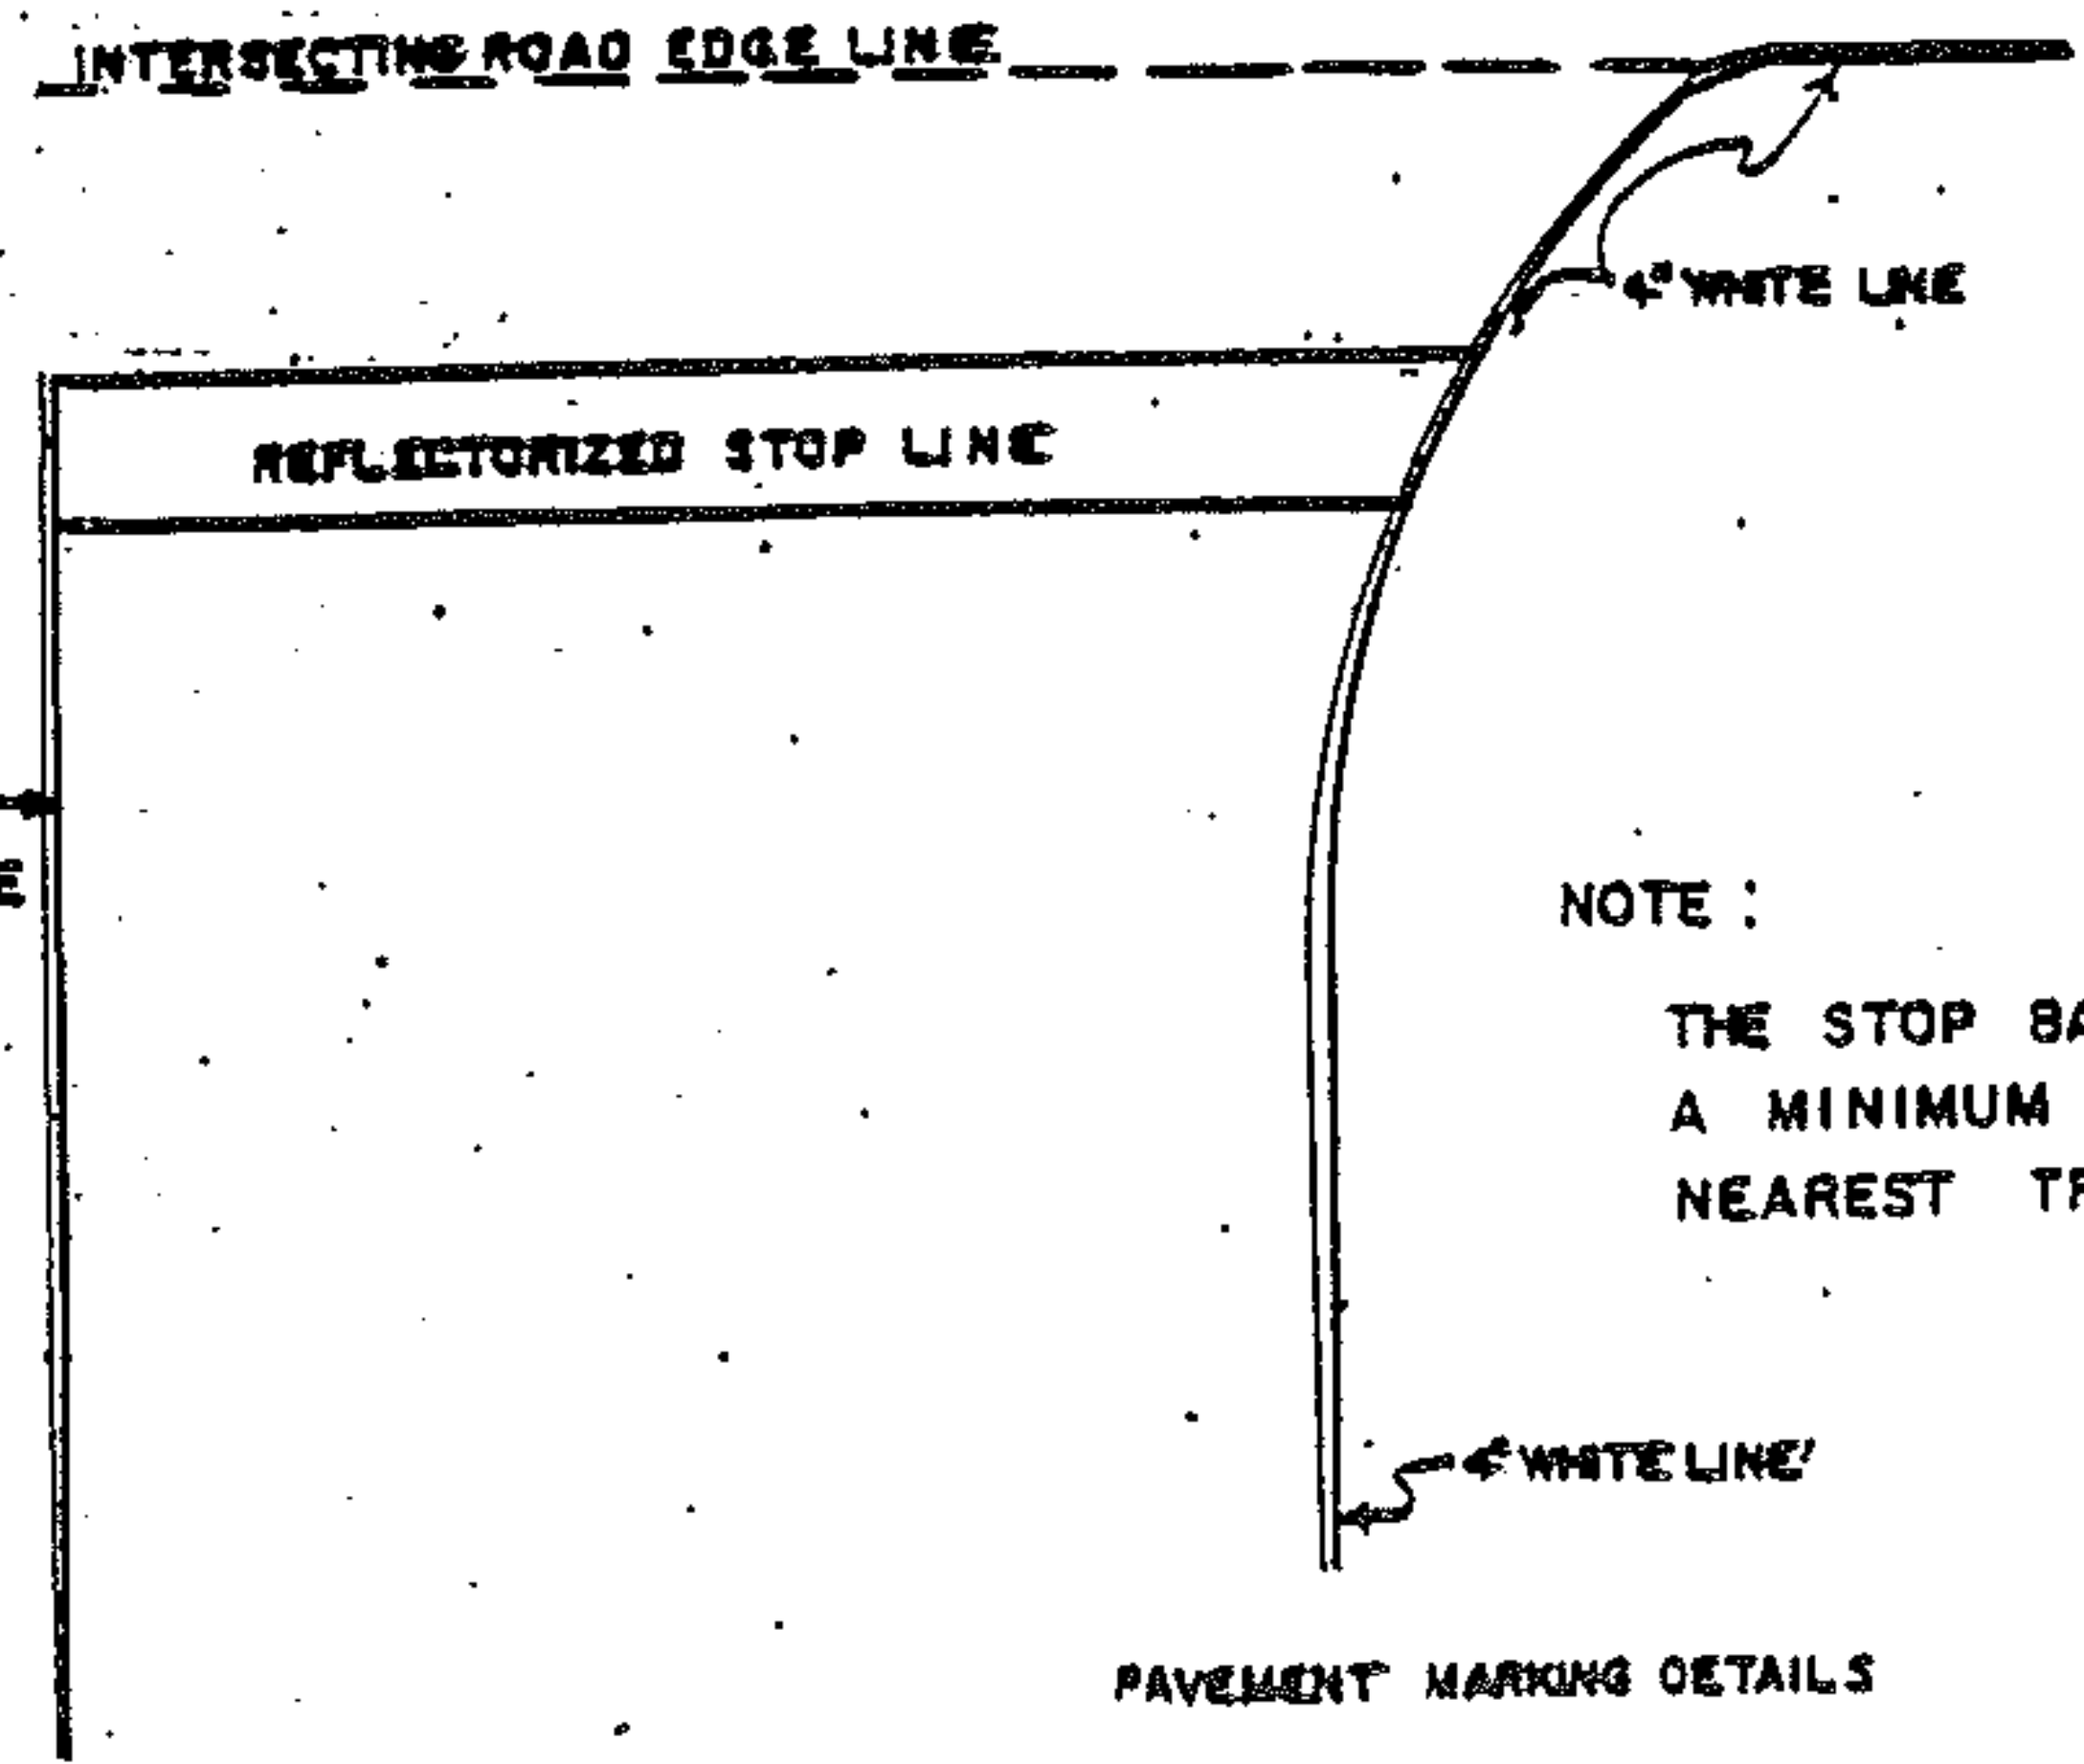

NOTE:  
THE STOP BAR SHALL BE PLACED  
A MINIMUM OF 40' FROM THE  
NEAREST TRAFFIC SIGNAL.

PAVEMENT MARKING DETAILS

FAIR HAVEN - CASTLETON

PROJECT FAIR HAVEN JUGHANDLE

F020-1(16)  
NO. RS 0142(14)

SHEET 24 OF 40 SHEETS