


# PROJECT DESCRIPTION AND LOCATION

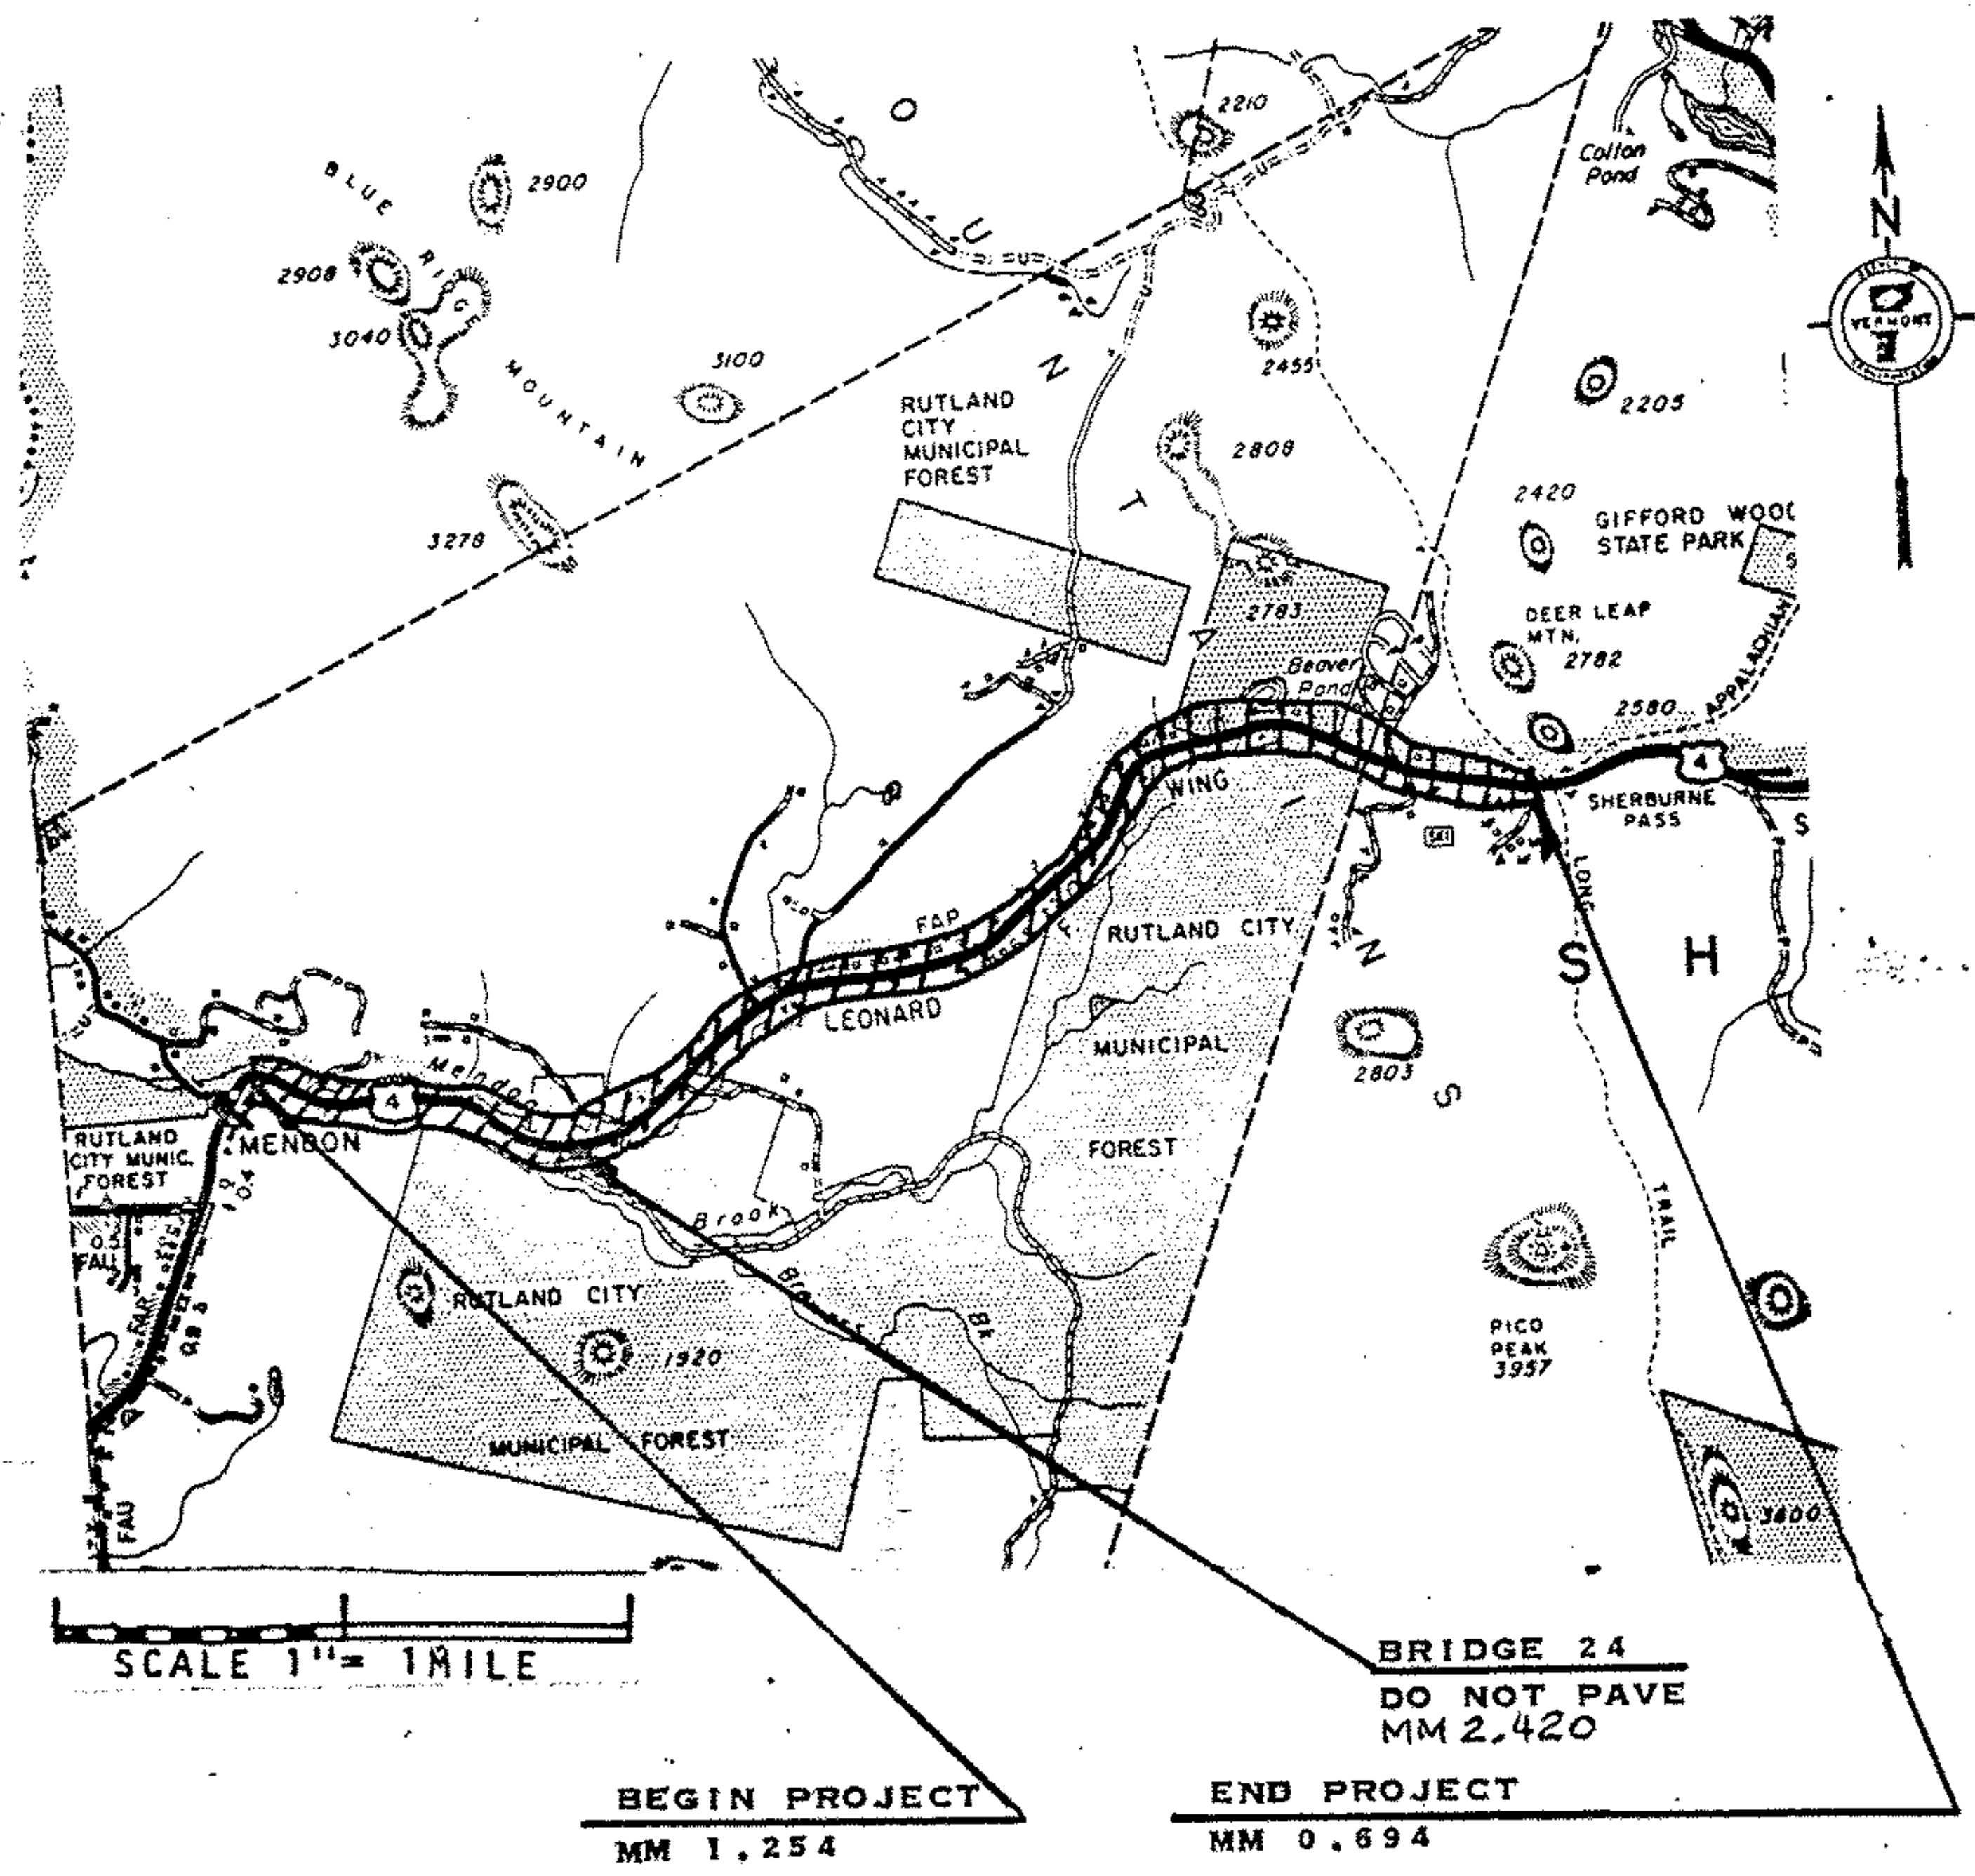

US 4 - BEGINNING IN THE TOWN OF MENDON AT MM 1.254 AND EXTENDING EASTERLY 5.367 MILES TO MM 0.694 IN THE TOWN OF SHERBURNE

LENGTH OF PROJECT  
5.367 MILES  
28338 FEET

PROJECT MENDON-SHERBURNE

NO. F 020-2(22)  
SHEET 3 OF 12 SHEETS