


# TYPICAL SECTIONS & DESIGN DATA

ITEM 406.25 BITUMINOUS CONCRETE PAVEMENT  
 LEVELING COURSE, TYPE III OR IV  
 AS DIRECTED BY THE ENGINEER  
 1 1/2" WEARING COURSE, TYPE III

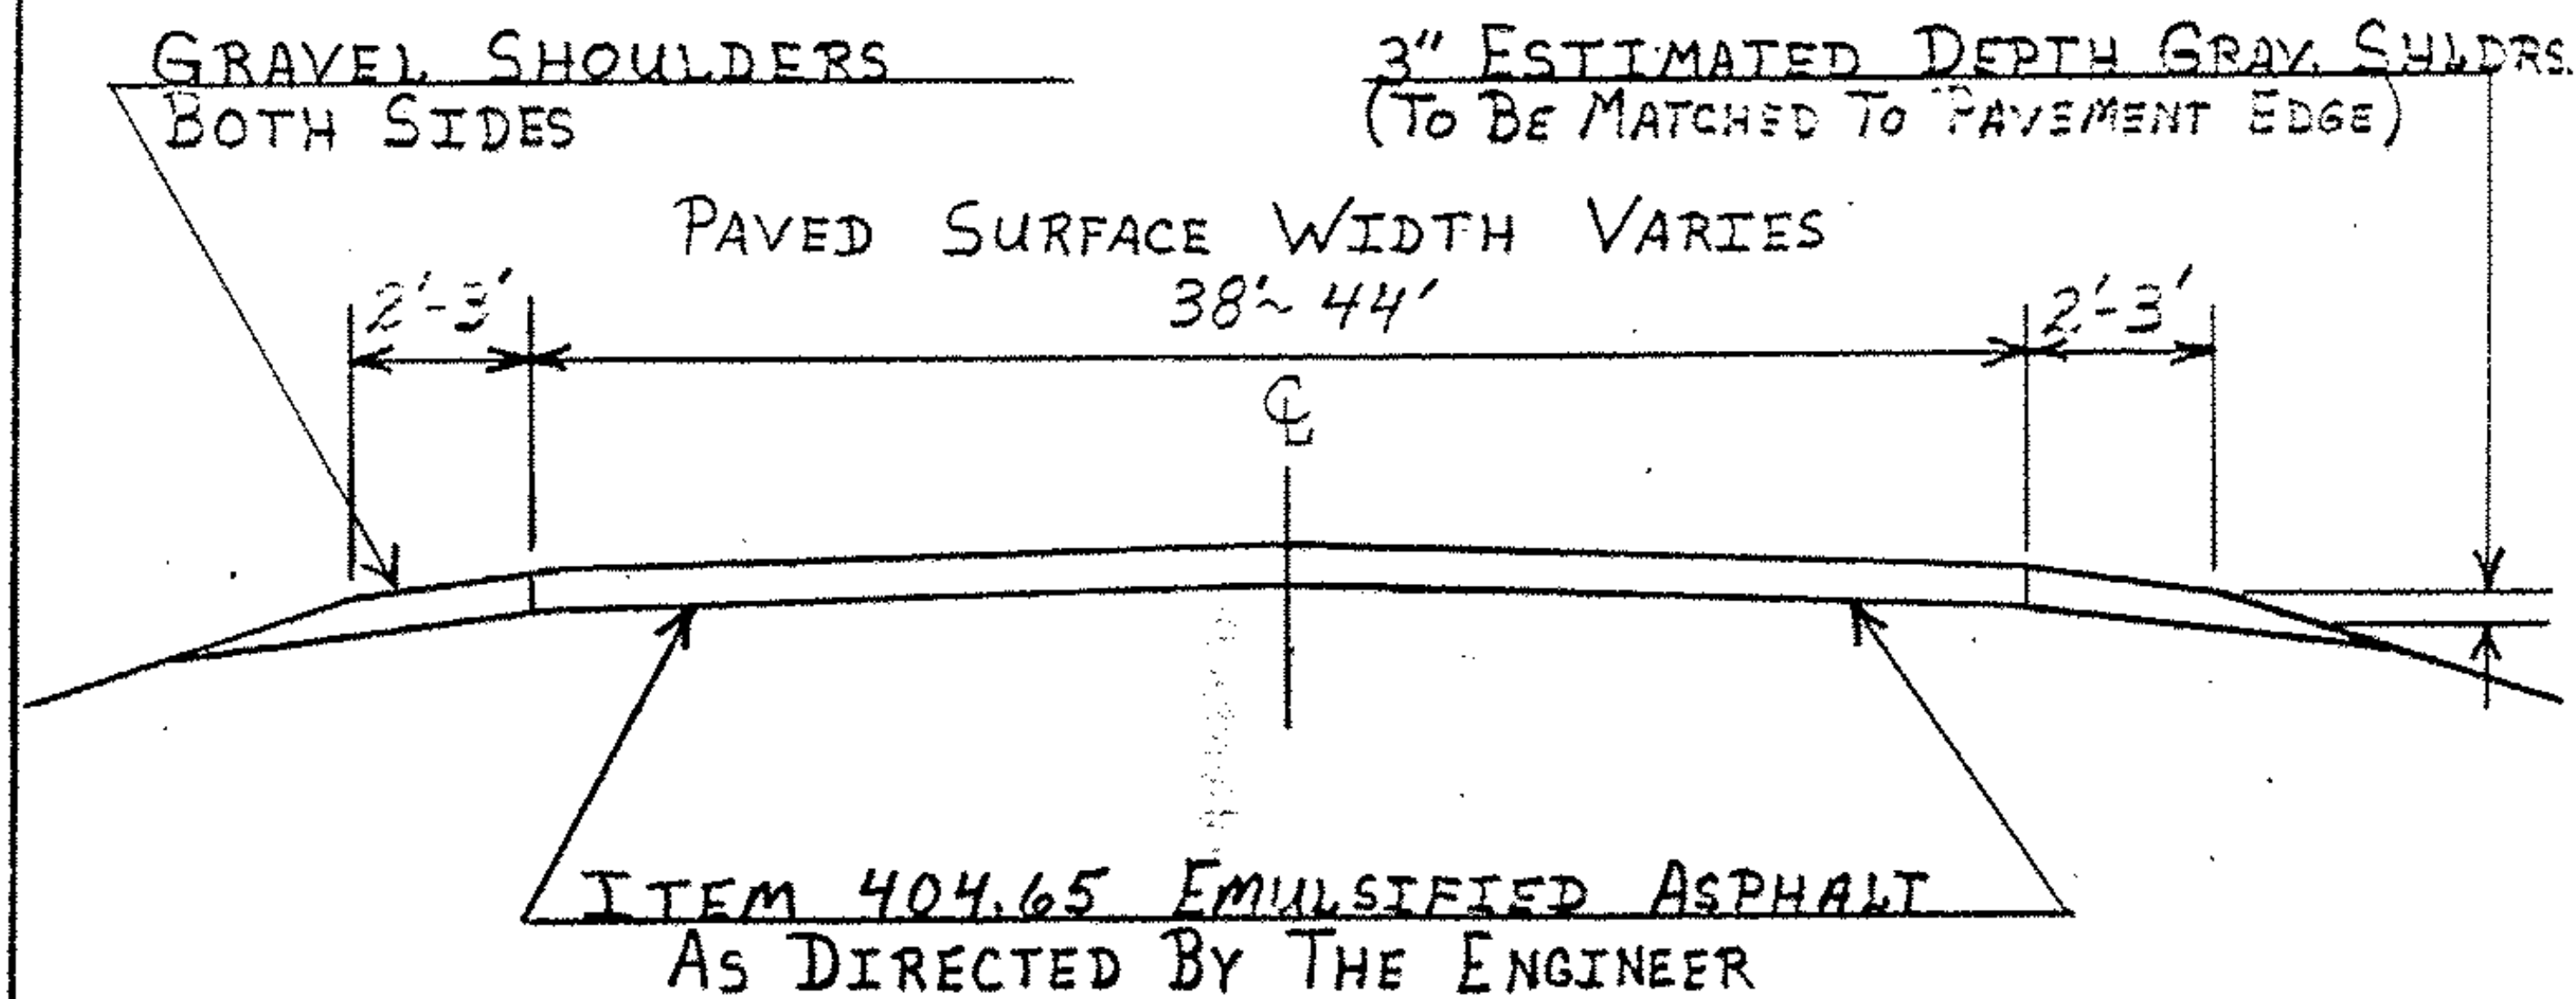

LOCATION	WIDTH GRAVEL SHOULDER	WIDTH TRAVELED WAY	WIDTH GRAVEL SHOULDER	LEVEL TONNAGE / MT.
MM 1.70~2.47	2'	38'	2'	518
MM 2.47~3.47	2'	44'	2'	600
MM 3.47~5.93	2'	42'	2'	573
MM 0.00~0.694	3'	40'	3'	545

MENDON MM 1.70~5.93  
 SHERBURNE MM 0.00~0.694

PROJECT MENDON-SHERBURNE

NO. F 020-2(22)

SHEET 4A OF 12 SHEETS