


* Centerline treatment shall consist of a minimum of 400 feet of solid line in advance of the intersection and shall be paired with either a solid or dashed line depending on sight distance availability in the opposing lane.

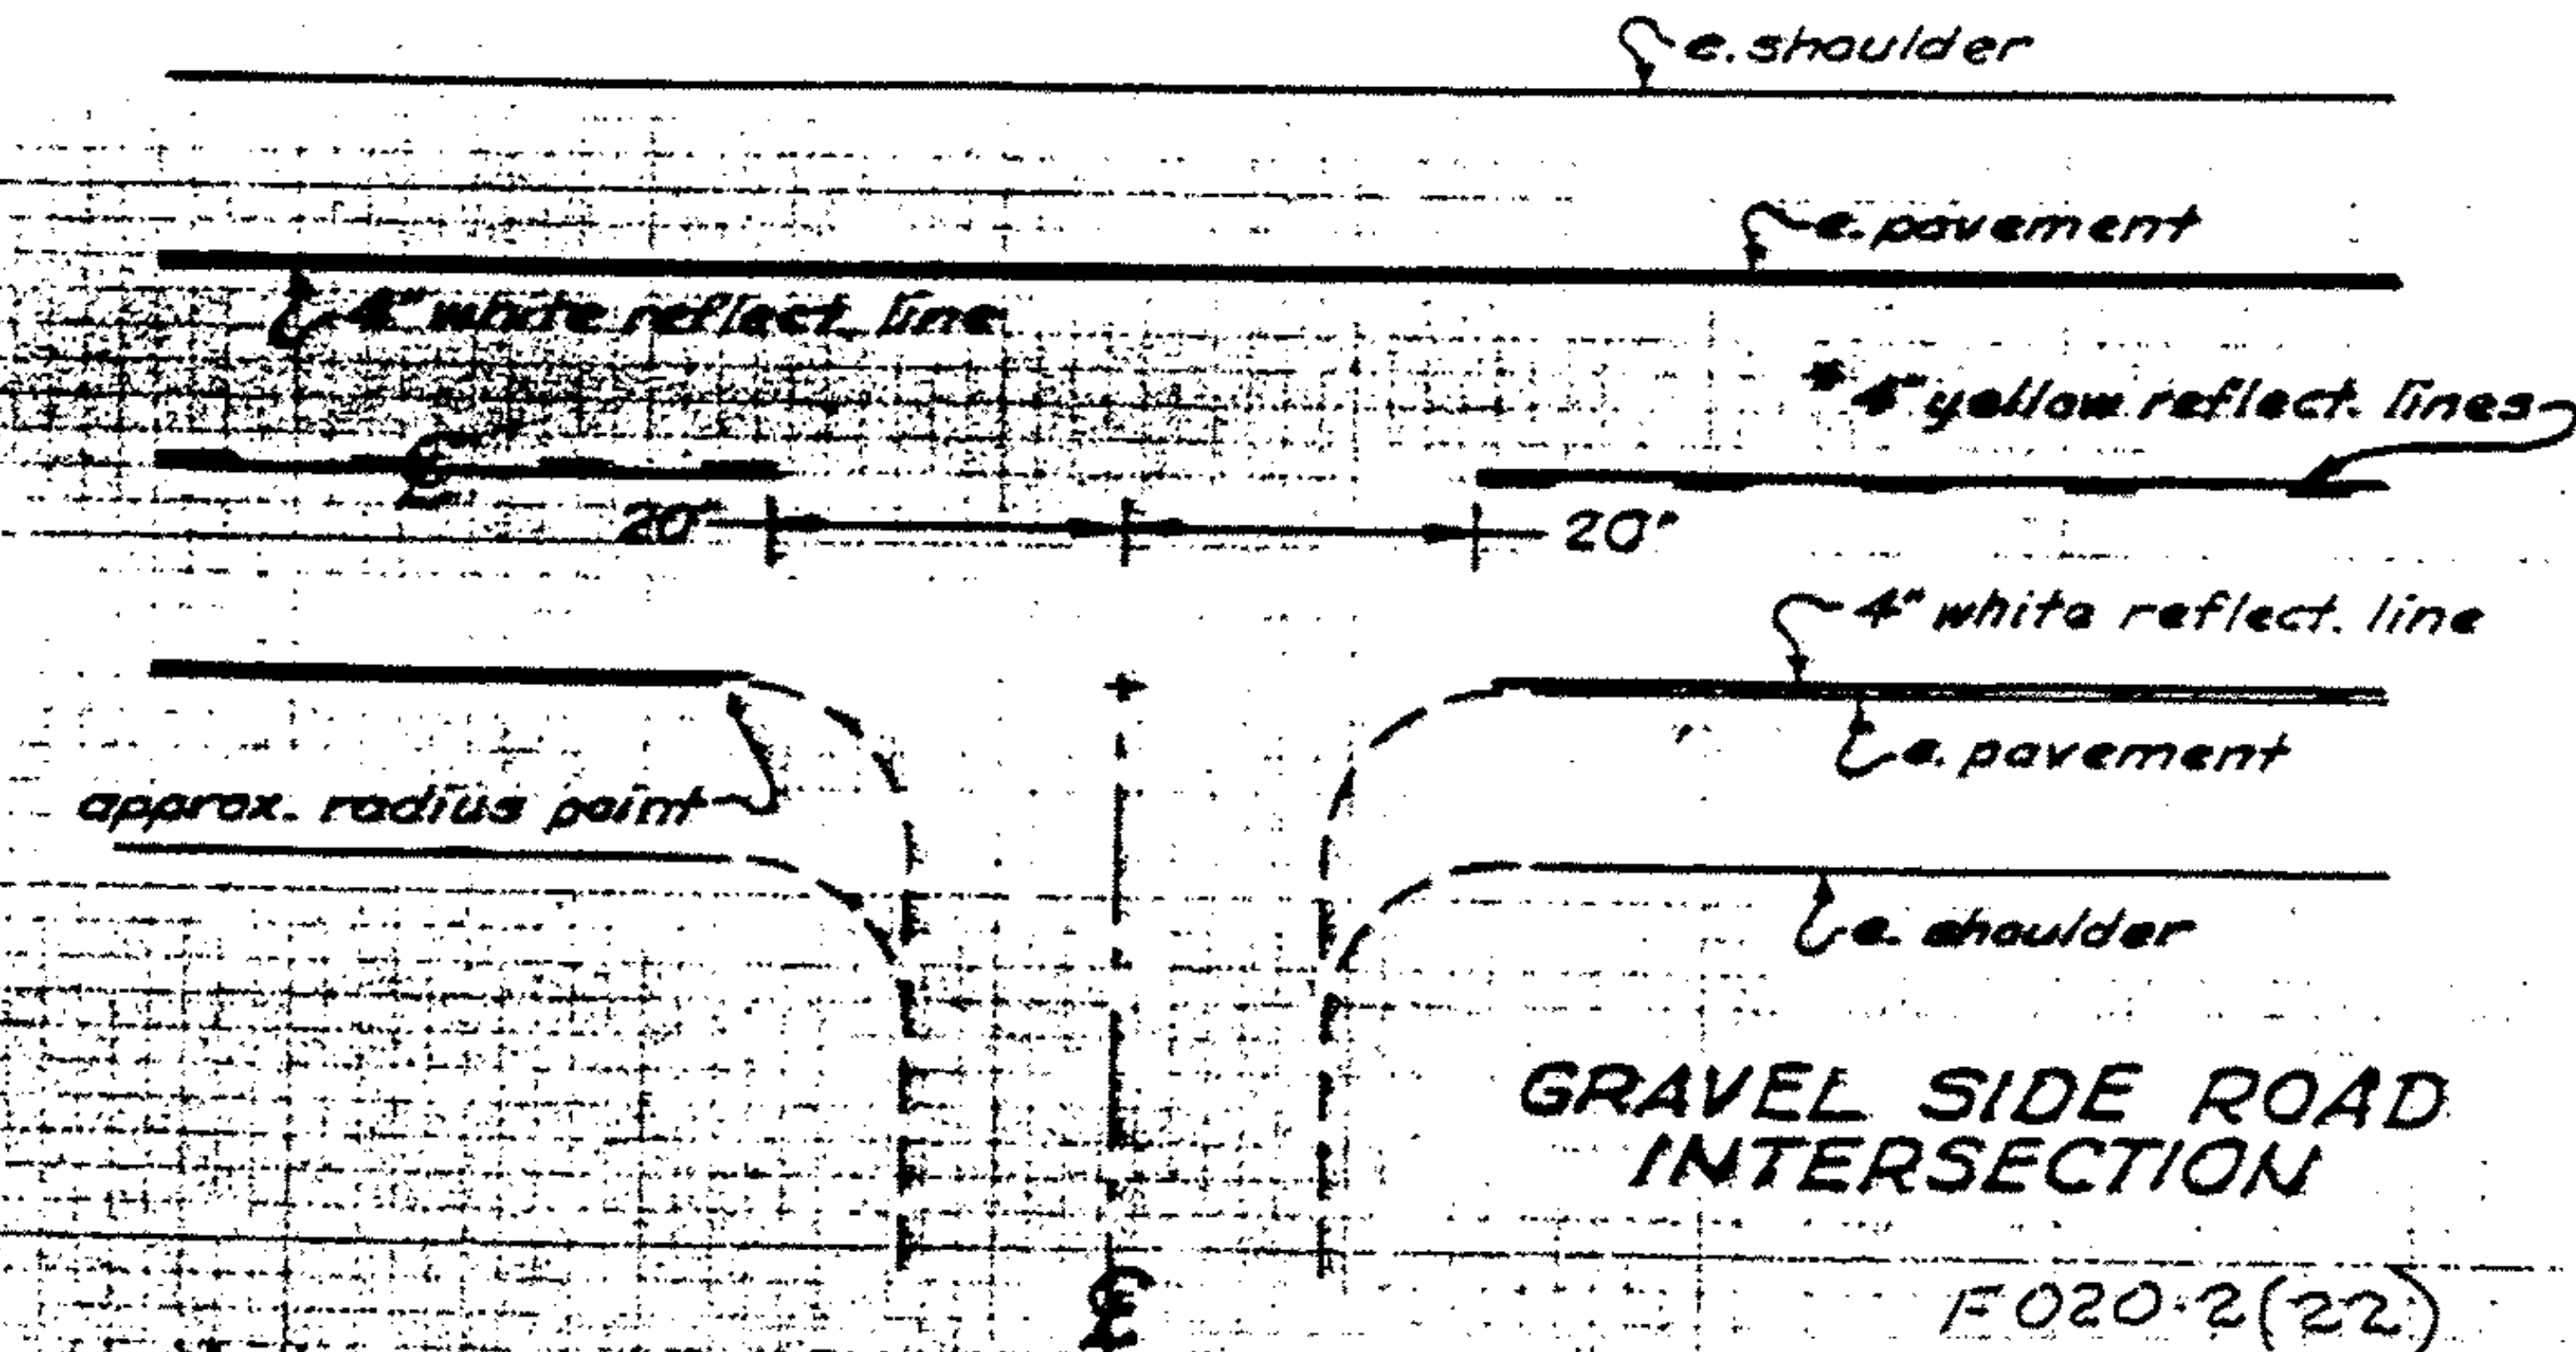

F020-2(22)

Mendon-Sherburne

Sheet 9 Of 12