


# PROJECT DESCRIPTION AND LOCATION

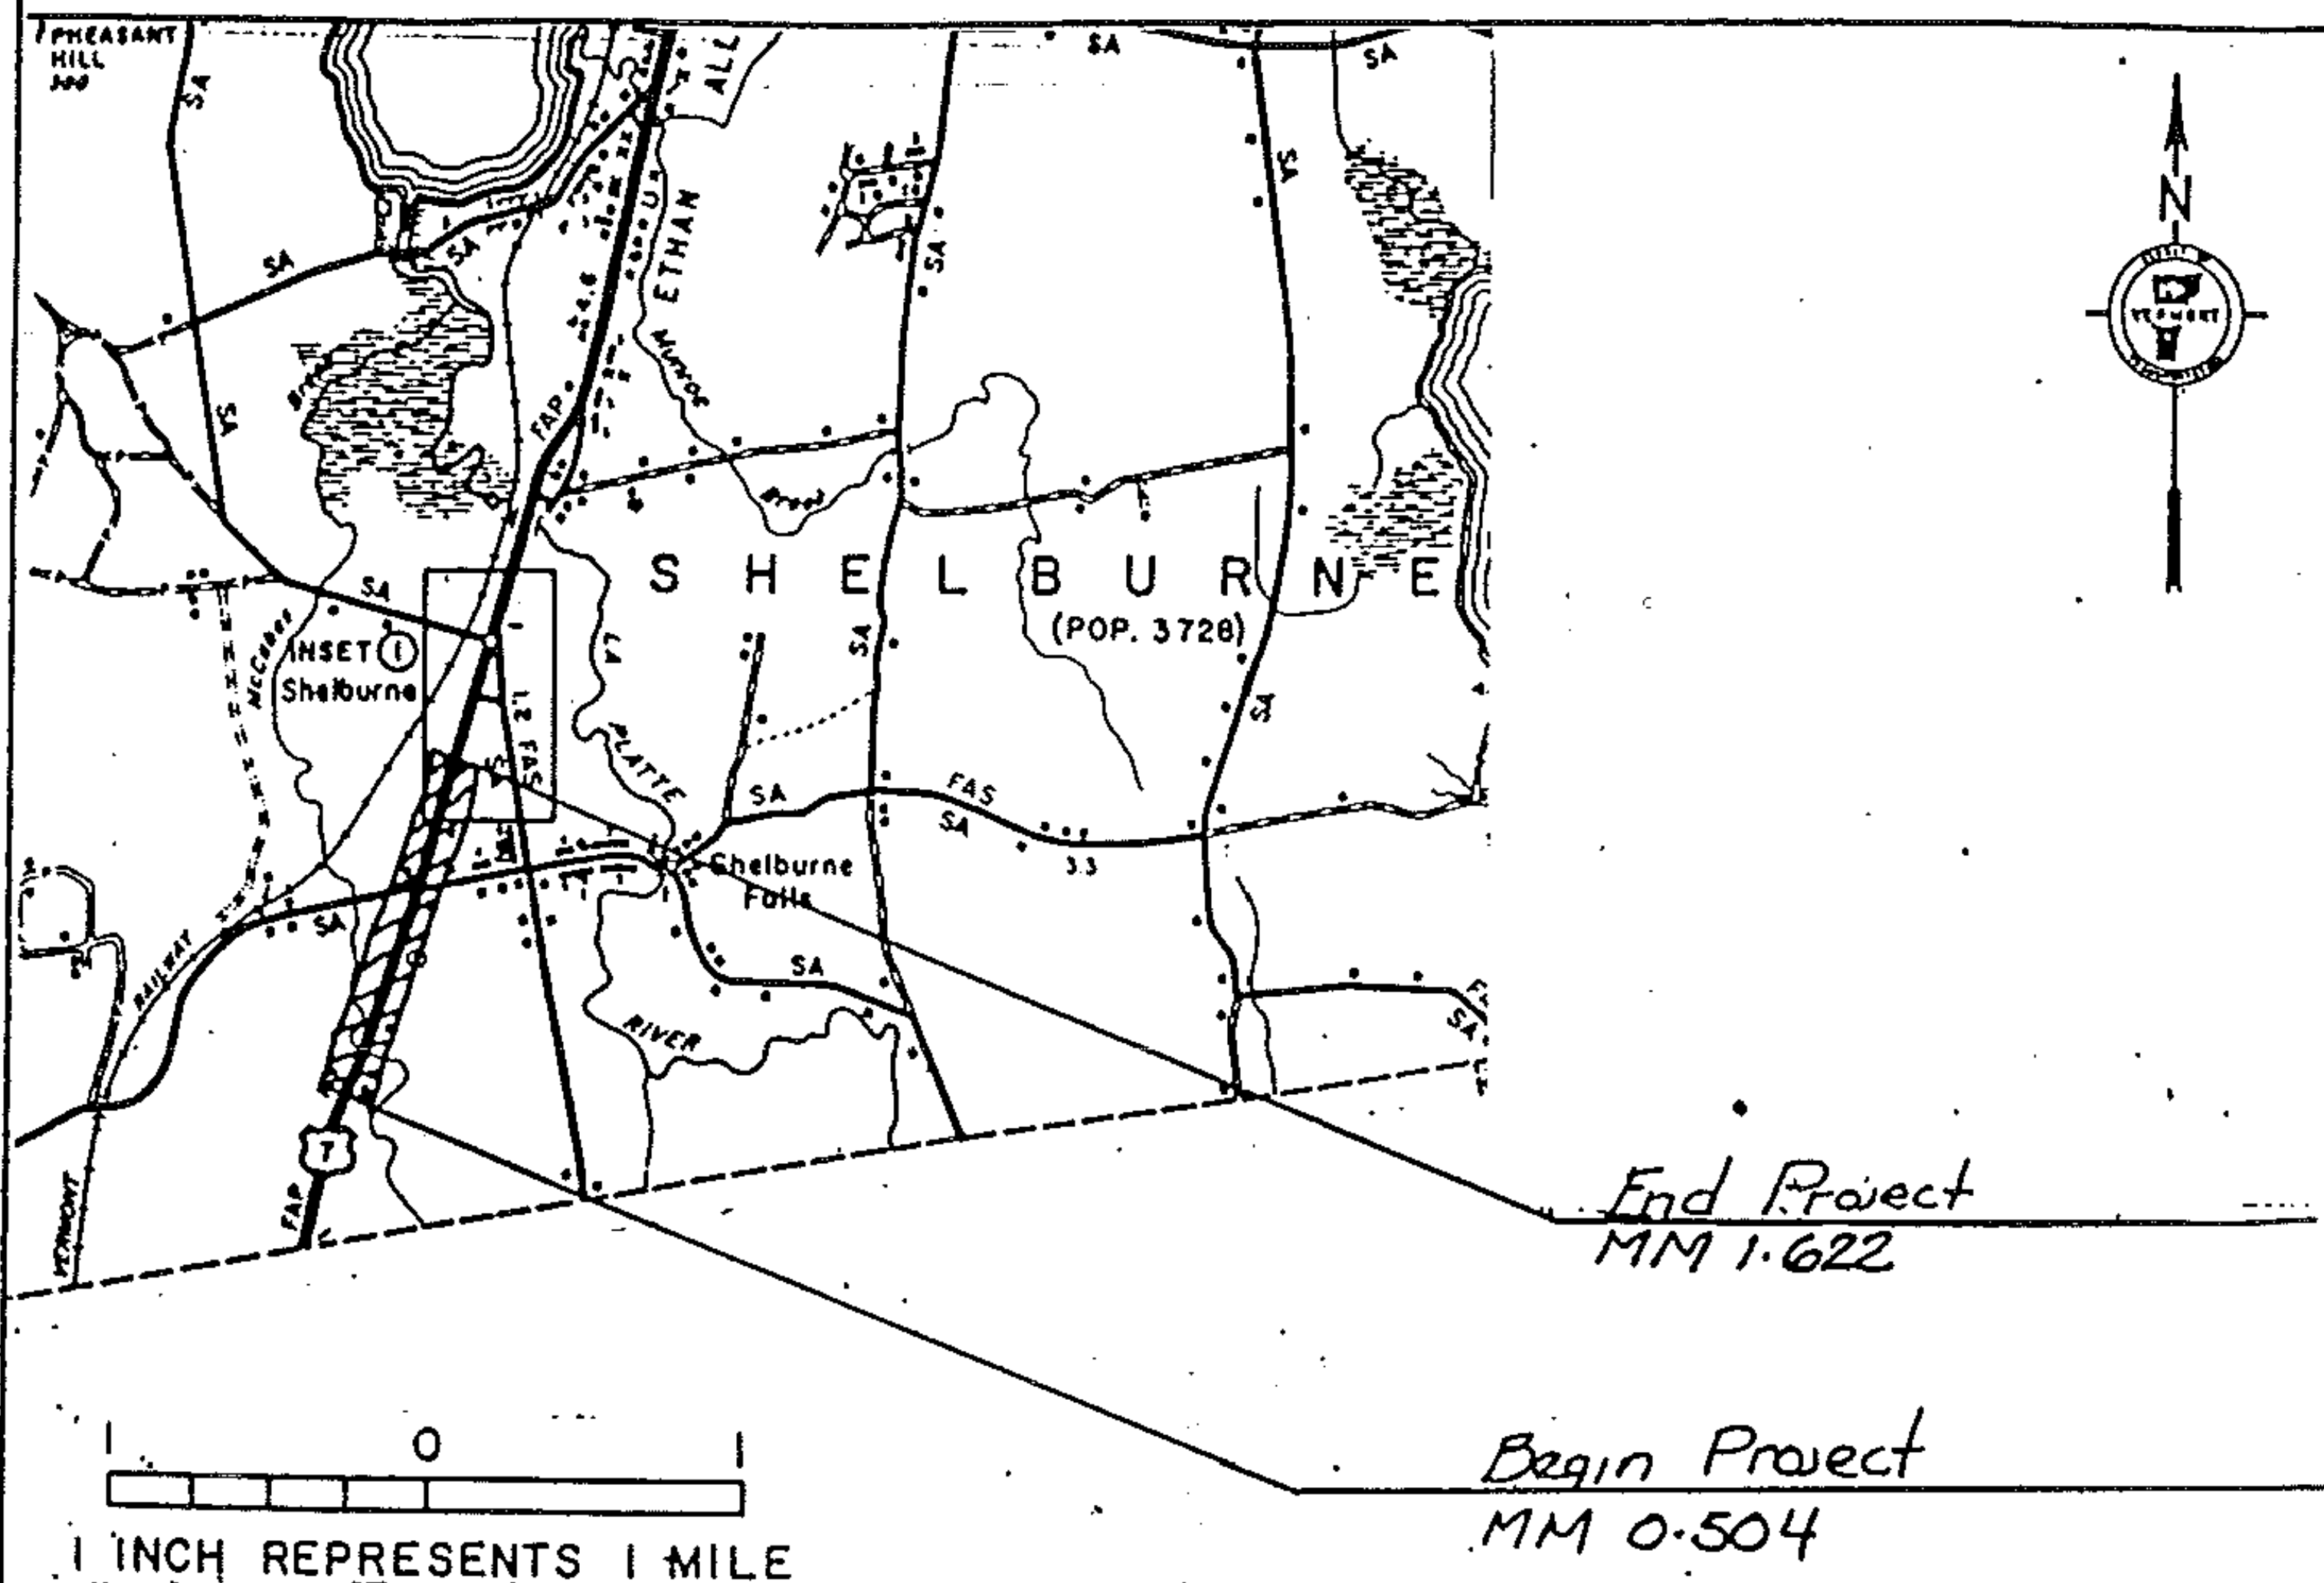

In Shelburne, beginning at a point on US Route 7 at MM 0.504, and extending northerly for 1.118 miles to MM 1.622