


TYPICAL SECTIONS & DESIGN DATA


ITEM 406.25 BITUMINOUS CONCRETE PAVEMENT
 LEVELING COURSE, TYPE III OR IV (164 TONS/LANE)
 AS DIRECTED BY THE ENGINEER
 1 1/2" WEARING COURSE ($\pm 1/4$ ") TYPE III, 12' WIDE/LANE

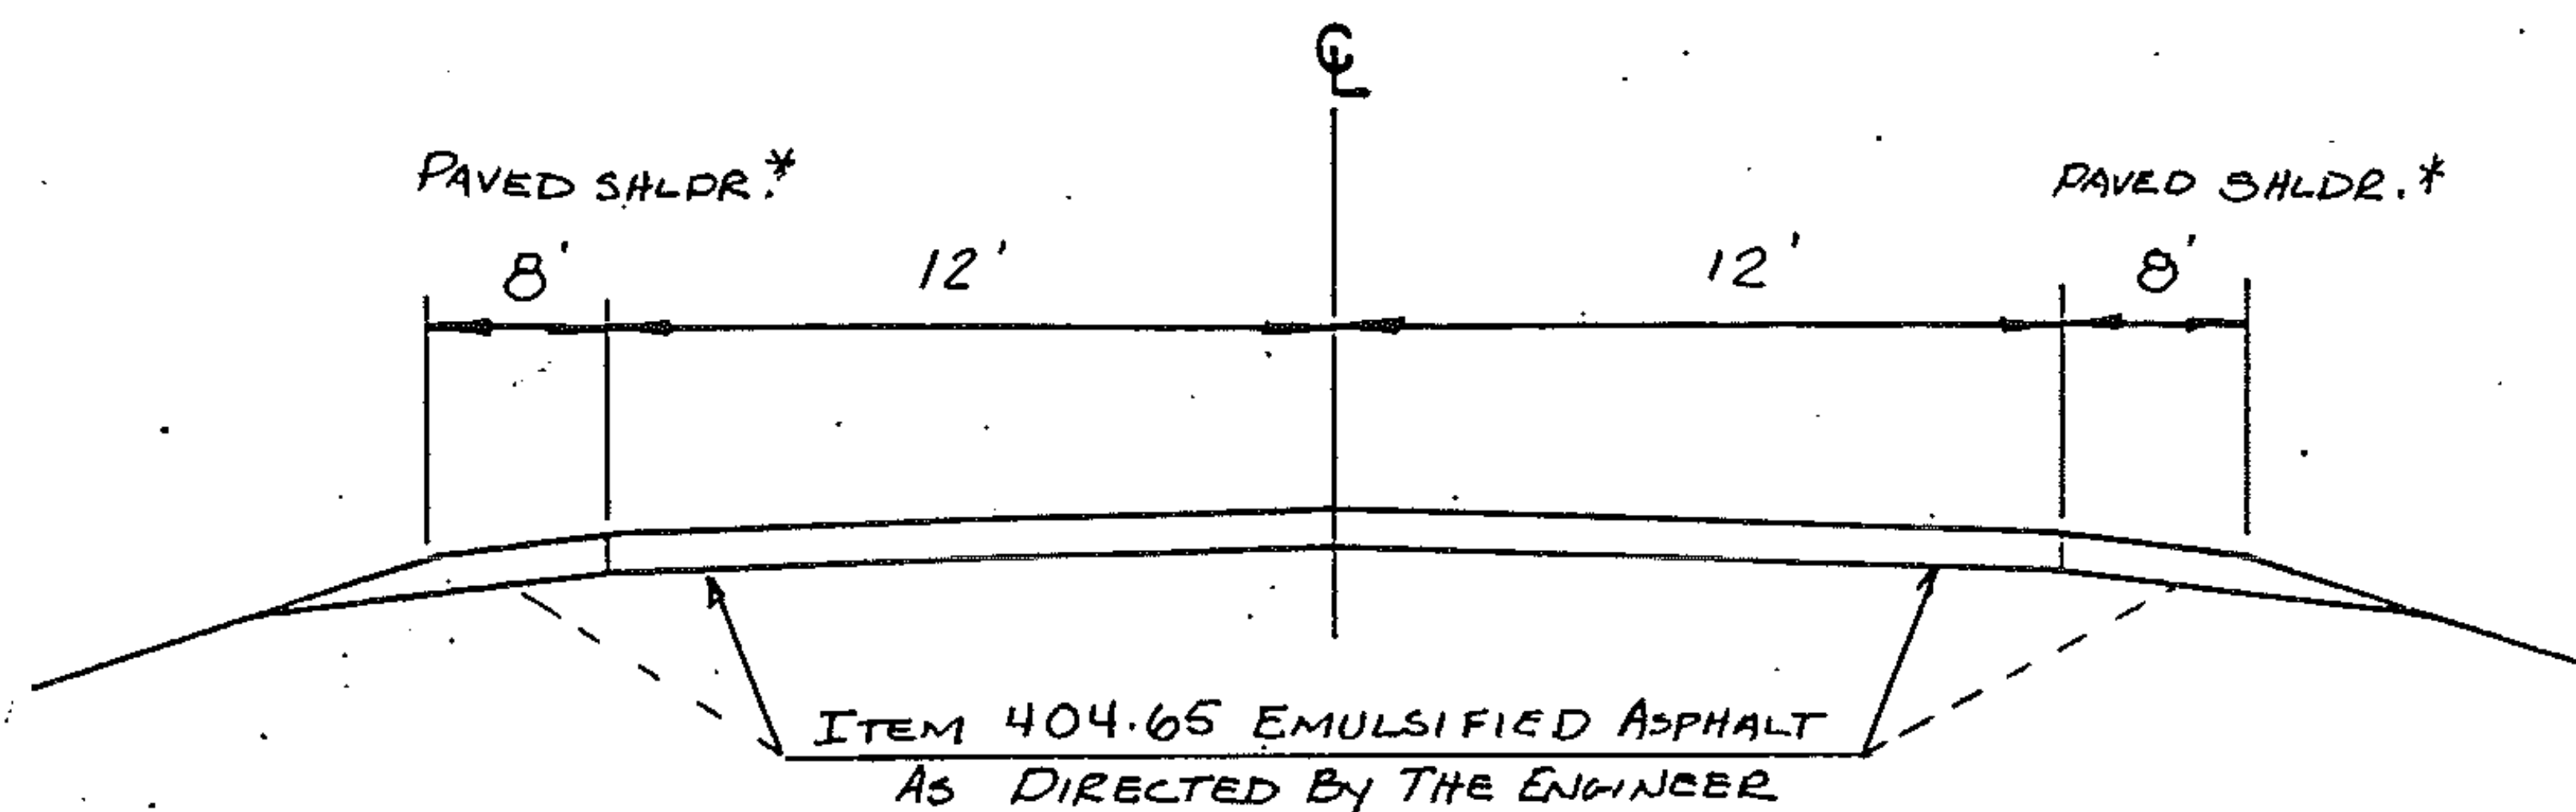

MM 0.504 - MM 0.900

MM 1.540 - MM 1.622

* PAVED SHLDR WILL
 BE TAPERED FROM FULL
 DEPTH TO 1/2"

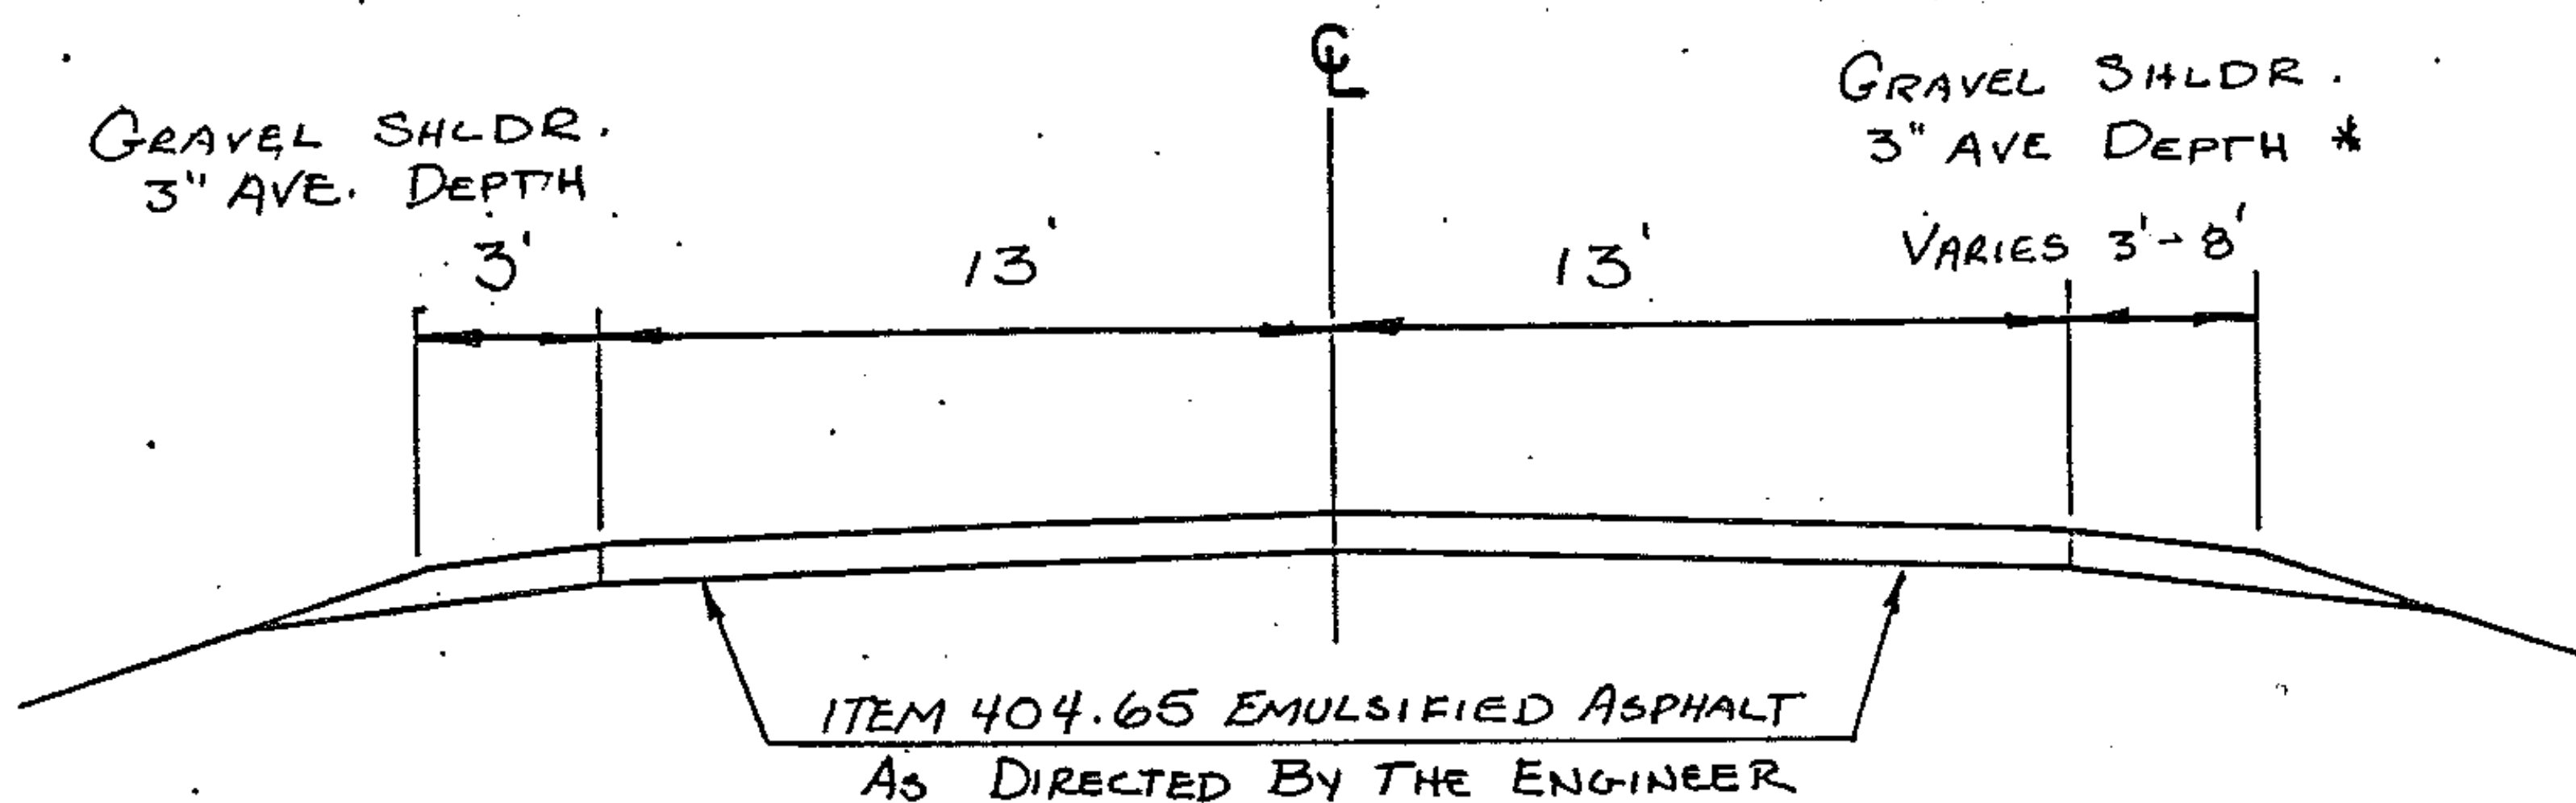

ITEM 406.25 BITUMINOUS CONCRETE
 LEVELING COURSE, TYPE III OR IV (177 TONS/MILE)
 AS DIRECTED BY THE ENGINEER

1 1/2" WEARING COURSE ($\pm 1/4$ ") TYPE III, 13' WIDE EA. LANE.

* GRAVEL SHOULDERS TO BE
 MATCHED TO PAVEMENT EDGE.

1982 ADT = 9200 MM 0.900 ~ MM 1.540