


PROJECT DESCRIPTION AND LOCATION

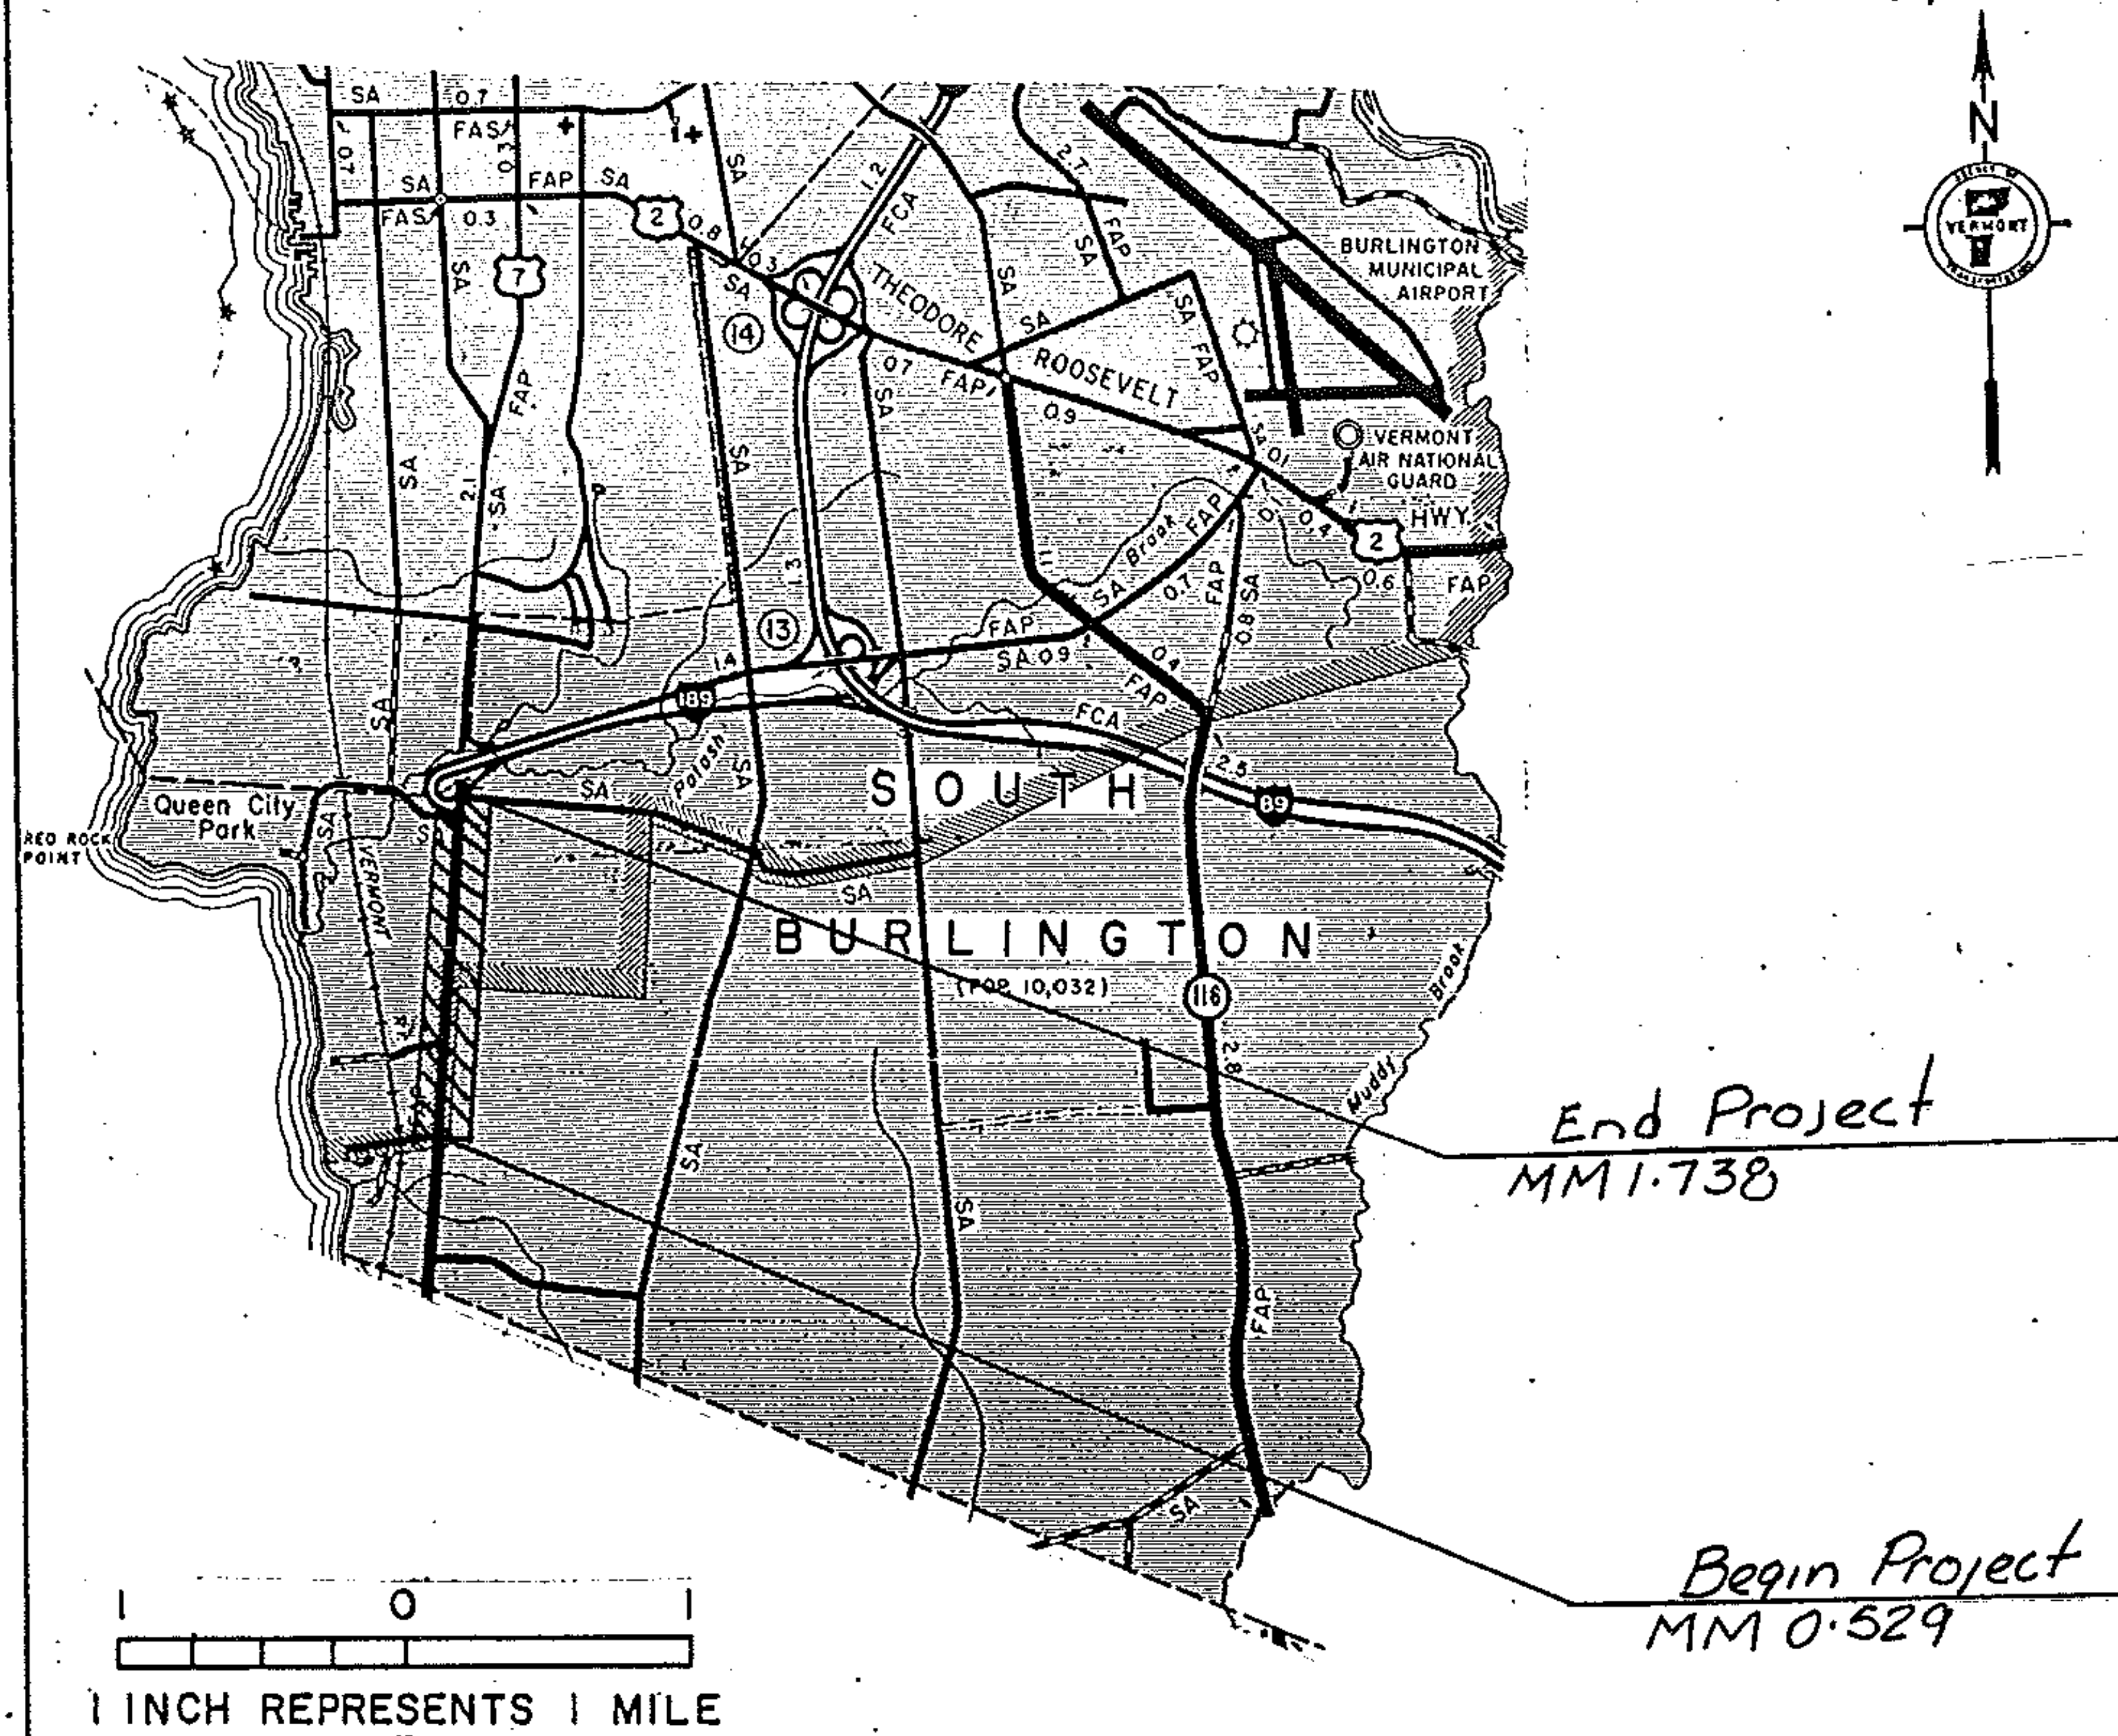

In the city of So. Burlington, beginning at a point on US Route 7 at M.M. 0.529 and extending Northerly to M.M. 1.738.

PROJECT So. BURLINGTON

NO. F019-4(18)S
SHEET 8 OF 29 SHEETS