


TYPICAL SECTIONS & DESIGN DATA

ITEM 406.25 BITUMINOUS CONCRETE PREPARED
LEVELING COURSE, TYPE III OR IV (50' WIDE @ 568 TONS/mi)
AS DIRECTED BY THE ENGINEER
1 1/2" WEARING COURSE, TYPE III

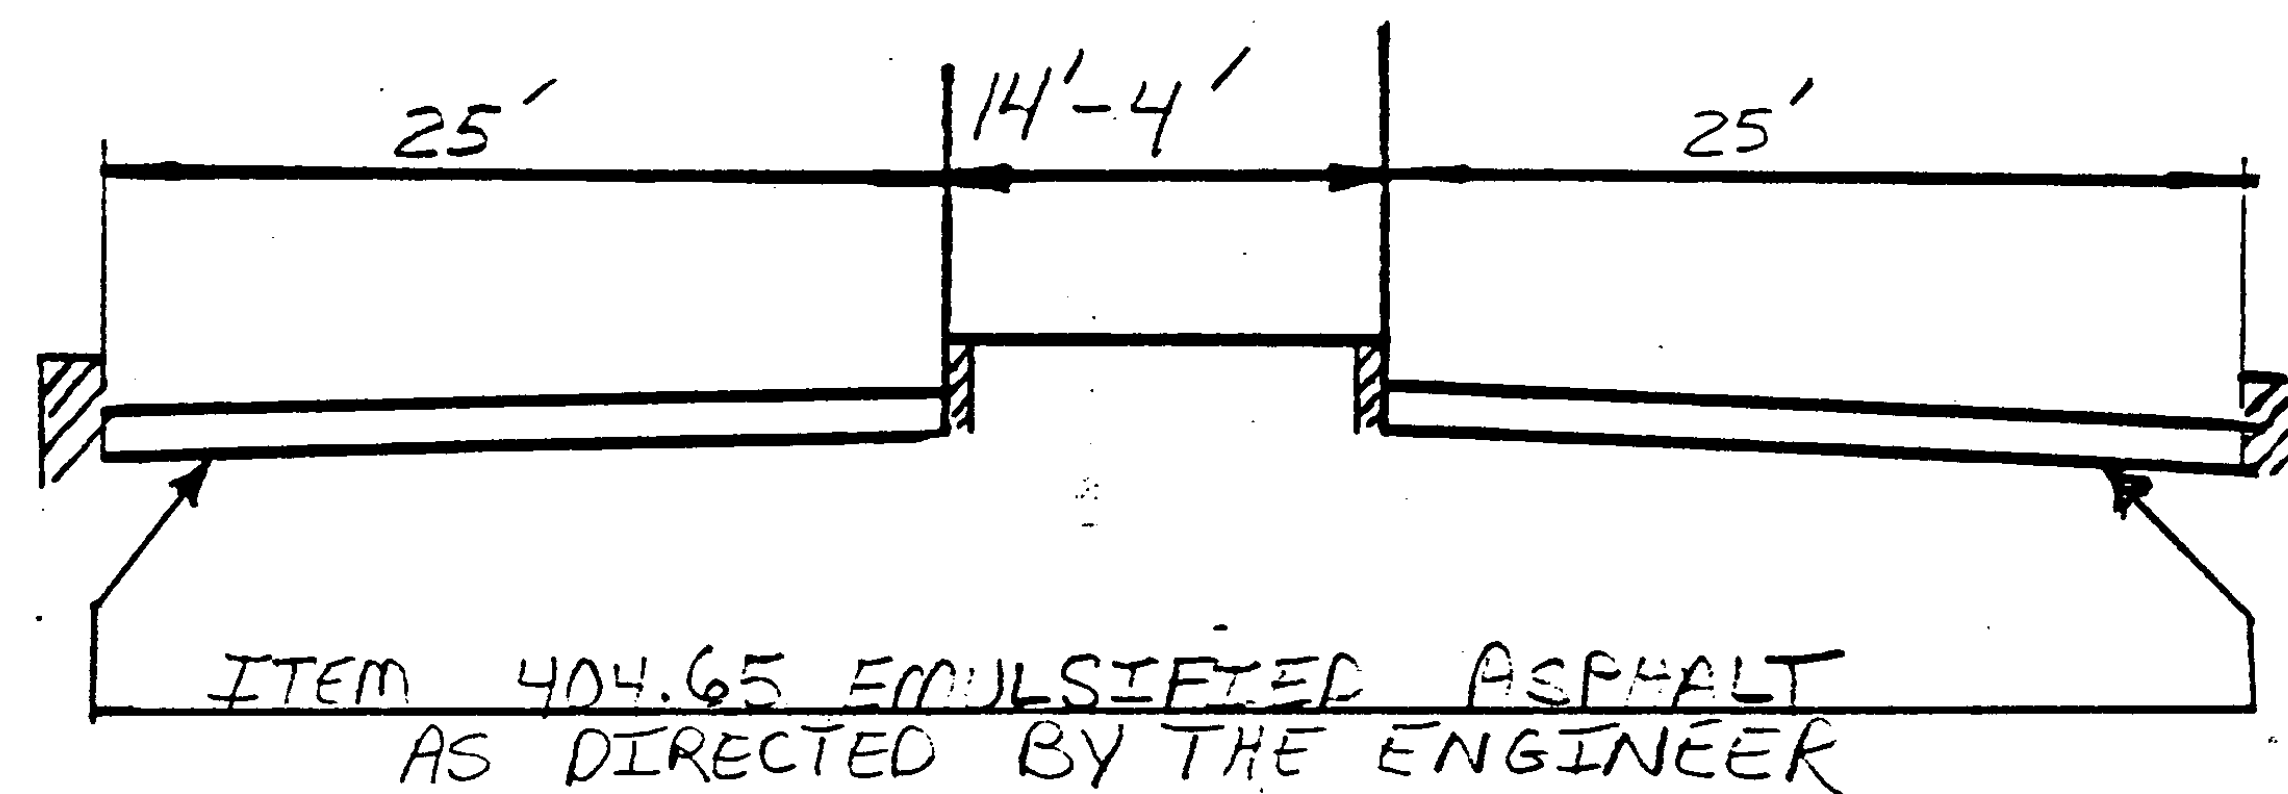

BRATTLEBORO MM 7.055 ~ MM 7.150

PROJECT BRATTLEBORO

NO. F 010-2(1) S

SHEET 16 OF 23 SHEETS