


TYPICAL SECTIONS & DESIGN DATA

ITEM 406.25 BITUMINOUS CONCRETE PREPARED
LEVELING COURSE, TYPE III OR IV (17' WIDE @ 193 TONS/mi)
AS DIRECTED BY THE ENGINEER
1 1/2" WEARING COURSE, TYPE III

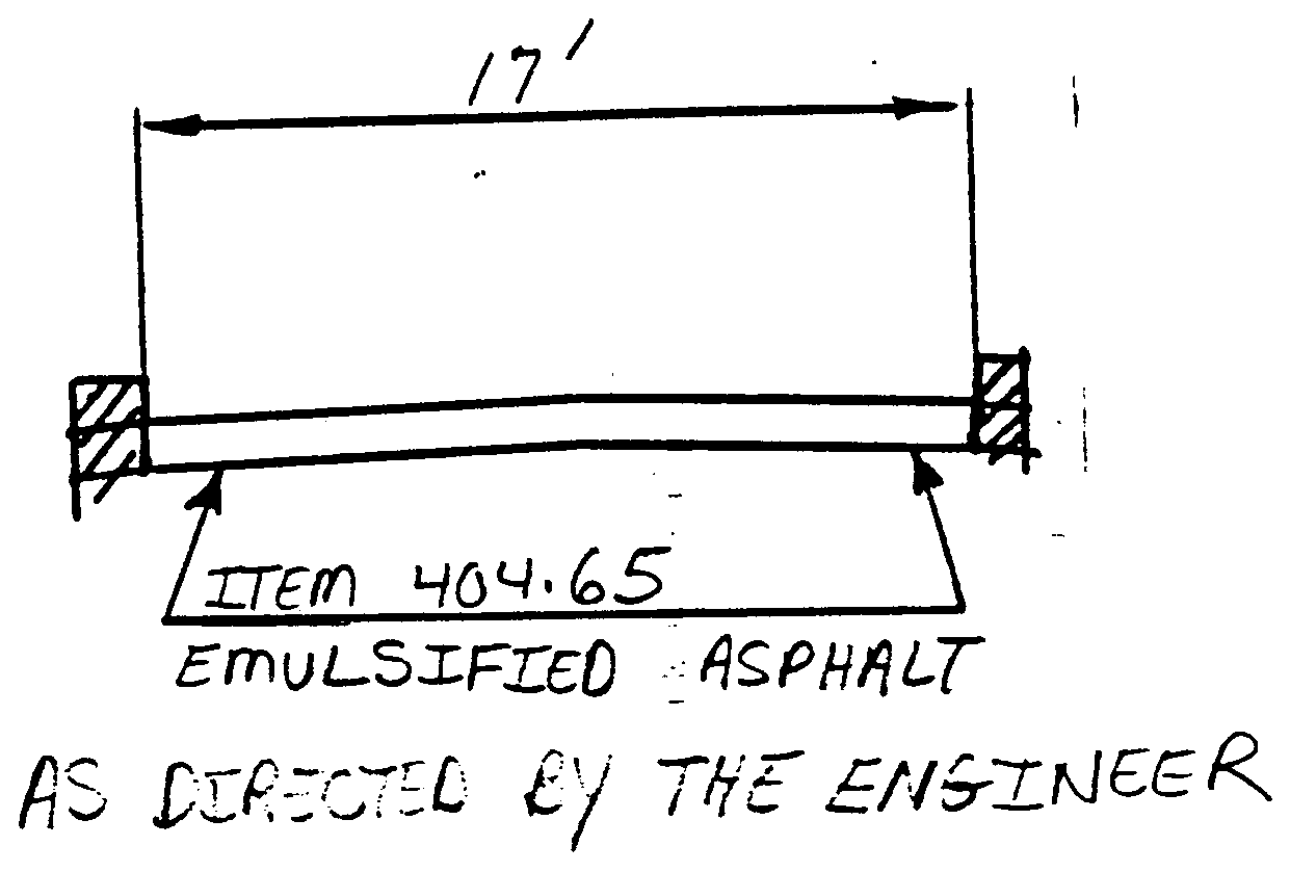

BRATTLEBORO TWO RAMP ON AND OFF FOR V.9

PROJECT BRATTLEBORO

NO. F010-2(1)S
SHEET 17A OF 23 SHEETS