


PAVEMENT TERMINUS

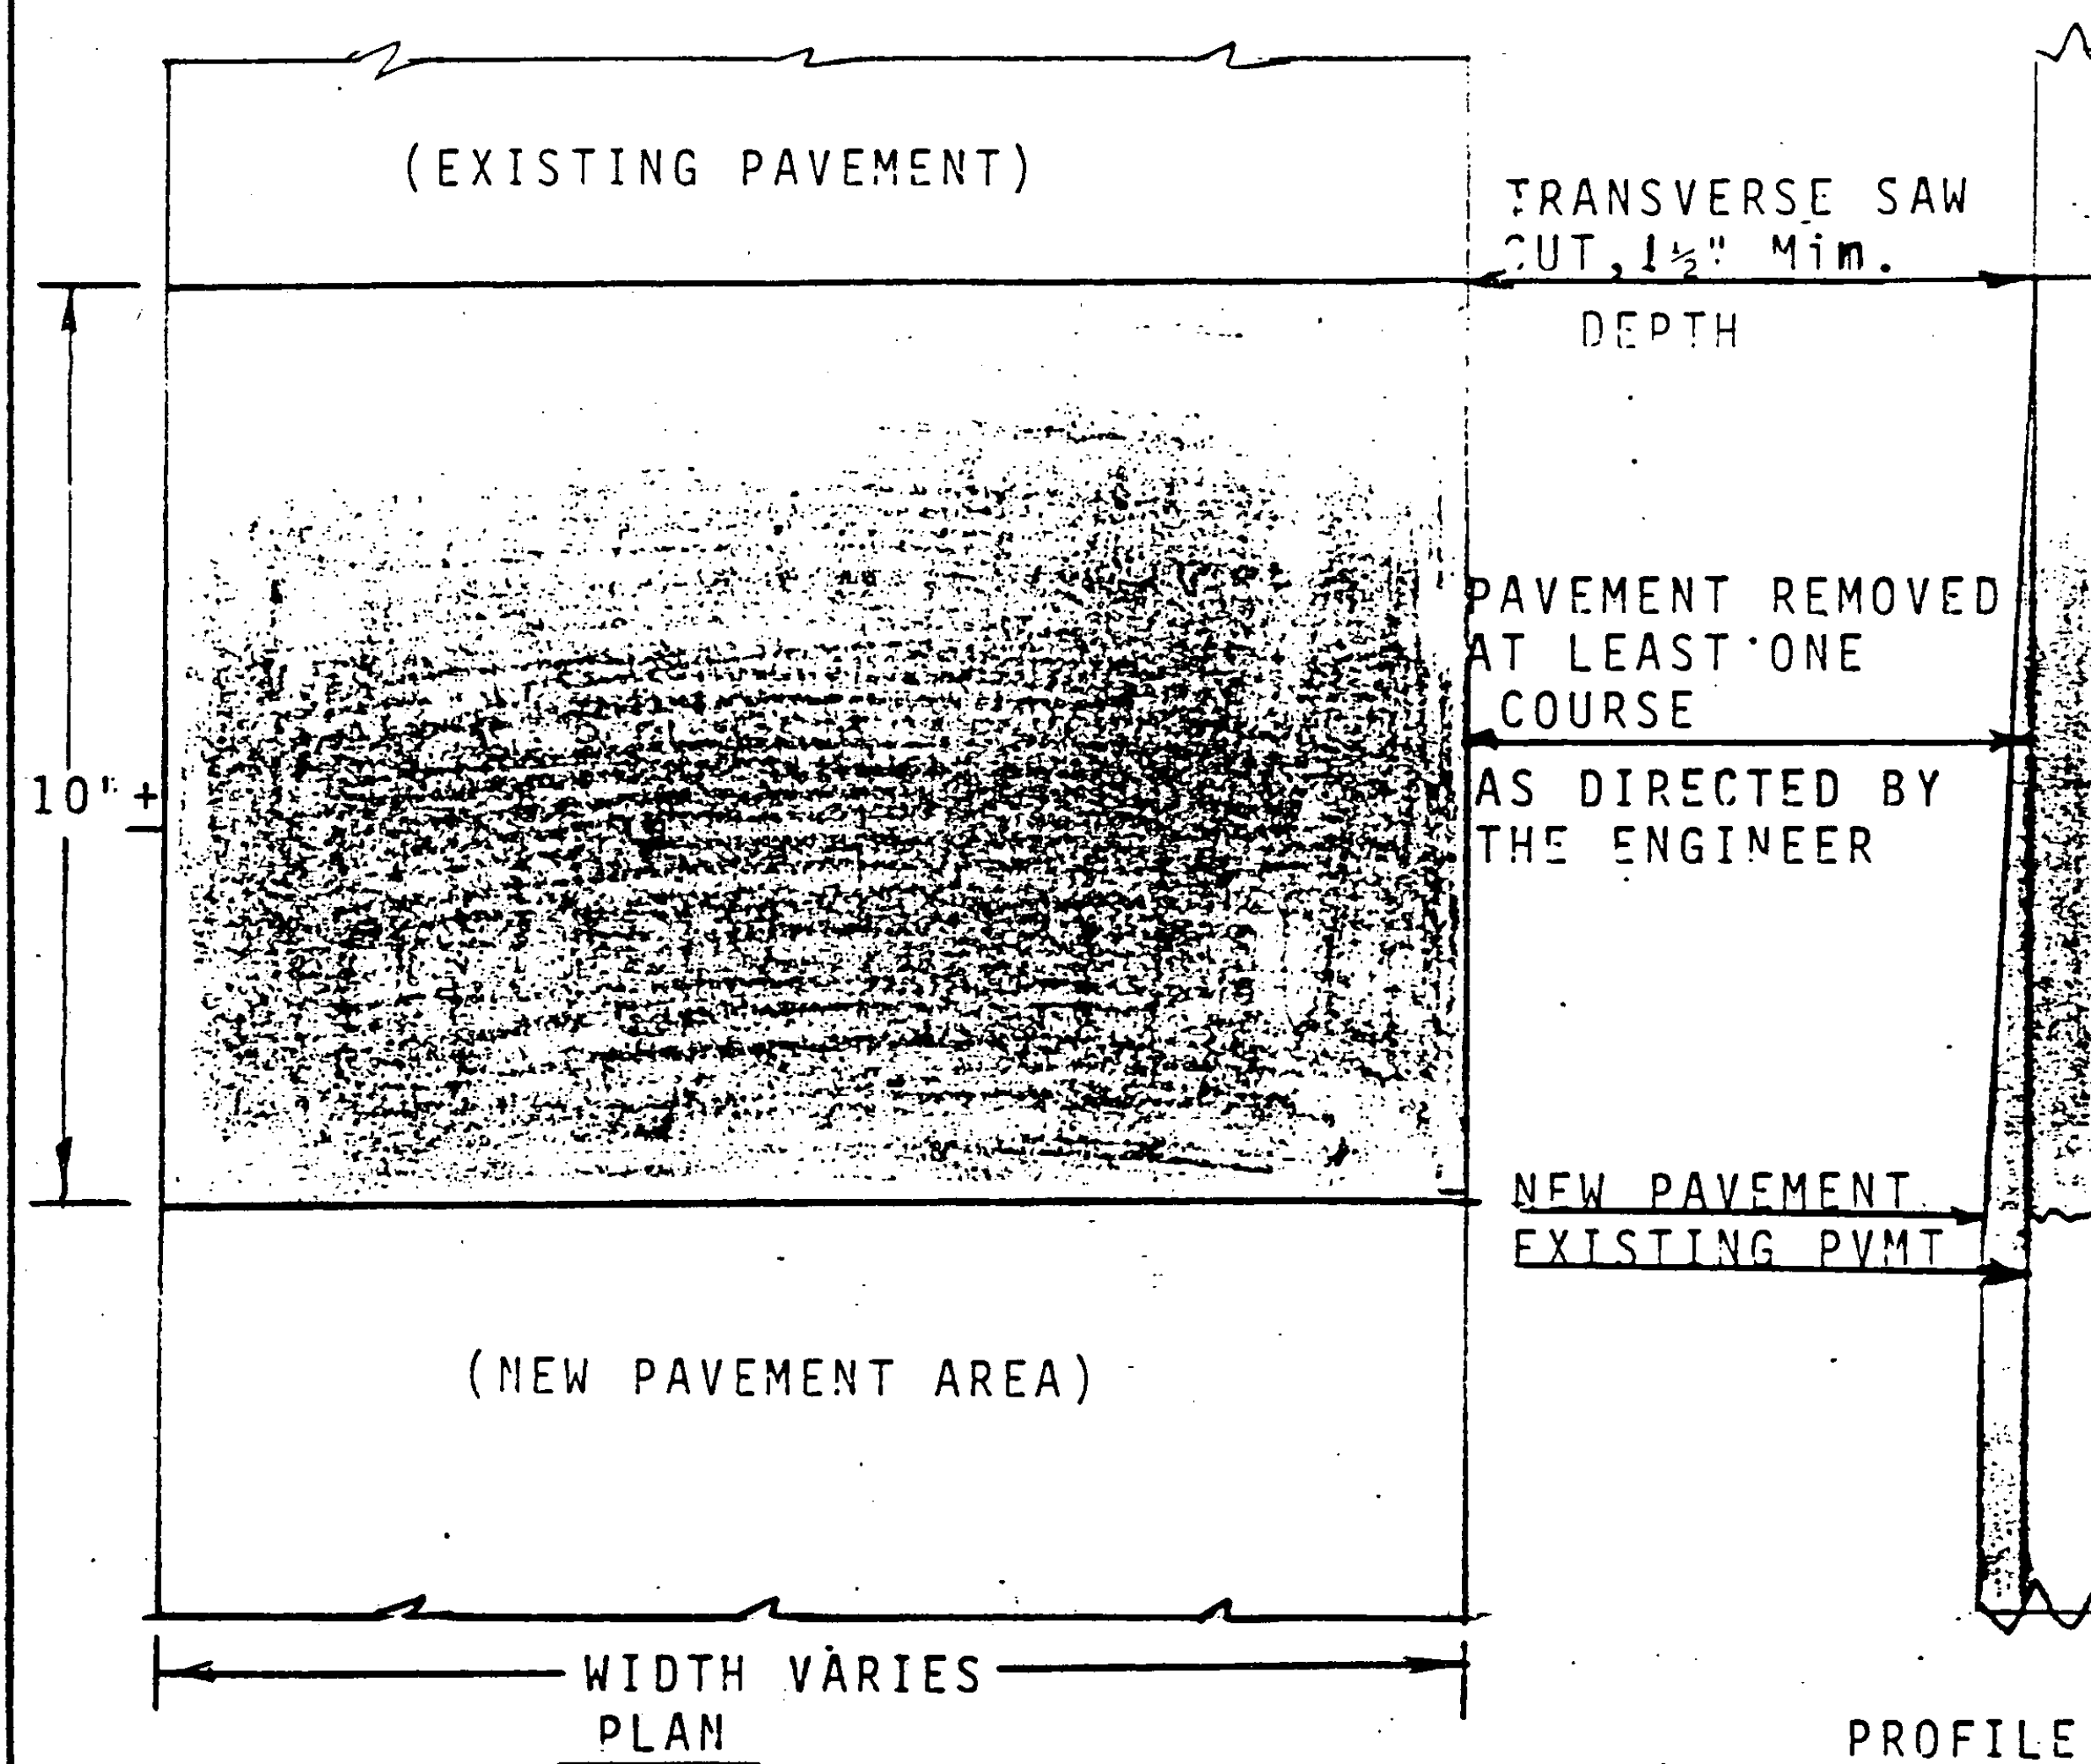

PAVEMENT MAY BE LAID, WITH APPROVAL OF THE ENGINEER, IN ONE COURSE
TERMINUS WILL BE FLUSH WITH EXISTING PAVEMENT AND WILL BE CROSS
ROLLED.

THIS ITEM WILL BE SUBSIDIARY TO ITEM 406.25, BITUMINOUS CONCRETE
PAVEMENT.

NOT TO SCALE

PROJECT CAMBRIDGE-JOHNSON

NO. HMA 26 26, FO 30-2(15)S
HMA 26 27

SHEET 4 OF 31 SHEETS