


PROJECT DESCRIPTION AND LOCATION

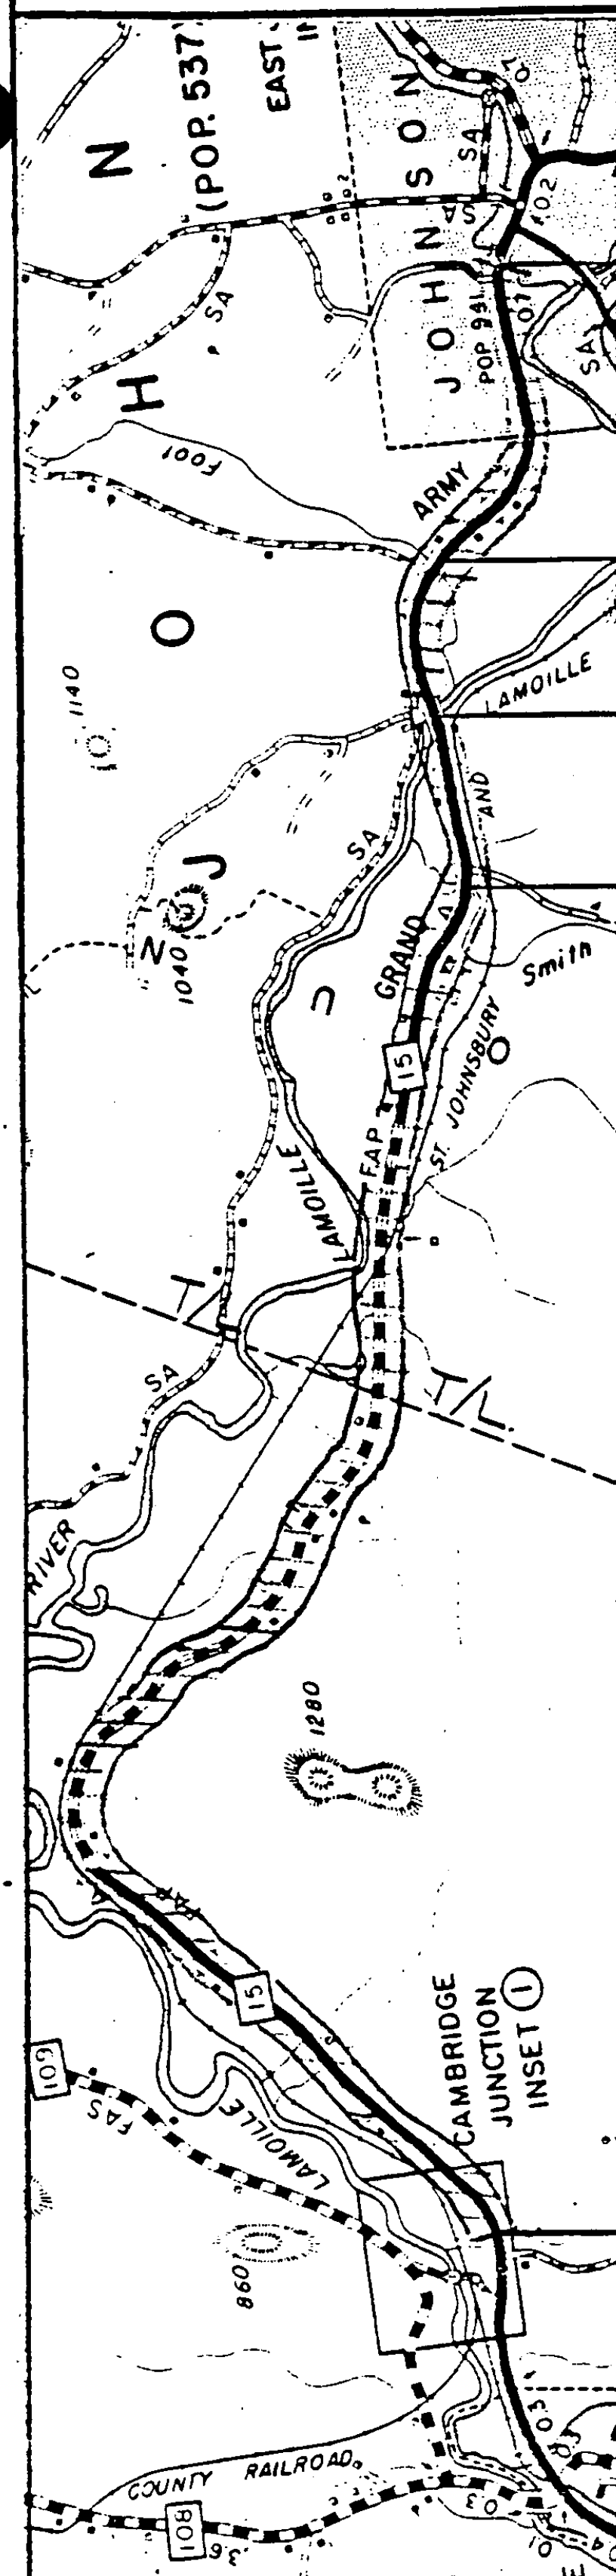

END PROJECT JOHNSON MM 3.927

BRIDGE No. 34 MM 2.773 - Do Not Level
PAVE WITH TOP ONLY (3/4" MAX. DEPTH)

BRIDGE No. 33 MM 2.302
Do Not Pave

BRIDGE No. 32 MM 1.765
Do Not Level - PAVE WITH TOP ONLY (3/4" MAX. DEPTH)

ON VT. RT. 15, BEGINNING 3.791 MILES
WESTERLY OF THE CAMBRIDGE-JOHNSON
TOWN LINE AT CAMBRIDGE MM 6.047,
THEN EASTERLY ON VT. RT. 15, 7.718
MILES TO JOHNSON MM 3.927.

LENGTH OF PROJECT: 7.718 MI.
40751 FT.

TRAFFIC DATA
1982 ADT = 3100
V = 50 MPH

T/L CAMBRIDGE MM 9.838 =
JOHNSON MM 0.000

BEGIN PROJECT
CAMBRIDGE MM 6.047

0 0.5 1 2
SCALE: 1" = 1 MILE

PROJECT CAMBRIDGE-JOHNSON

NO. HMA 2626

SHEET 7 OF 31 SHEETS