
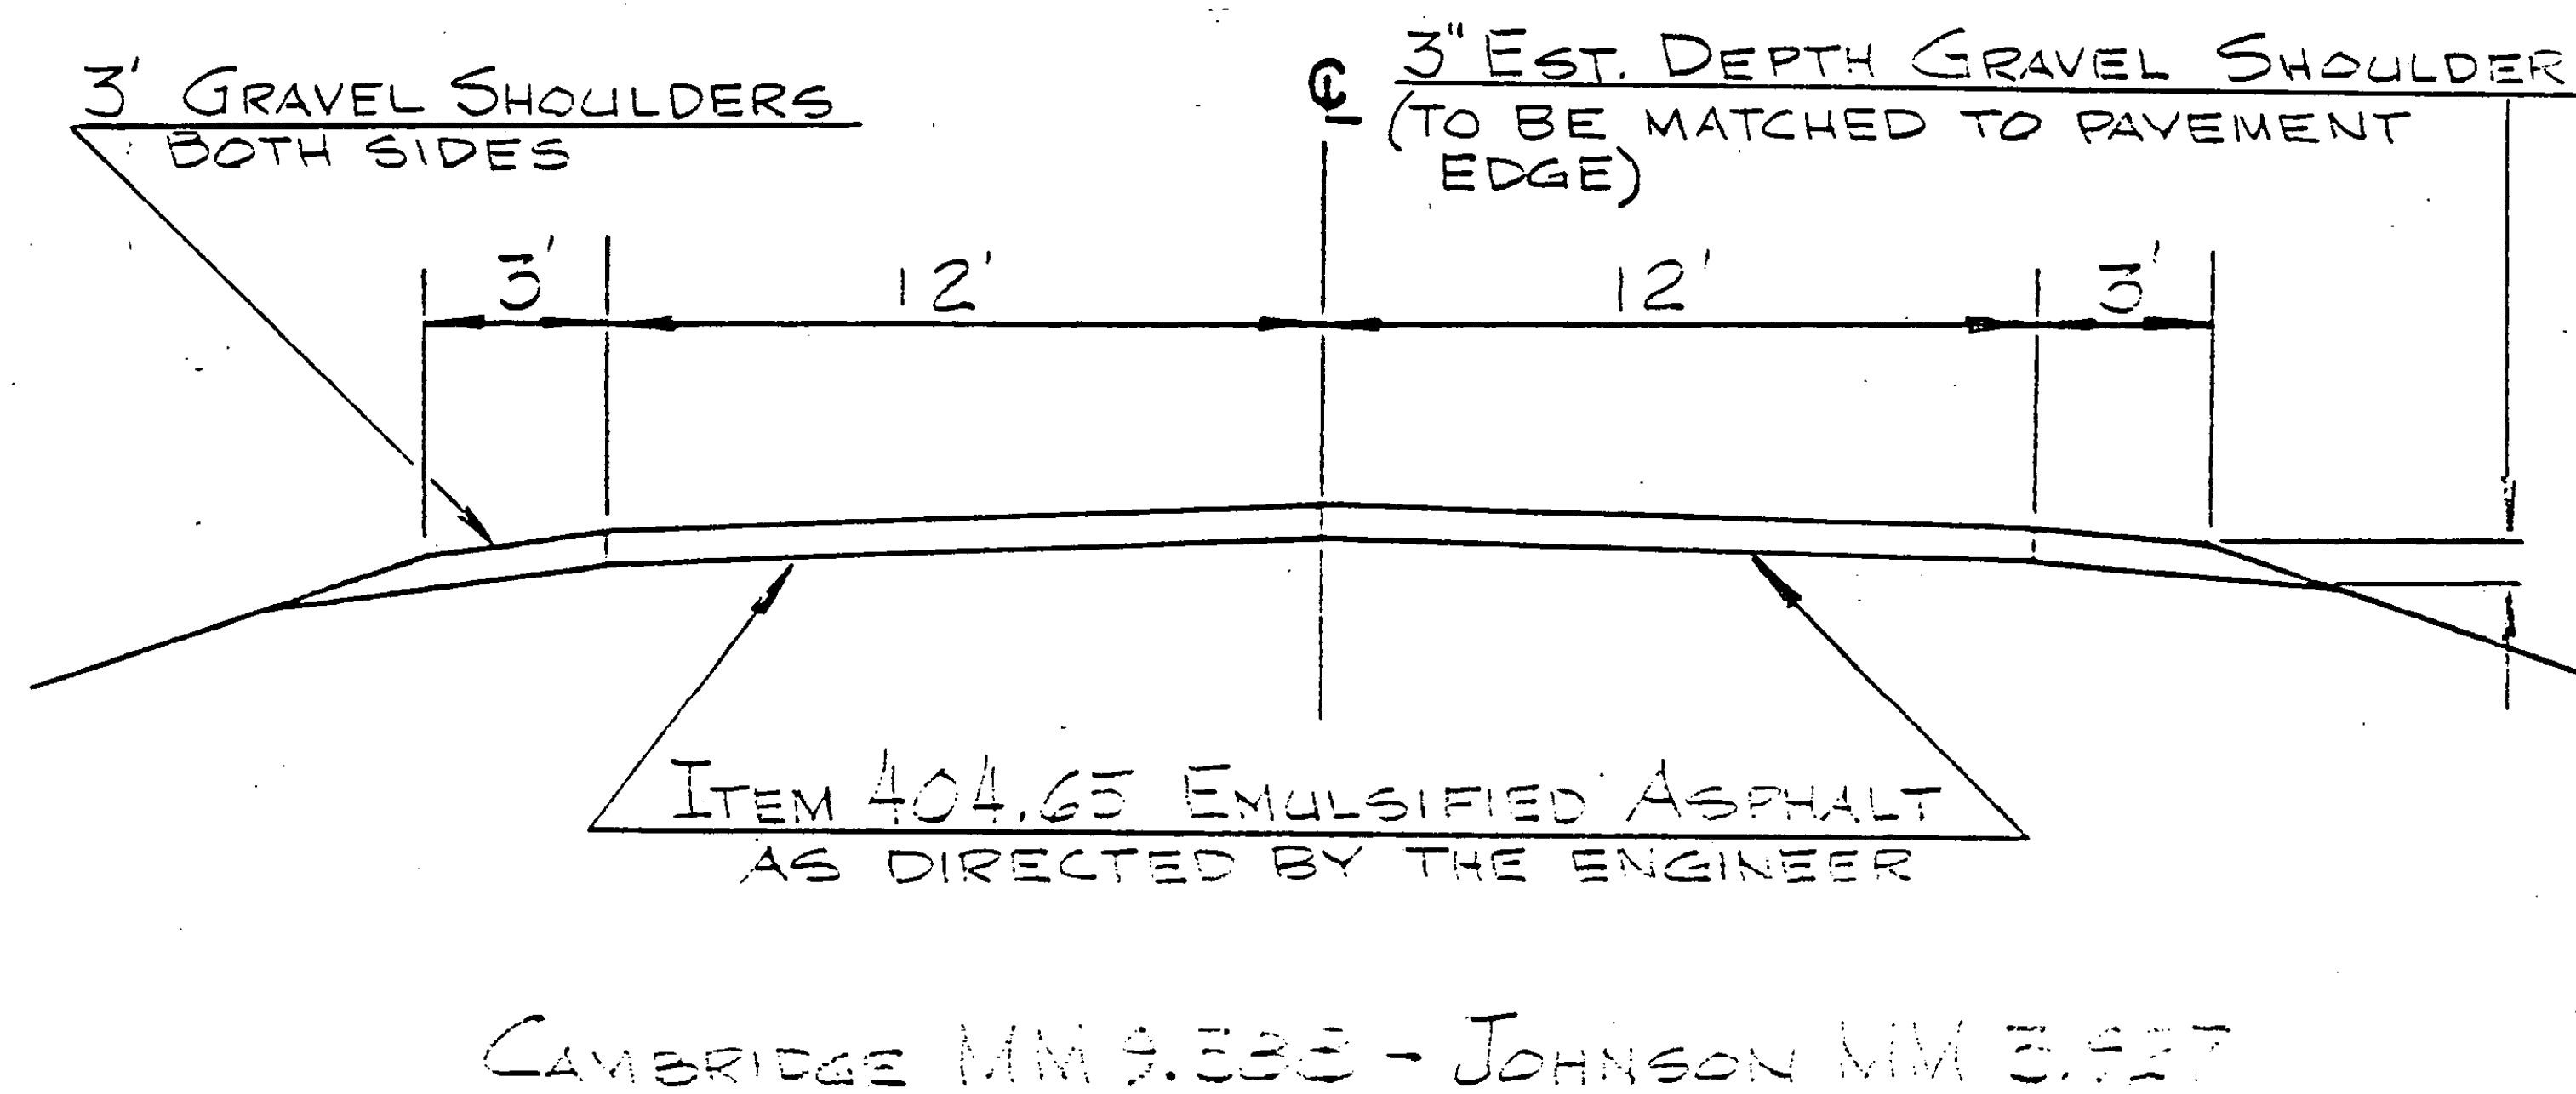


ITEM 406.25 BITUMINOUS CONCRETE PAVEMENT
 LEVELING COURSE, TYPE III OR IV (24' WIDE @ 327 TONS/MI.)
 AS DIRECTED BY THE ENGINEER
 1" - WEARING COURSE, TYPE III

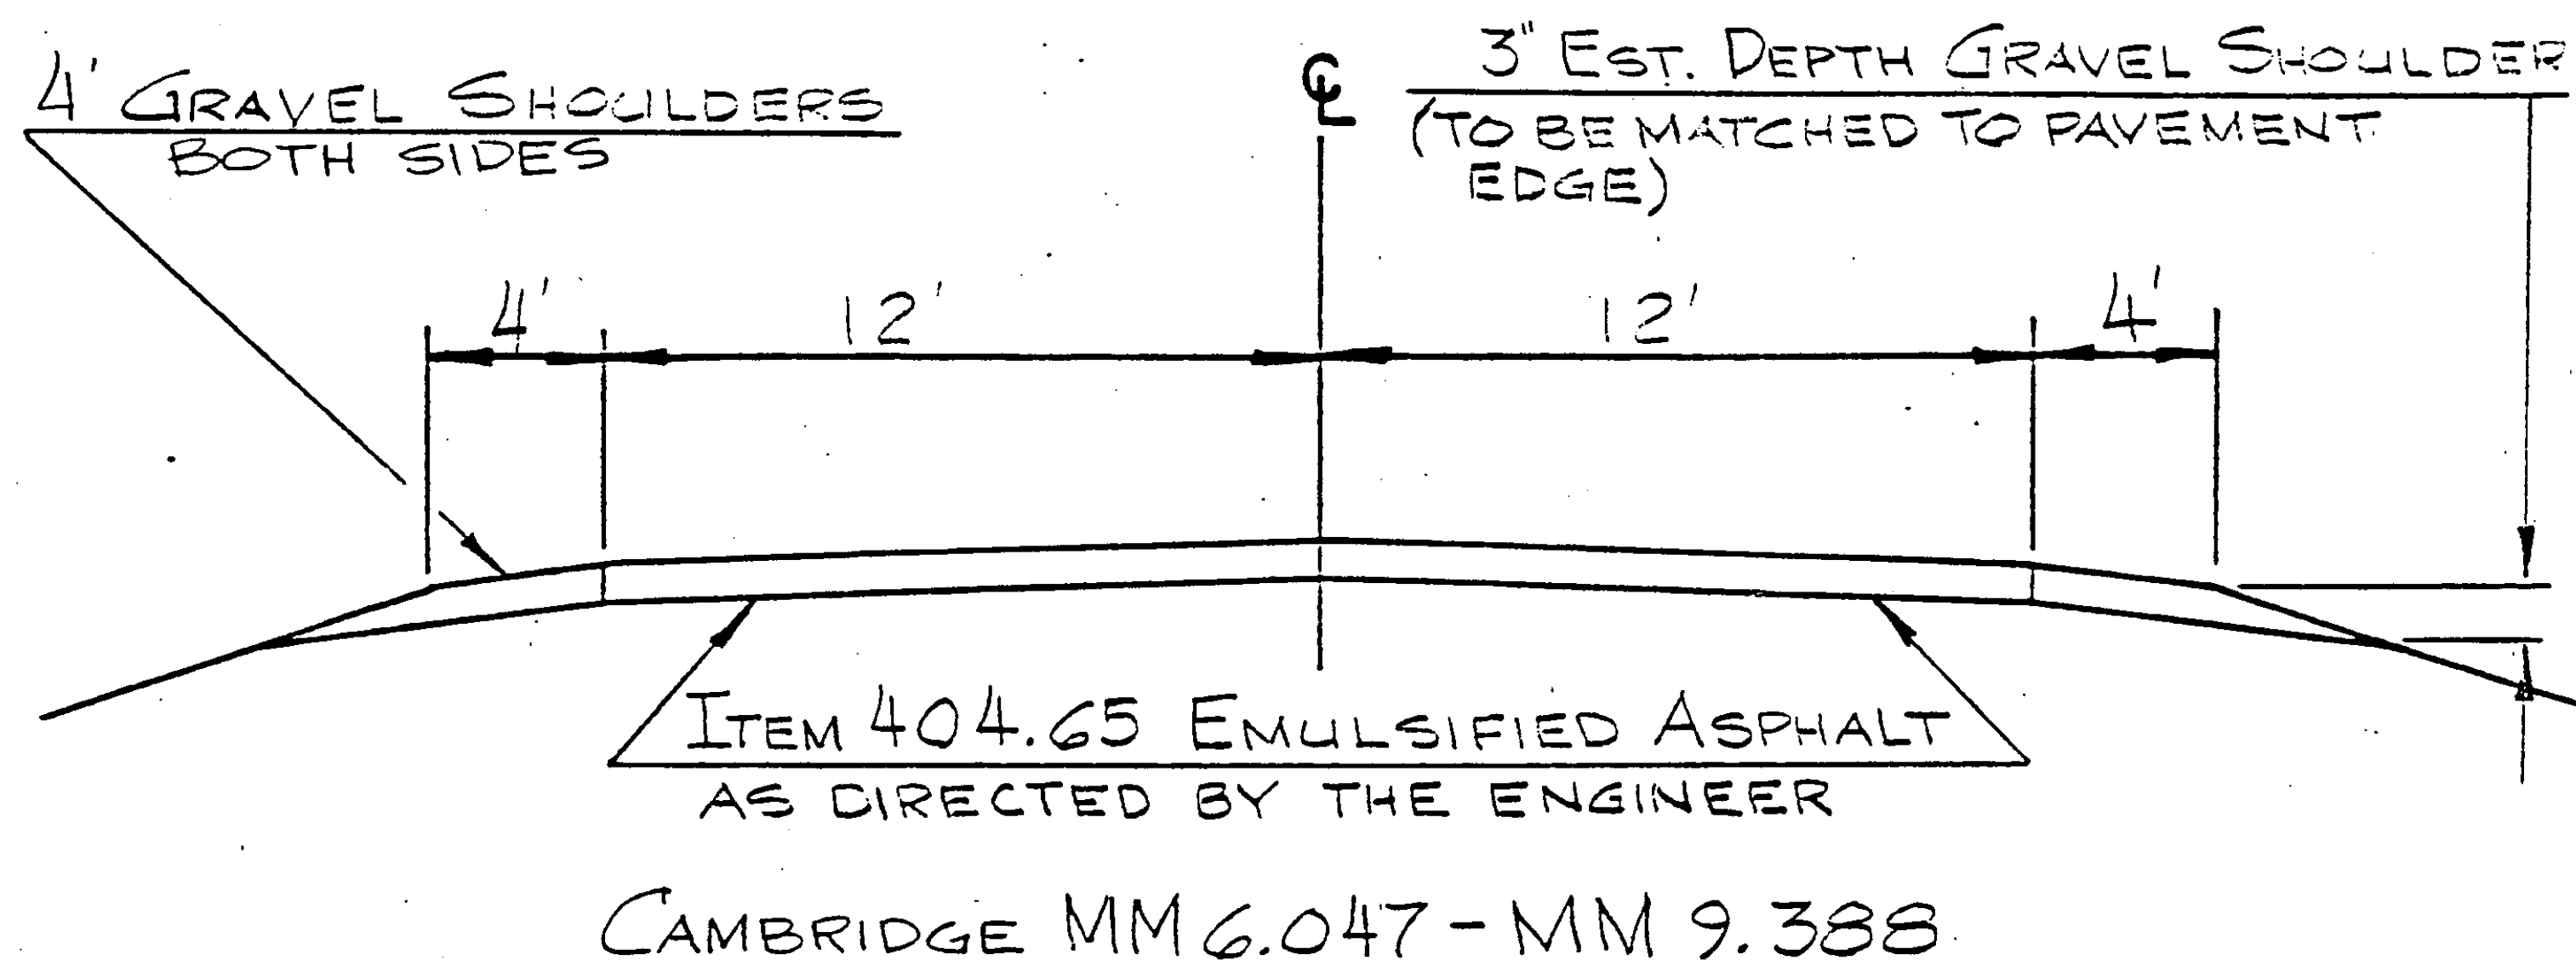

PROJECT CAMBRIDGE-JOHNSON

NO. HMA 2626
 SHEET 8 OF 31