


PROJECT DESCRIPTION AND LOCATION

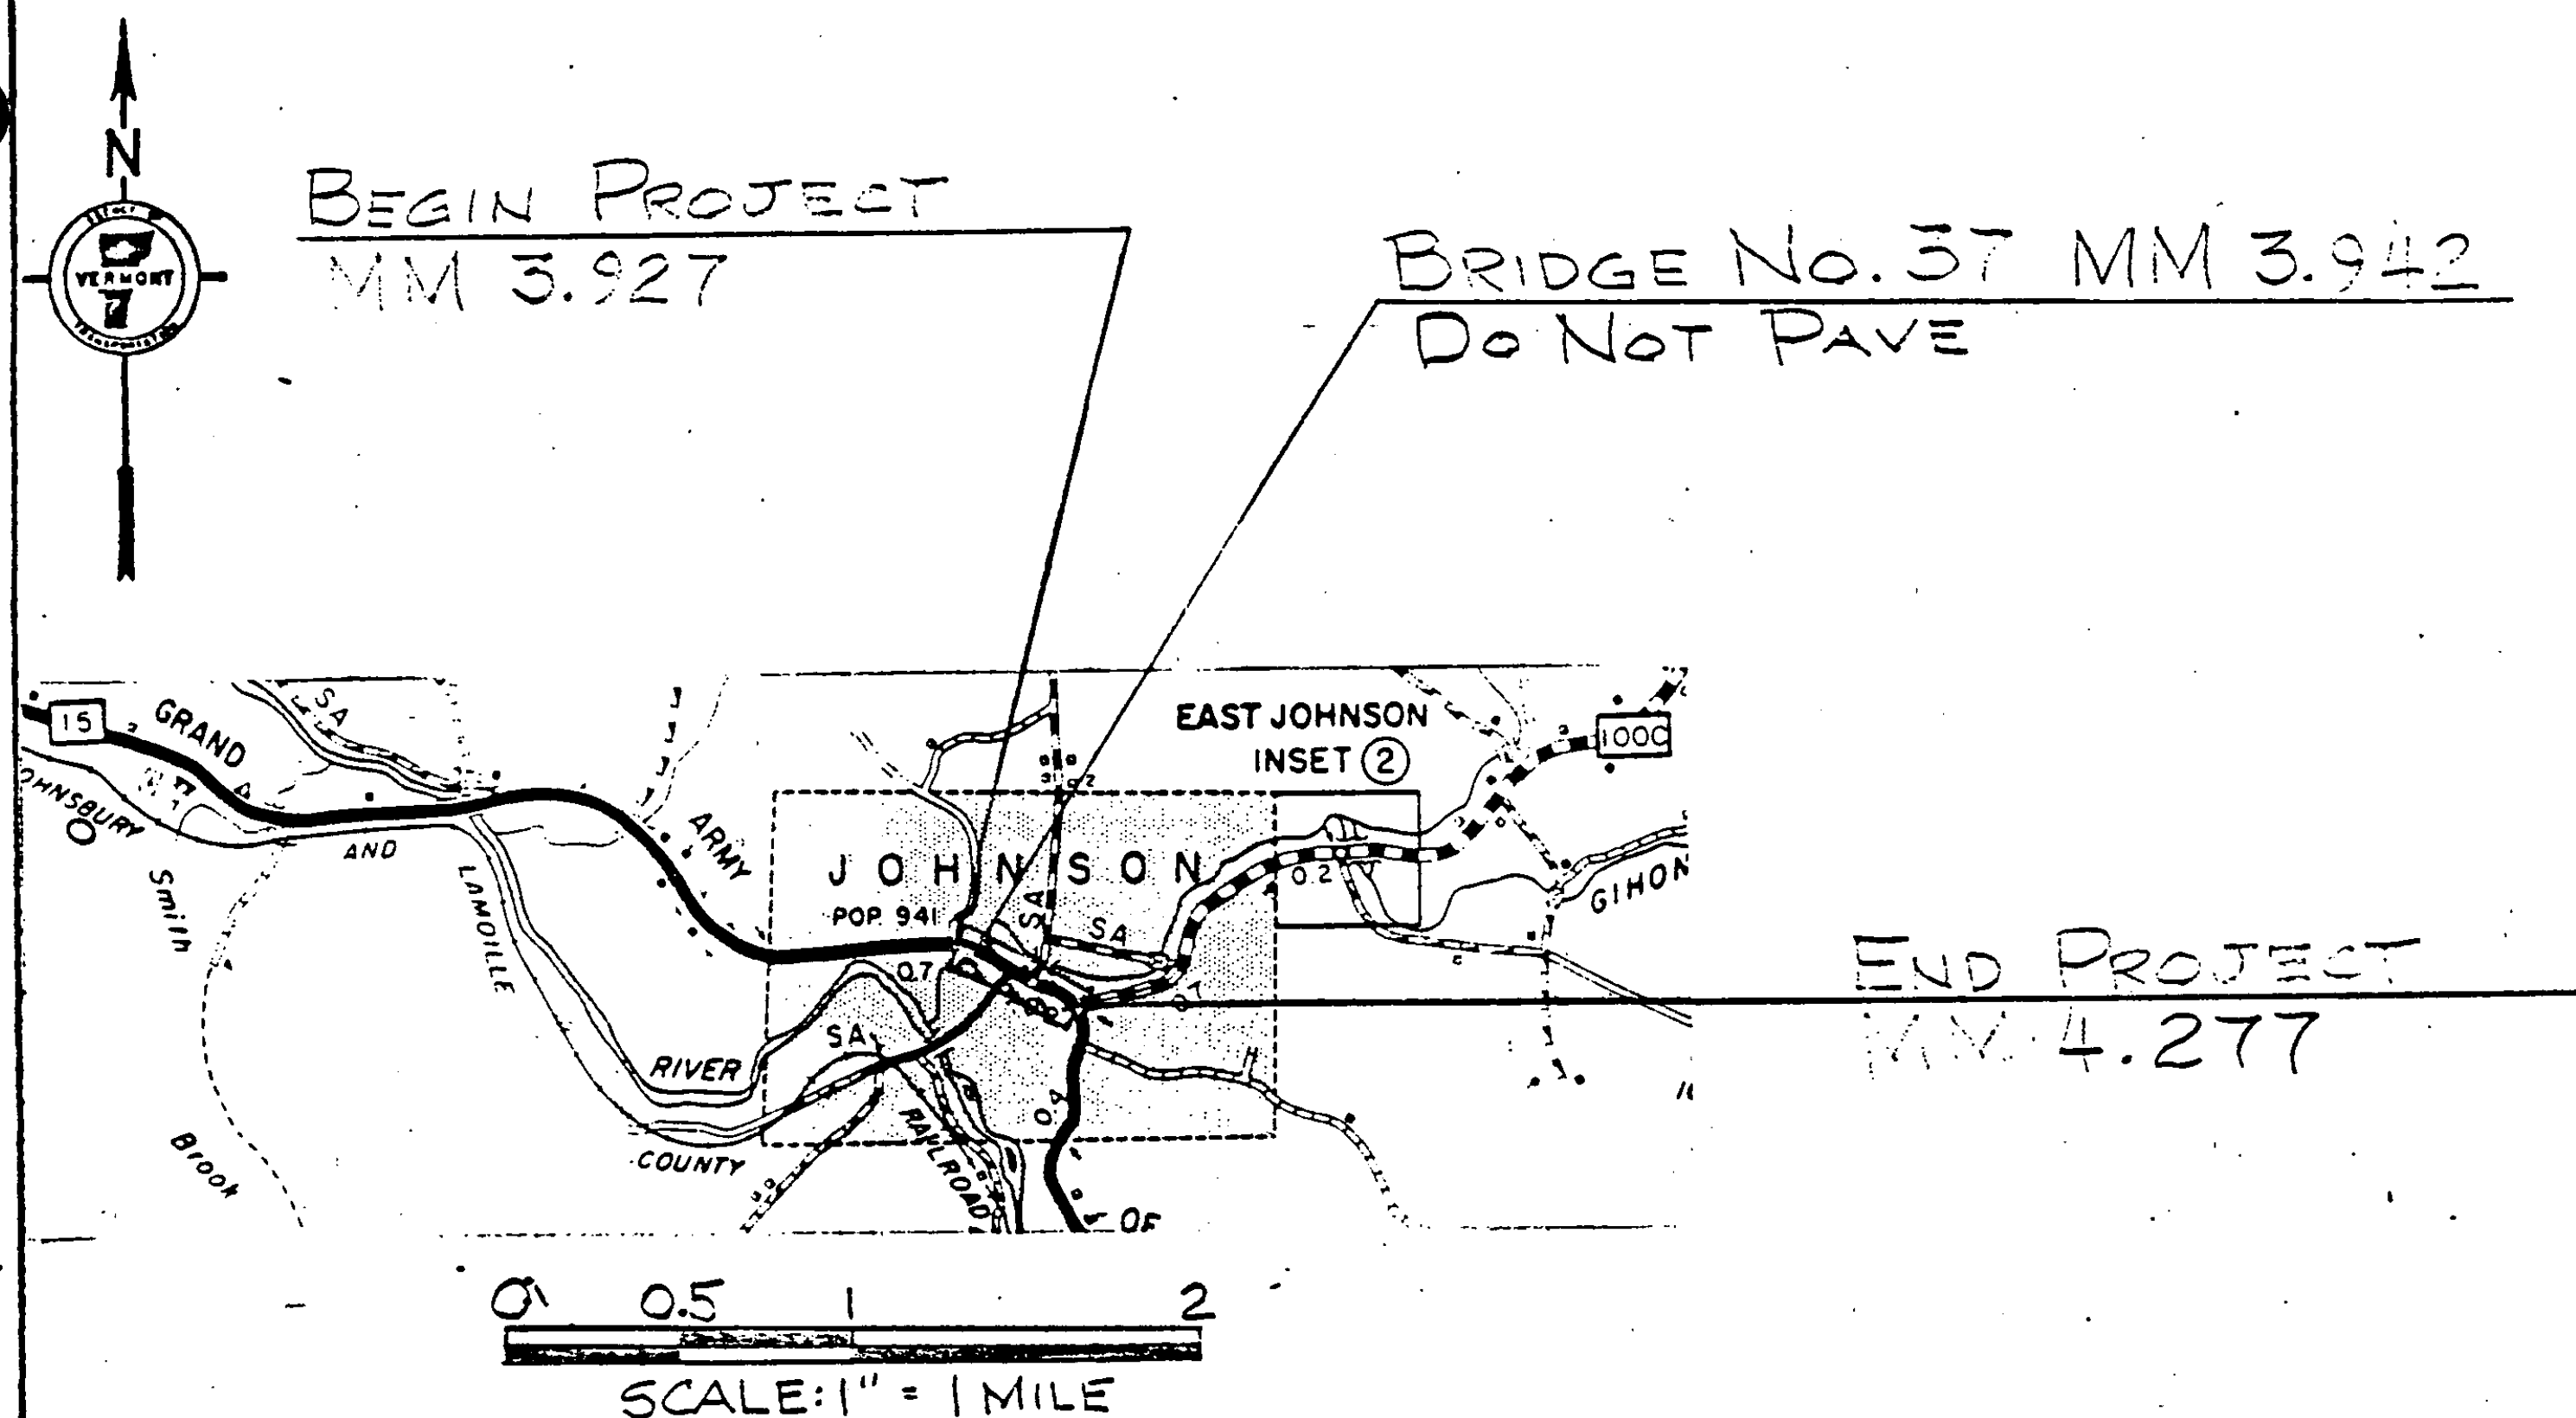

ON VT. RT. 15 IN THE VILLAGE OF JOHNSON, BEGINNING 0.350 MILES WESTERLY OF THE INTERSECTION OF VT. RT. 15 AND VT. RT. 100C AT MM 3.927, THEN EASTERLY 0.350 MILES TO MM 4.277. END OF PROJECT IS AT THE INTERSECTION OF VT. RT. 15 AND VT. RT. 100C.

LENGTH OF PROJECT: 0.350 MILES
1849 FEET

TRAFFIC DATA
1992 ADT = 4250
V = 25 MPH

PROJECT JOHNSON

NO. E 030-2(15)S

SHEET 13 OF 31 SHEETS