


TYPICAL SECTIONS & DESIGN DATA

ITEM 406.25 BITUMINOUS CONCRETE PAVEMENT
 LEVELING COURSE, TYPE III OR IV (37 WIDE @ 420 TONS/MI.)
 AS DIRECTED BY THE ENGINEER
 1 1/2" - WEARING COURSE, TYPE III

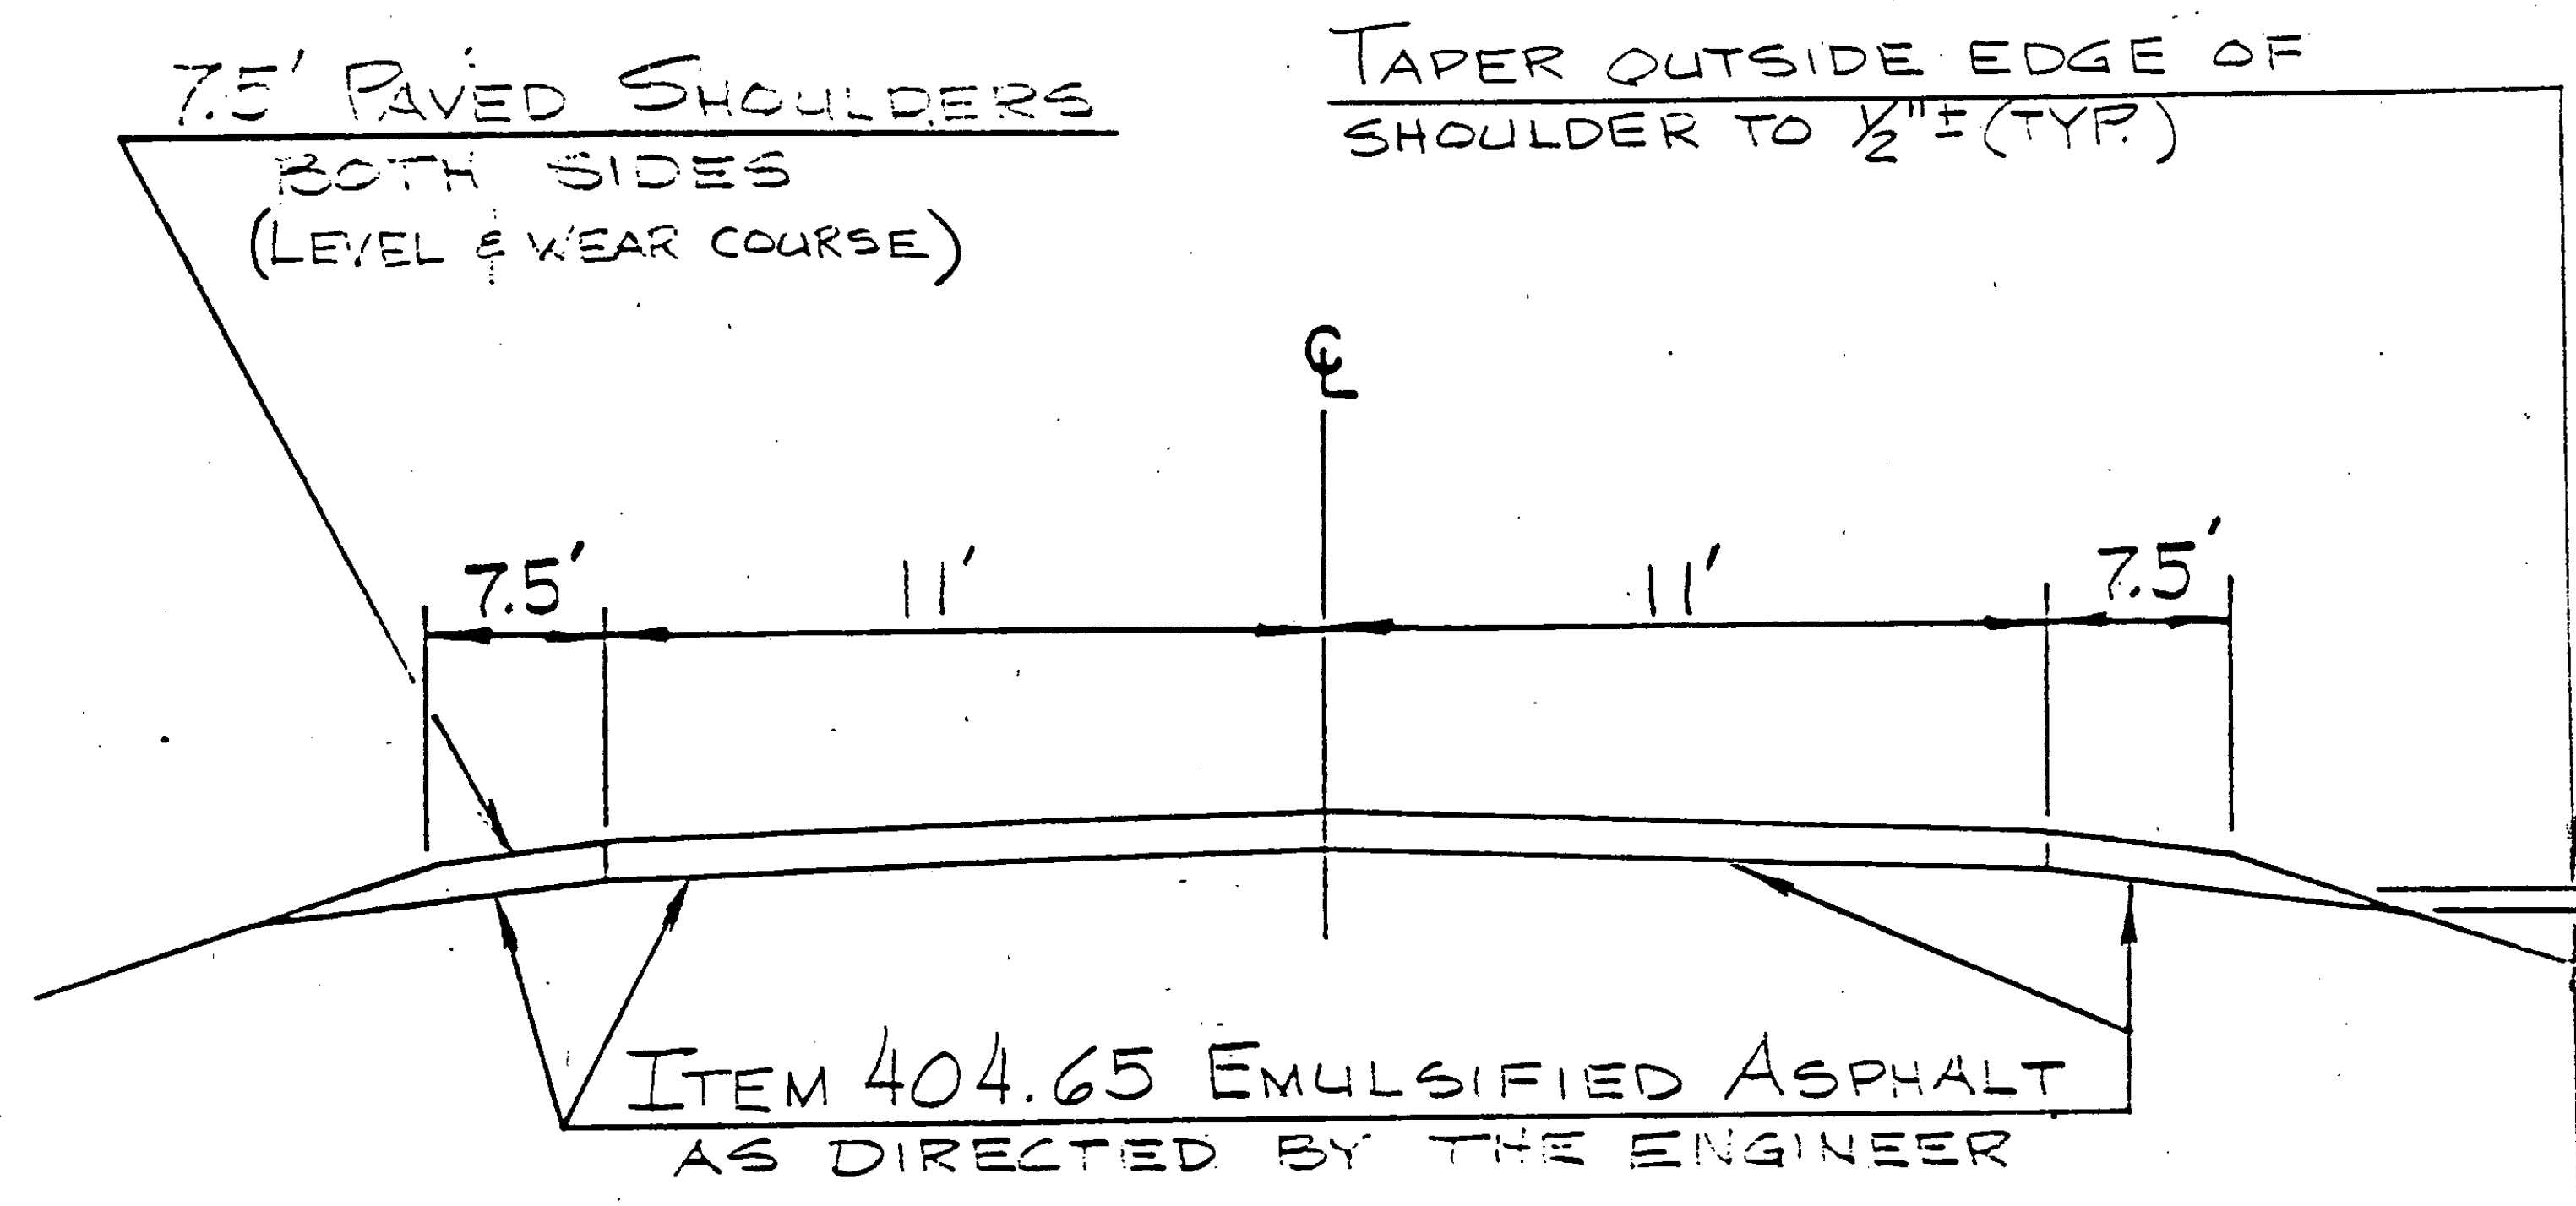

JOHNSON MM 4.10 - MM 4.277

Note: Topsoil, Item 653.10 to be applied as directed by the Engineer.
 Seed, Fertilizer, Limestone and Mulch Items to be applied as required,
 payment to be subsidiary to the Topsoil item.

PROJECT JOHNSON

NO. F030-2(15)S

SHEET 4 A OF 3 SHEETS