



CURB LAYOUT AND TYPICAL

NET & T #2

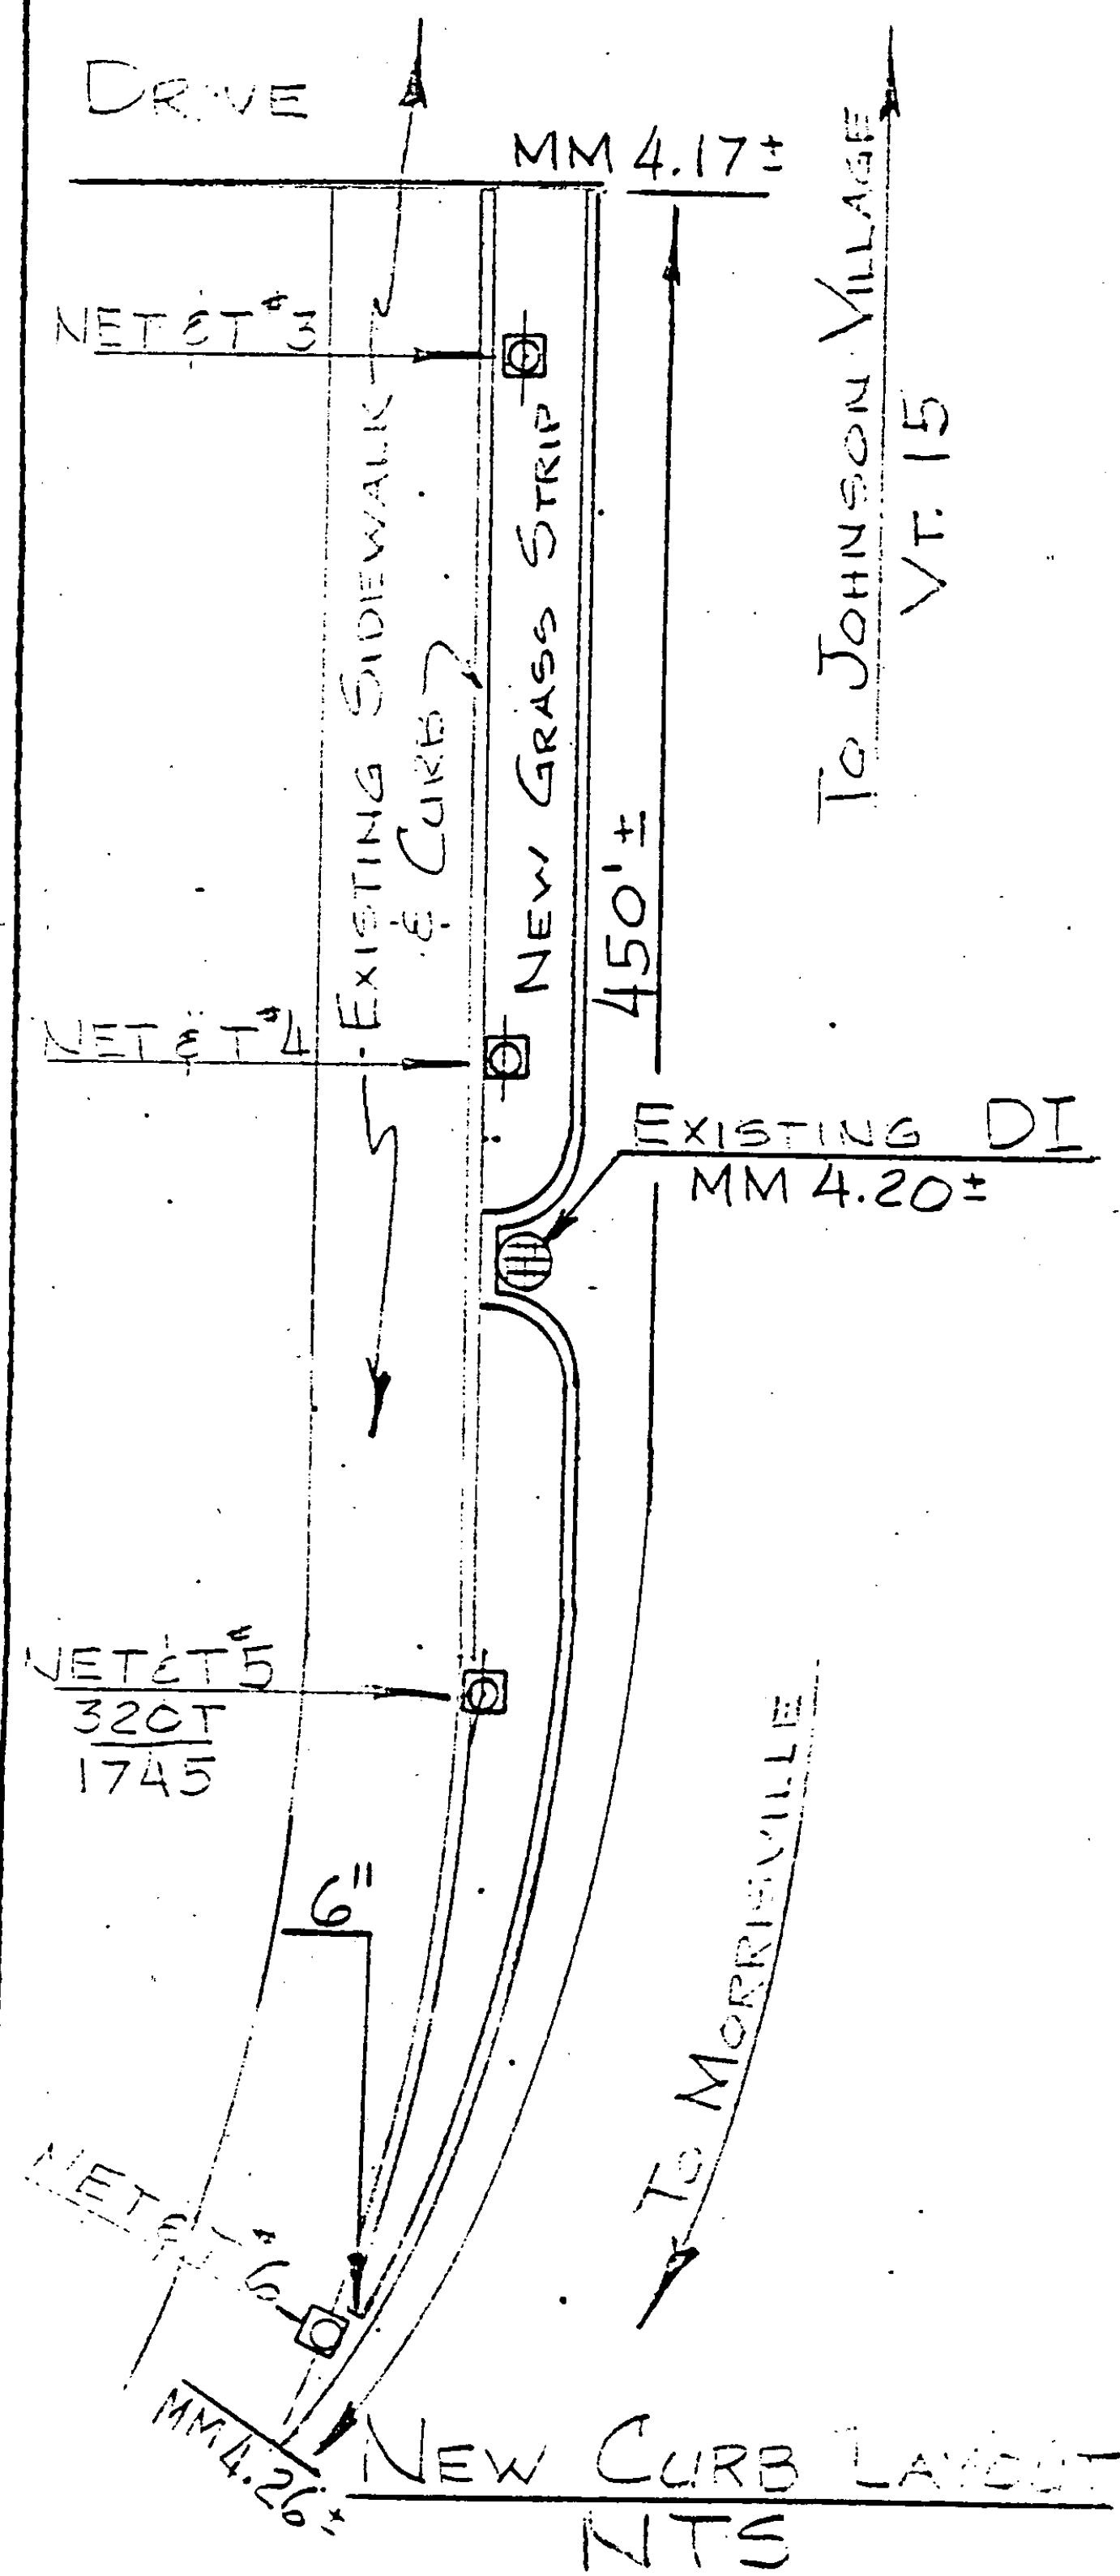

EXISTING SIDEWALK & CURB

NEW CAST IN PLACE CEMENT
CONCRETE CURB, TYPE 3
SEE STD. C-1

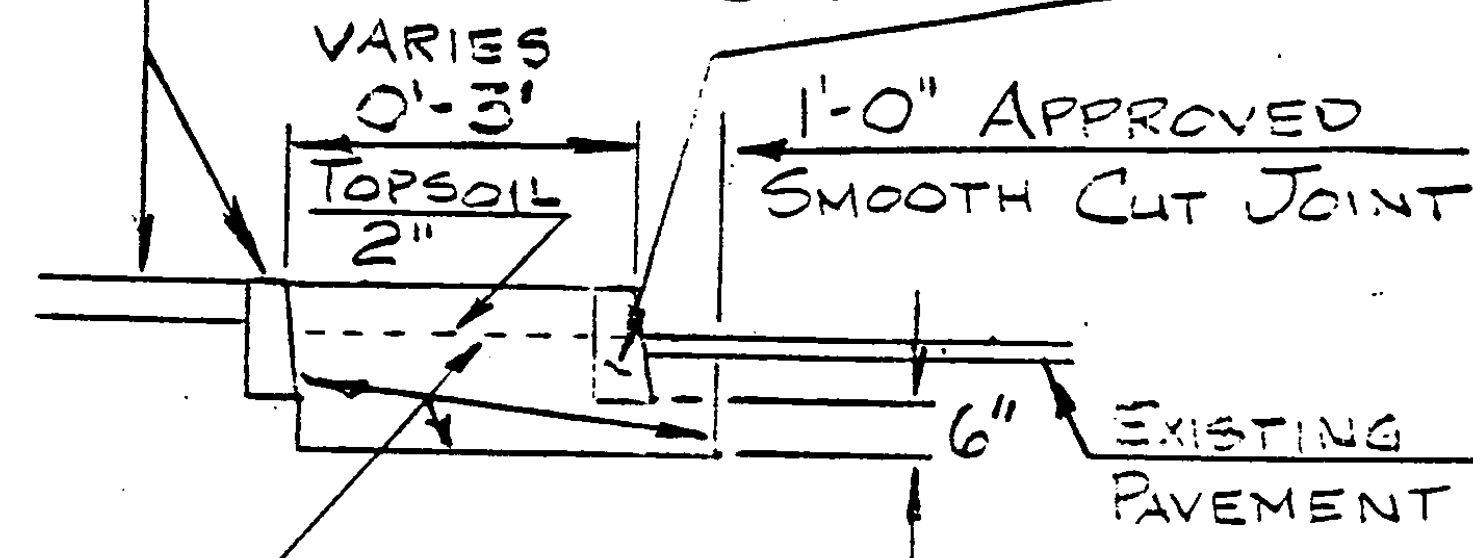

LIMITS OF UNCLASSIFIED
EXCAVATION (BACKFILL WITH
GRANULAR BORROW)

TYPICAL CURB SECTION
N.T.S

NOTE:

1. SEE STD. C-1 FOR CURB
END TREATMENT AT
DRIVES.
2. WHEN DISTANCE BETWEEN
EXISTING CURB & NEW CURB
IS 6" (AT MM 4.26±) FILL
AREA BETWEEN WITH
CONCRETE

PROJECT JOHNSON

NO. 30-4/15'S

SHEET 15 OF 31 SHEETS