


# PROJECT DESCRIPTION AND LOCATION

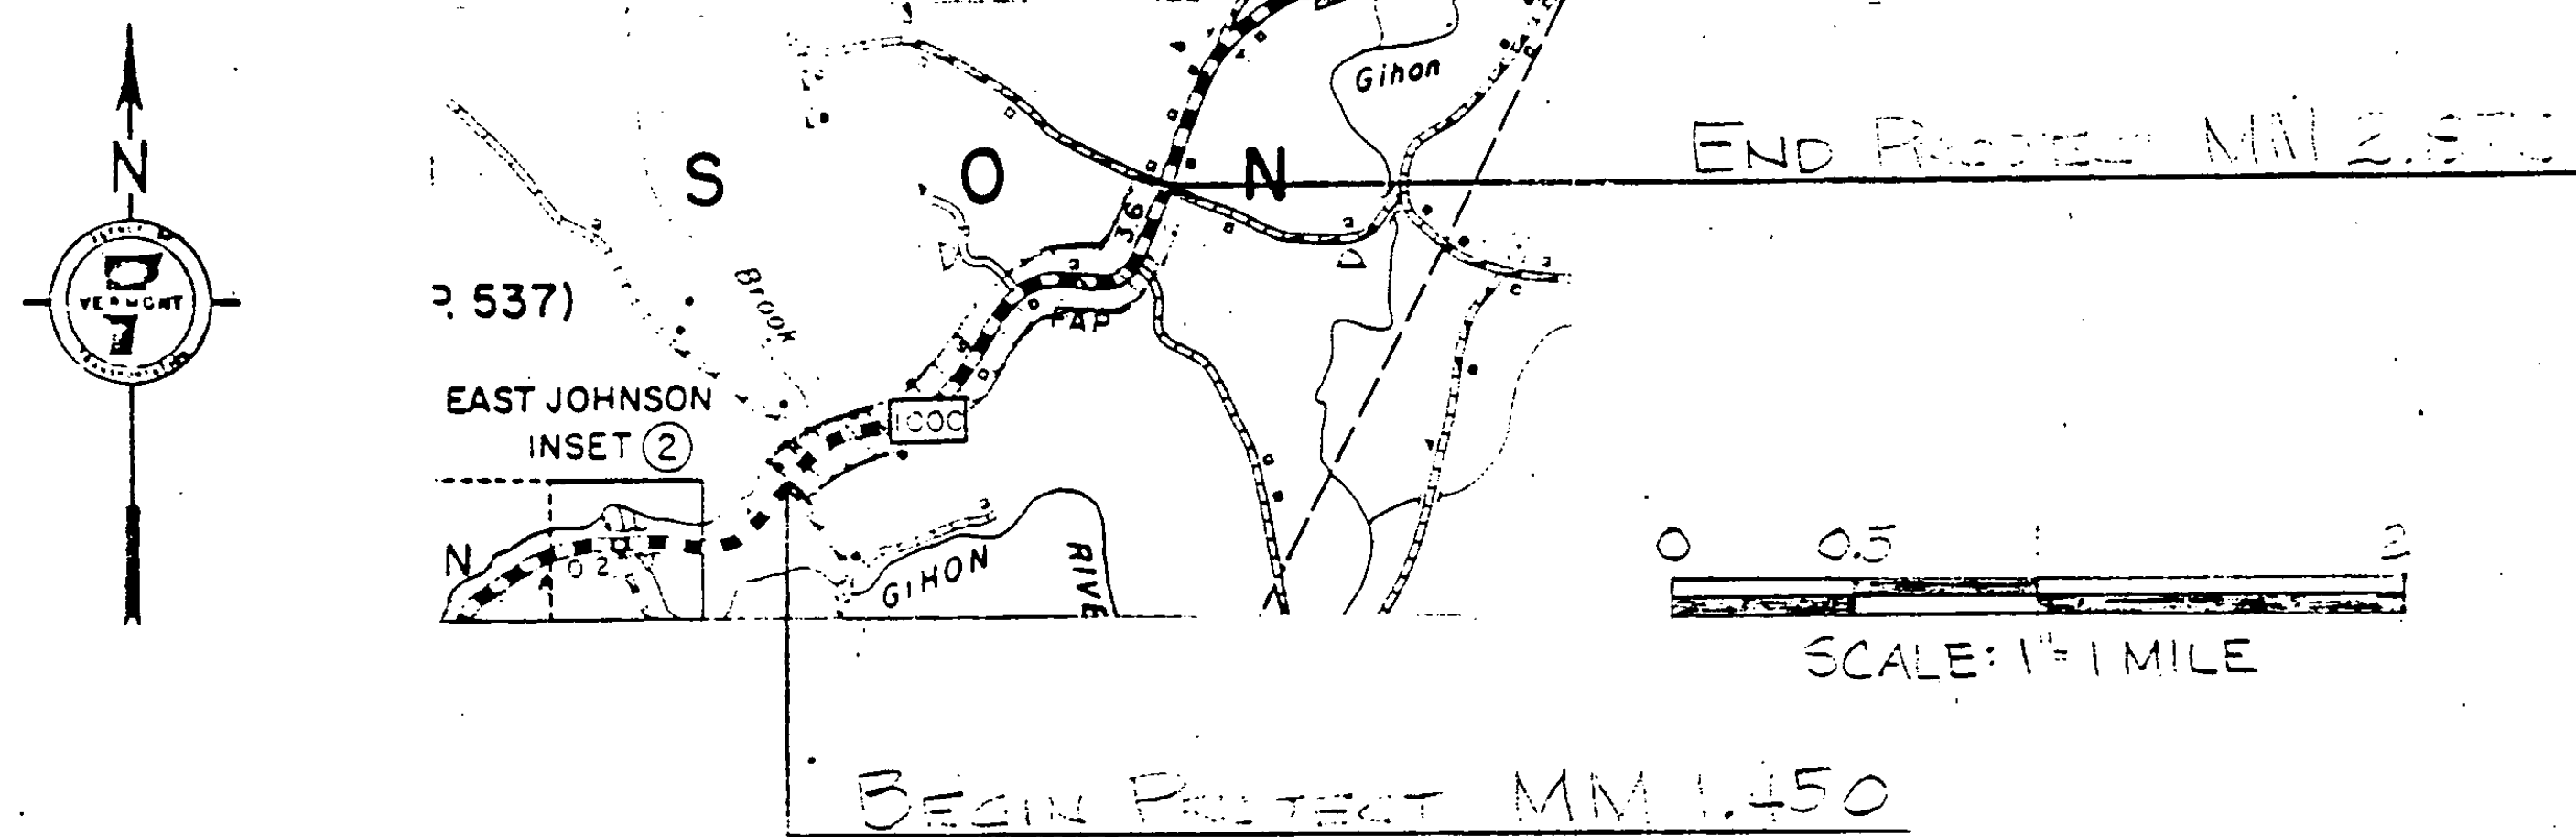

ON VT. RT. 100C, BEGINNING 1.450 MILES NORTH OF  
 THE INTERSECTION OF VT. RT. 15 AND VT. RT. 100C IN  
 THE VILLAGE OF JOHNSON, AT MM 1.450 THEN NORTHEAST  
 1.42 MILES TO MM 2.870. END OF PROJECT IS 1.645  
 MILES SOUTHEASTLY OF THE JOHNSON-HYDE PARK JCT.

LENGTH OF PROJECT: 1.420 MILES  
 7498 FEET

TRAFFIC DATA  
 1430  
 VT 100C

PROJECT

NO. 2627

SHEET 6 OF 31 SHEETS