


TYPICAL SECTIONS & DESIGN DATA

ITEM 406.25 BITUMINOUS CONCRETE PAVEMENT
 LEVELING COURSE, TYPE III OR II 1/2 IN. THICK @ 2 1/2 IN. MIN. MAX.
 AS DIRECTED BY THE ENGINEER
 3/4" WEARING COURSE, TYPE IV

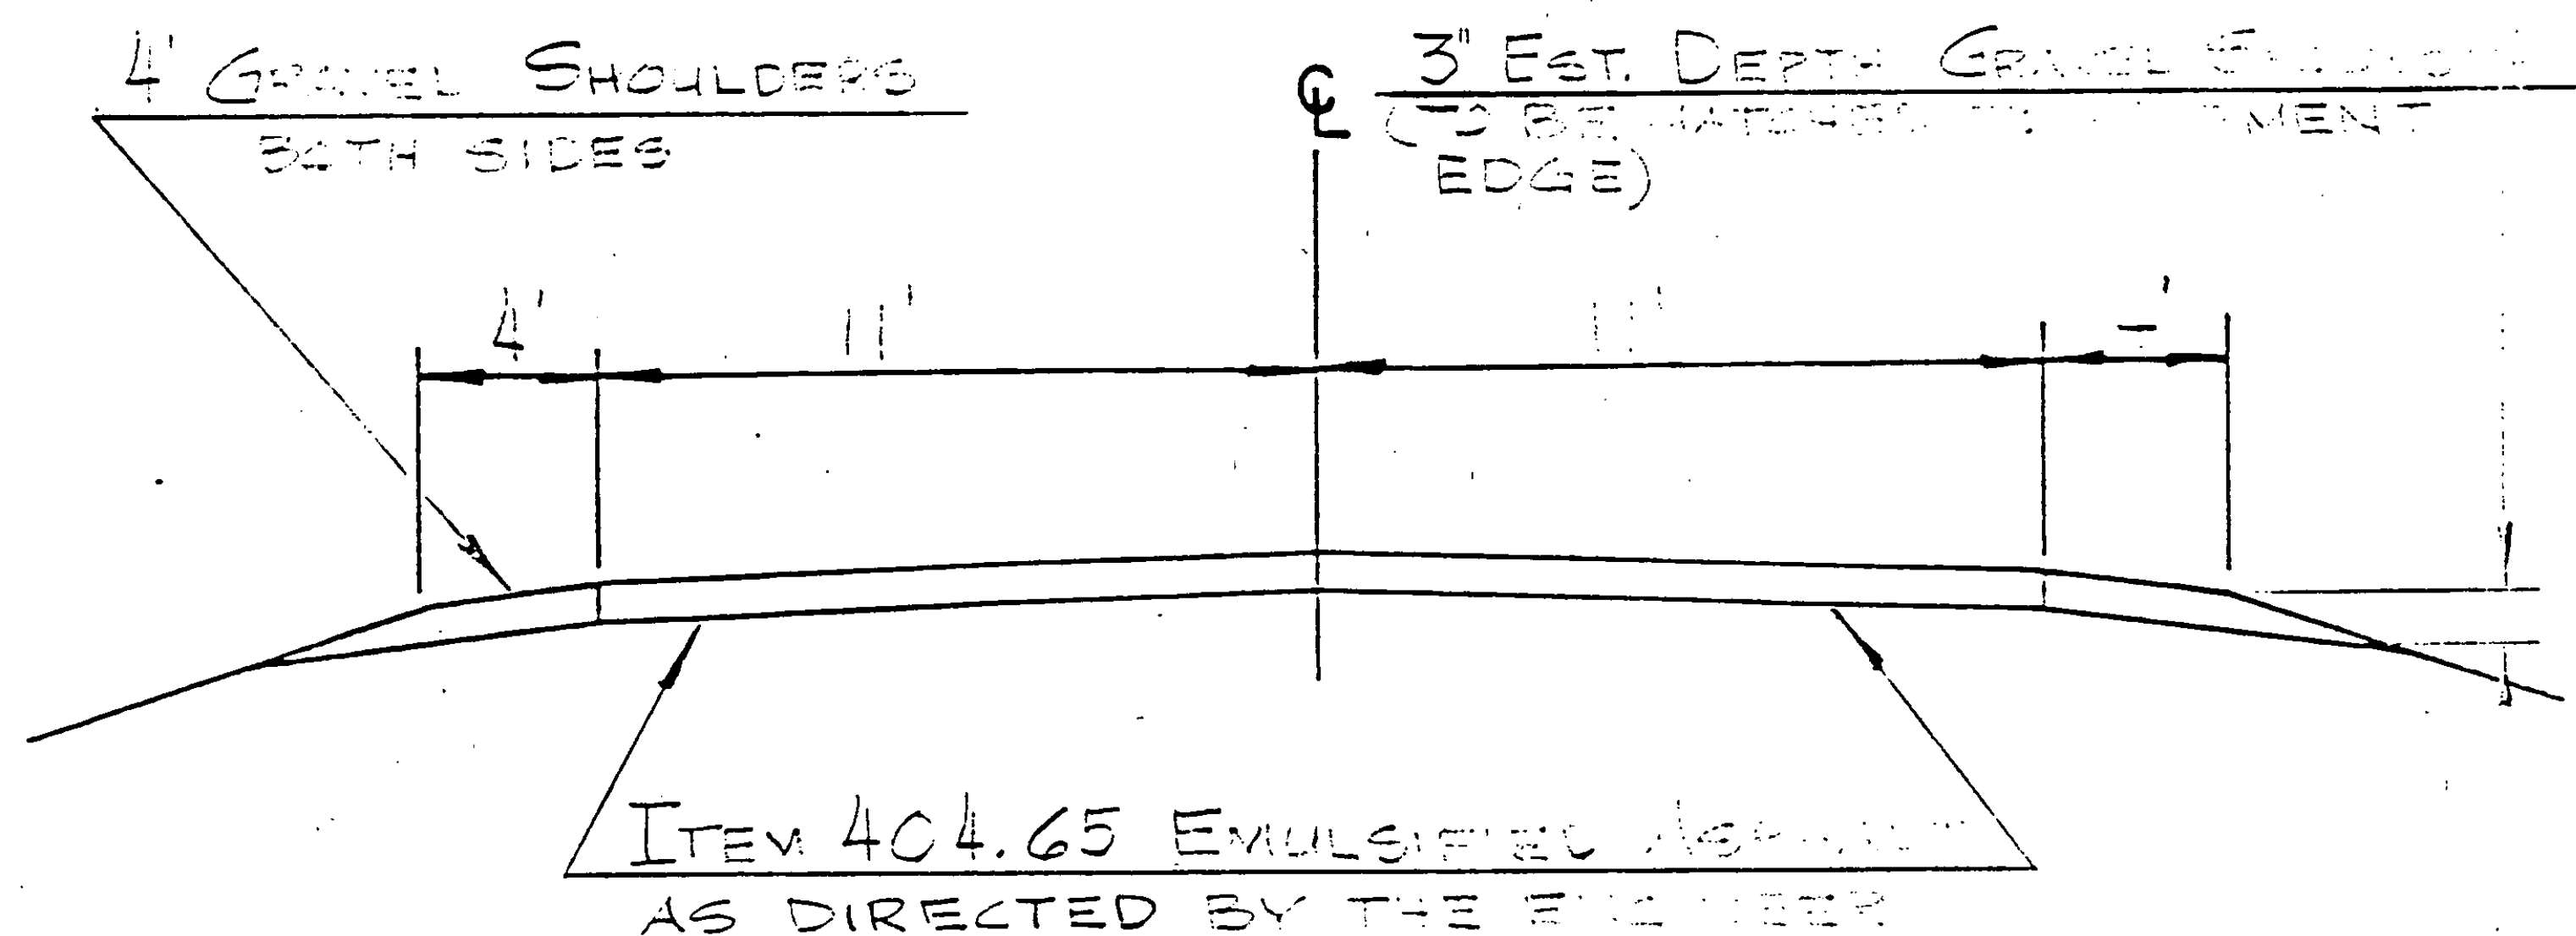

JOHNSON MM 1.450 - MM 2.500

PROJECT JOHNSON

NO. HMA 2007

SHEET 12 OF 31 SHEETS