


# PROJECT DESCRIPTION AND LOCATION

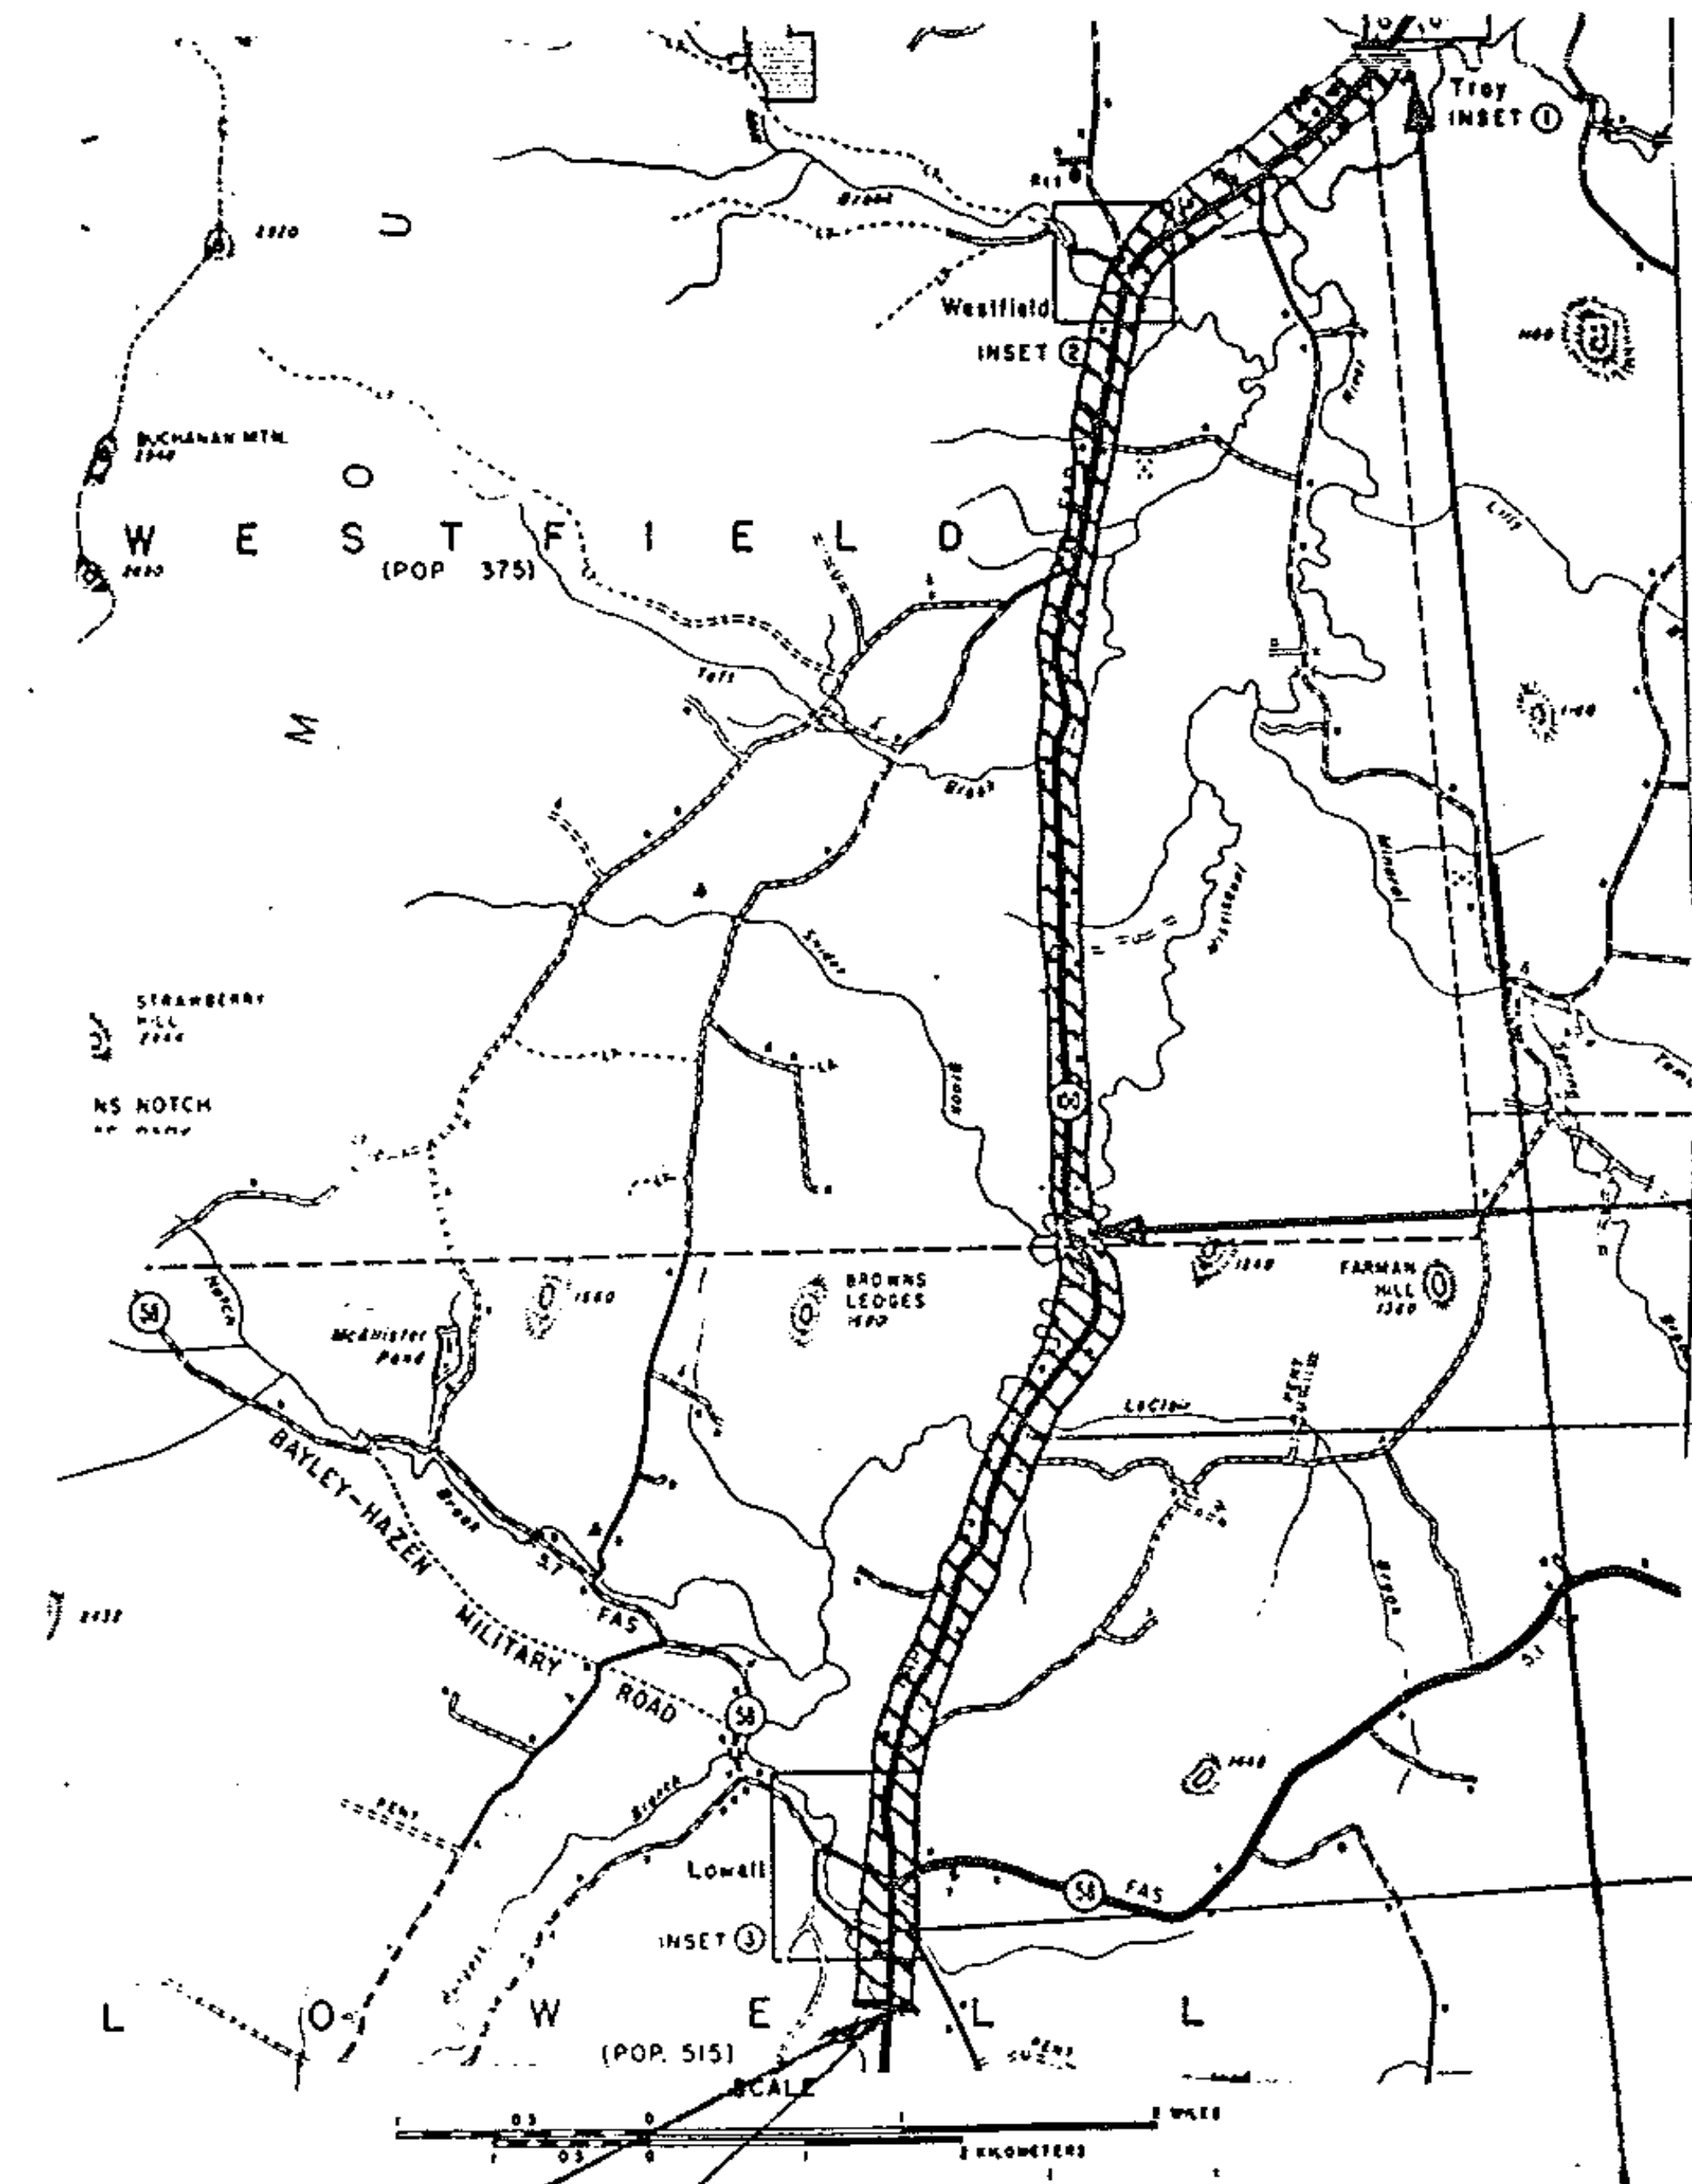

BRIDGE 241  
DO NOT PAVE  
MM 0.12

BRIDGE 239  
MM 6.222  
DO NOT PAVE

BRIDGE 236  
MM 3.590  
TOP COURSE ONLY

END PROJECT  
MM 4.686

BEGIN PROJECT  
MM 2.650

BRIDGE 234  
MM 2.876 TOP COURSE ONLY

VT 100- IN THE TOWN OF LOWELL BEGINNING AT MM 2.650 AND EXTENDING 9.067 MILES NORTHERLY TO MM 4.686 IN THE TOWN OF WESTFIELD.

LENGTH OF PROJECT  
9.067 MILES  
47,874 FEET

PROJECT LOWELL-WESTFIELD

NO. F 029-2(8)S  
SHEET 8 OF 20 SHEETS