


# TYPICAL SECTIONS & DESIGN DATA

ITEM 406.25 BITUMINOUS CONCRETE PAVEMENT  
LEVEL COURSE TYPE III OR IV (250 TONS/MILE)  
AS DIRECTED BY THE ENGINEER  
3/4" WEARING COURSE ( $\pm 1/4$ ) TYPE IV

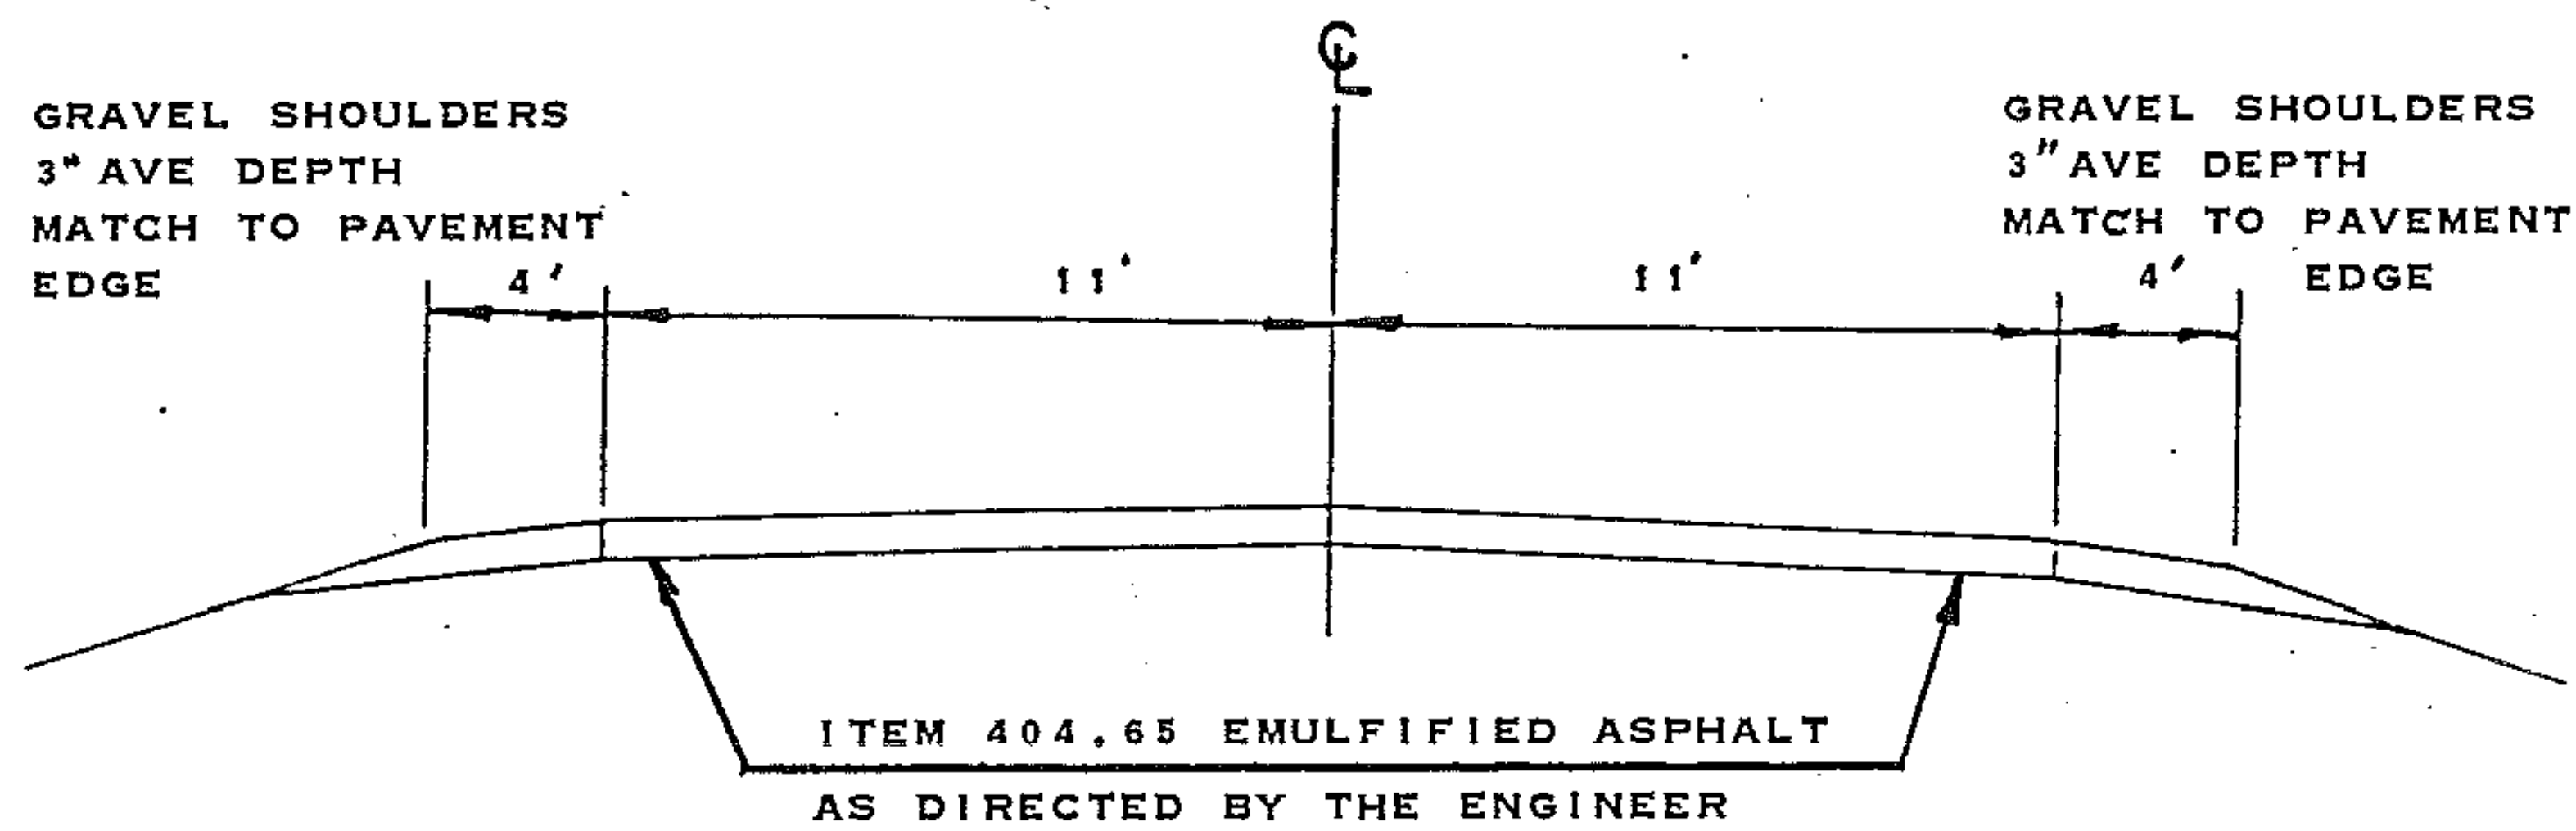

1982 ADT 1150  
V 50

PROJECT LOWEL-WESTFIELD

NO. F 029-2(8)S

SHEET 9 OF 20 SHEETS