


* Centerline treatment shall consist of a minimum of 400 feet of solid line in advance of the intersection and shall be paired with either a solid or dashed line depending on sight distance availability in the opposing lane.

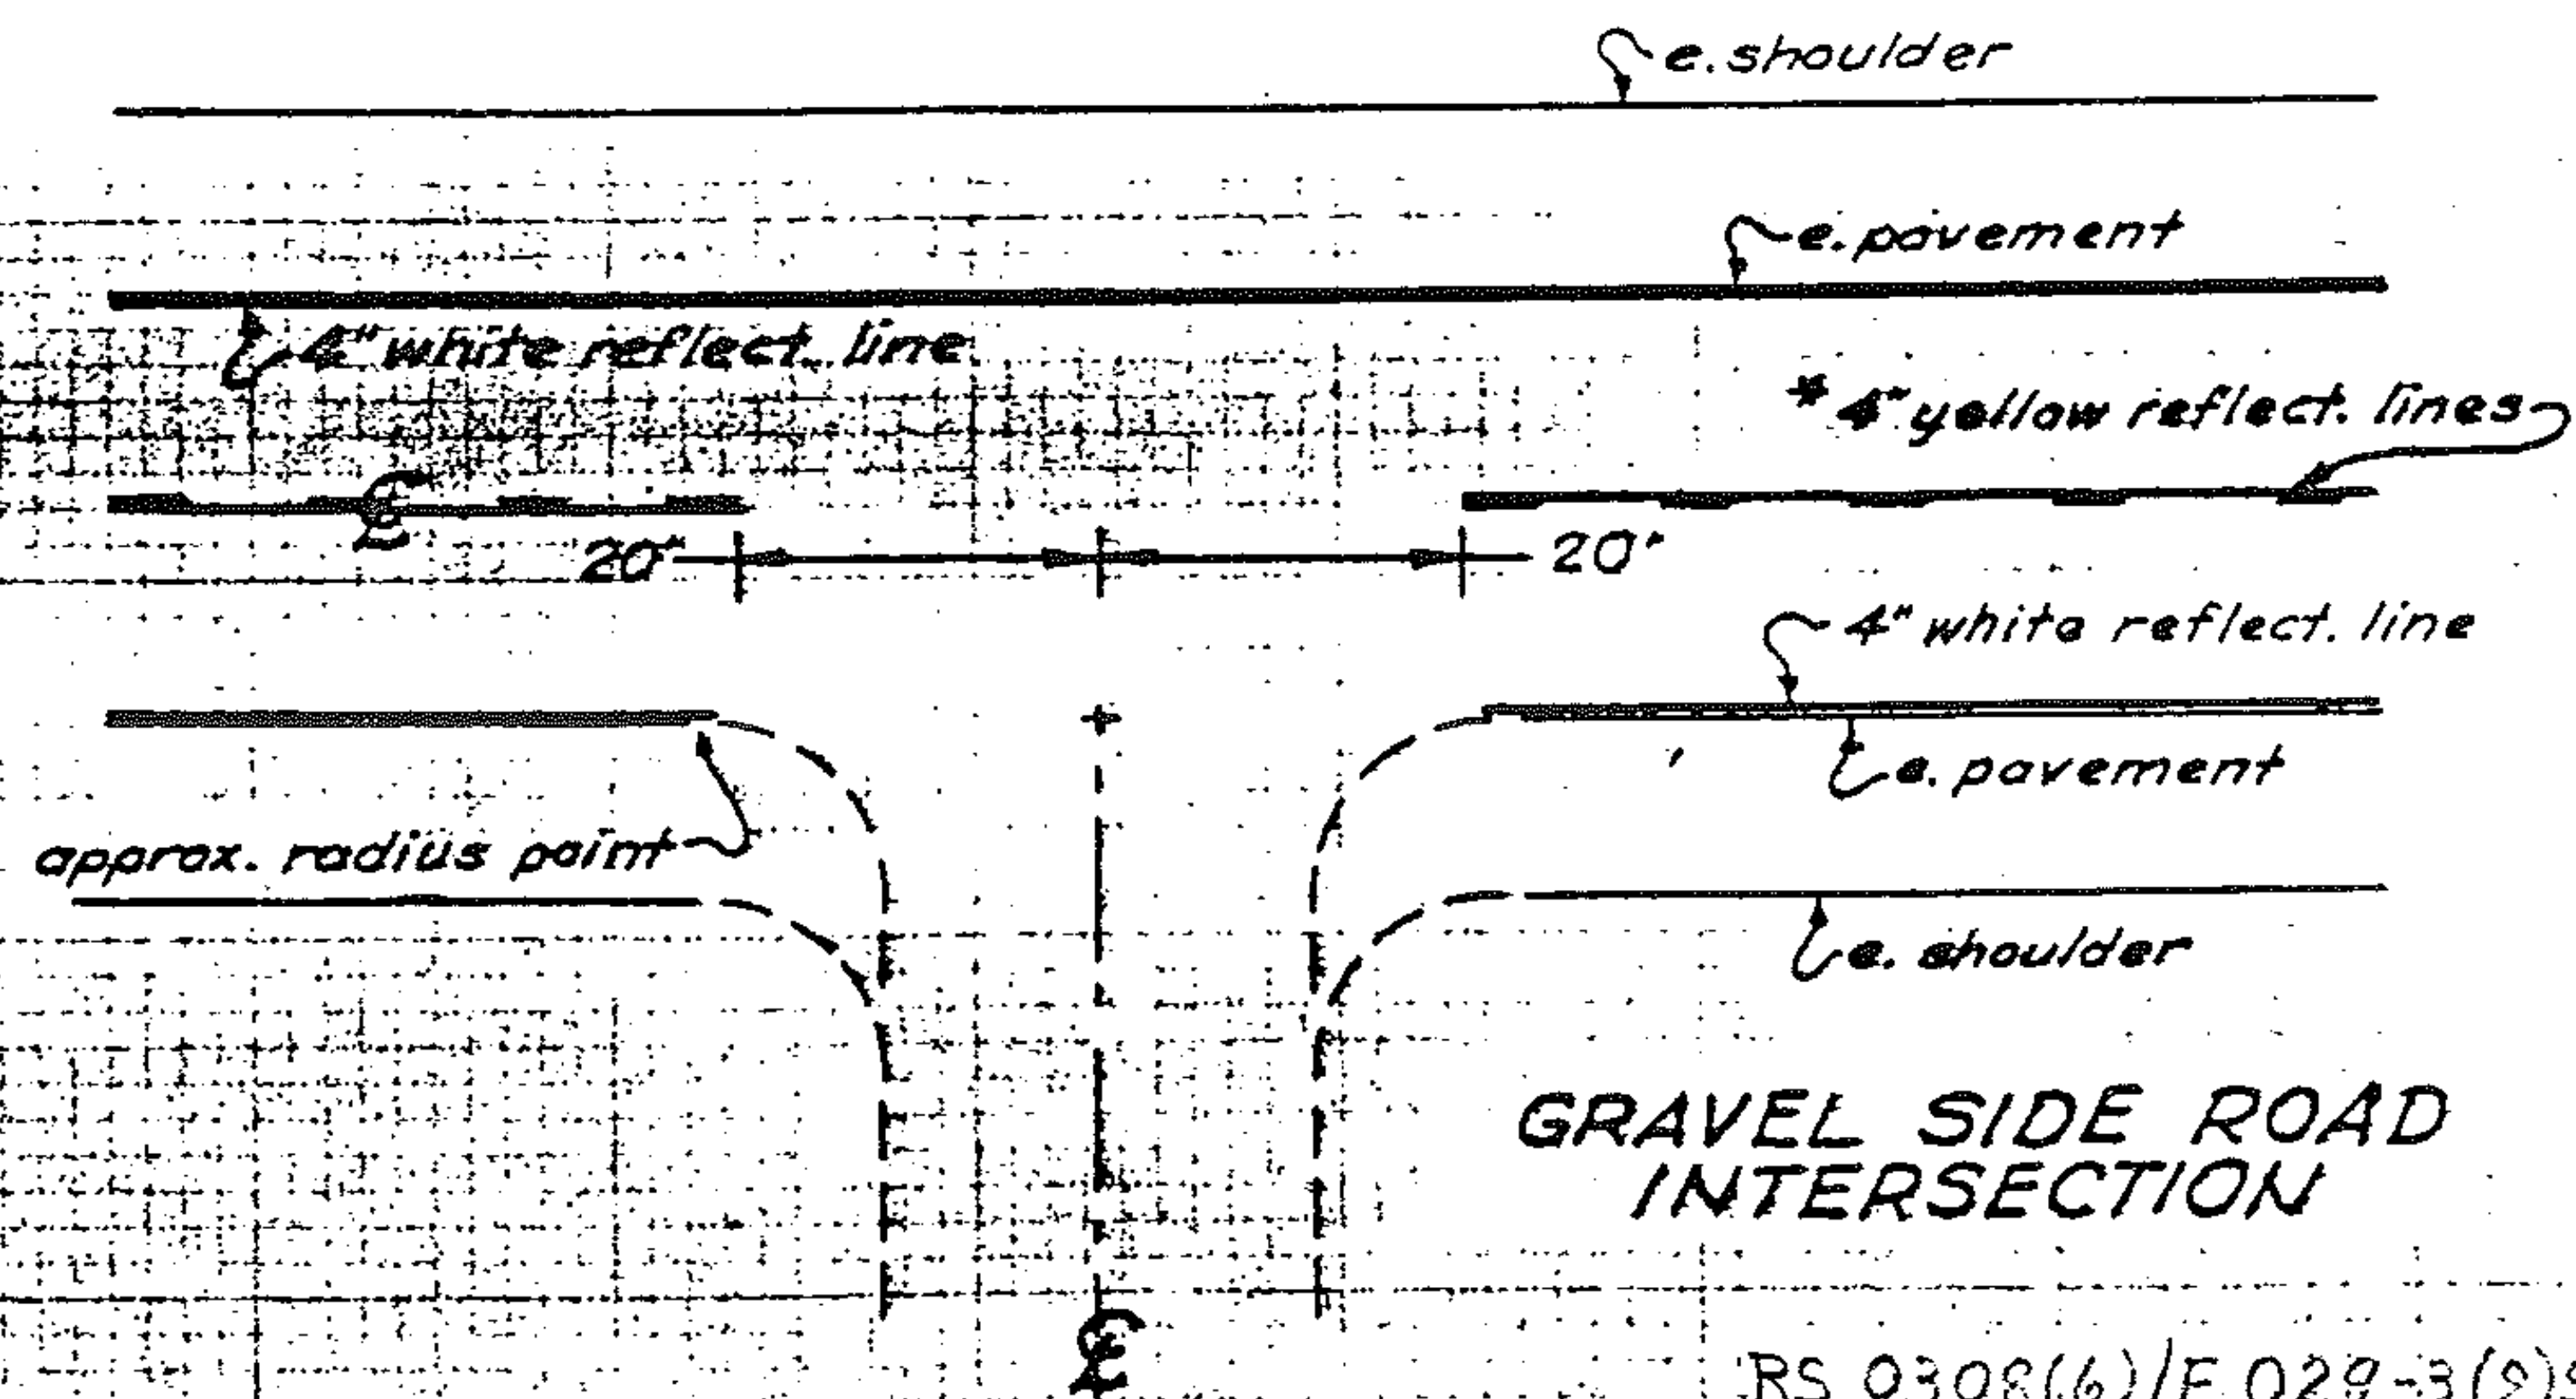

RS 0308(6)/F 029-3(2)S