


TYPICAL SECTIONS & DESIGN DATA

ITEM 406.25 BITUMINOUS CONCRETE PAVEMENT
LEVELING COURSE TYPE III OR IV (327 TONS/MILE)
AS DIRECTED BY THE ENGINEER
3/4" WEARING COURSE TYPE IV (±1/4)

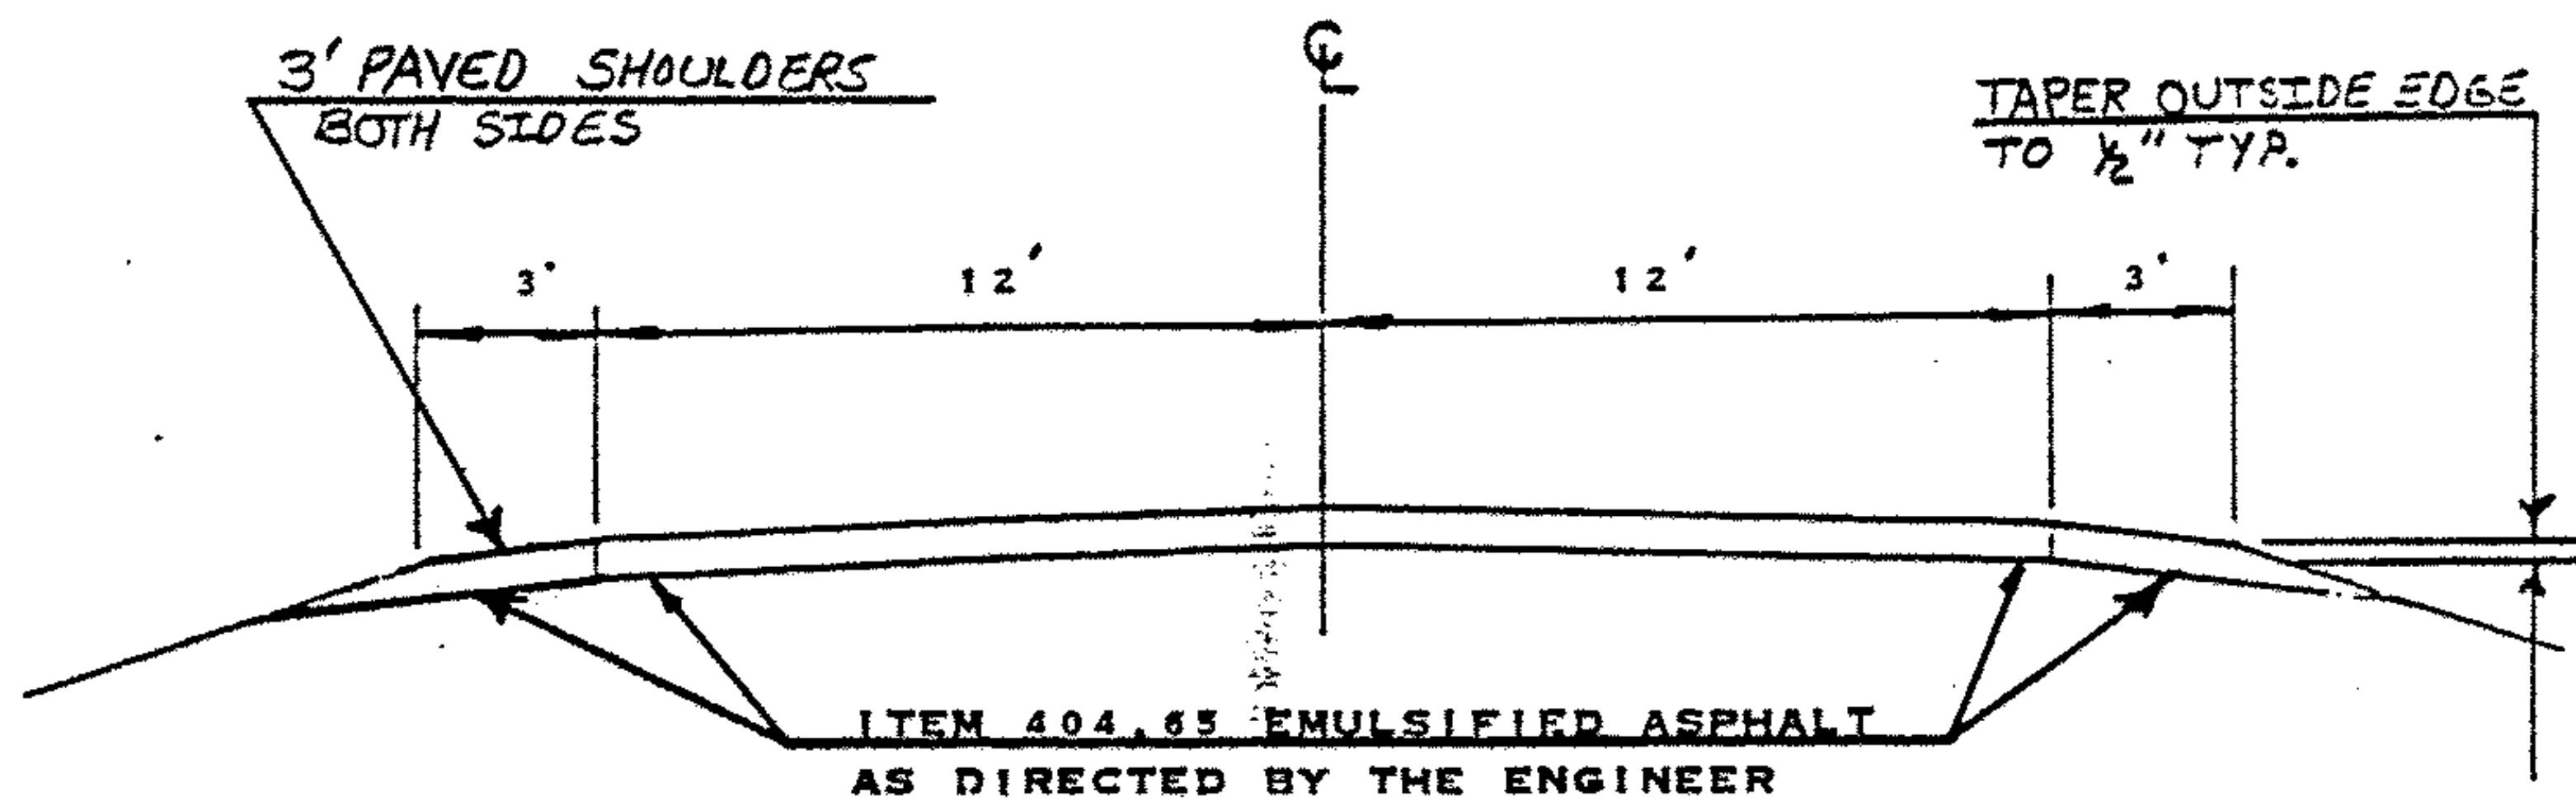

LUDLOW
MM 0.000 MM 3.850
VT 100

1982 ADT 1220
V 50

PROJECT LUDLOW-

NO. HMA 2630

SHEET 5 OF 24 SHEETS