


PROJECT DESCRIPTION AND LOCATION

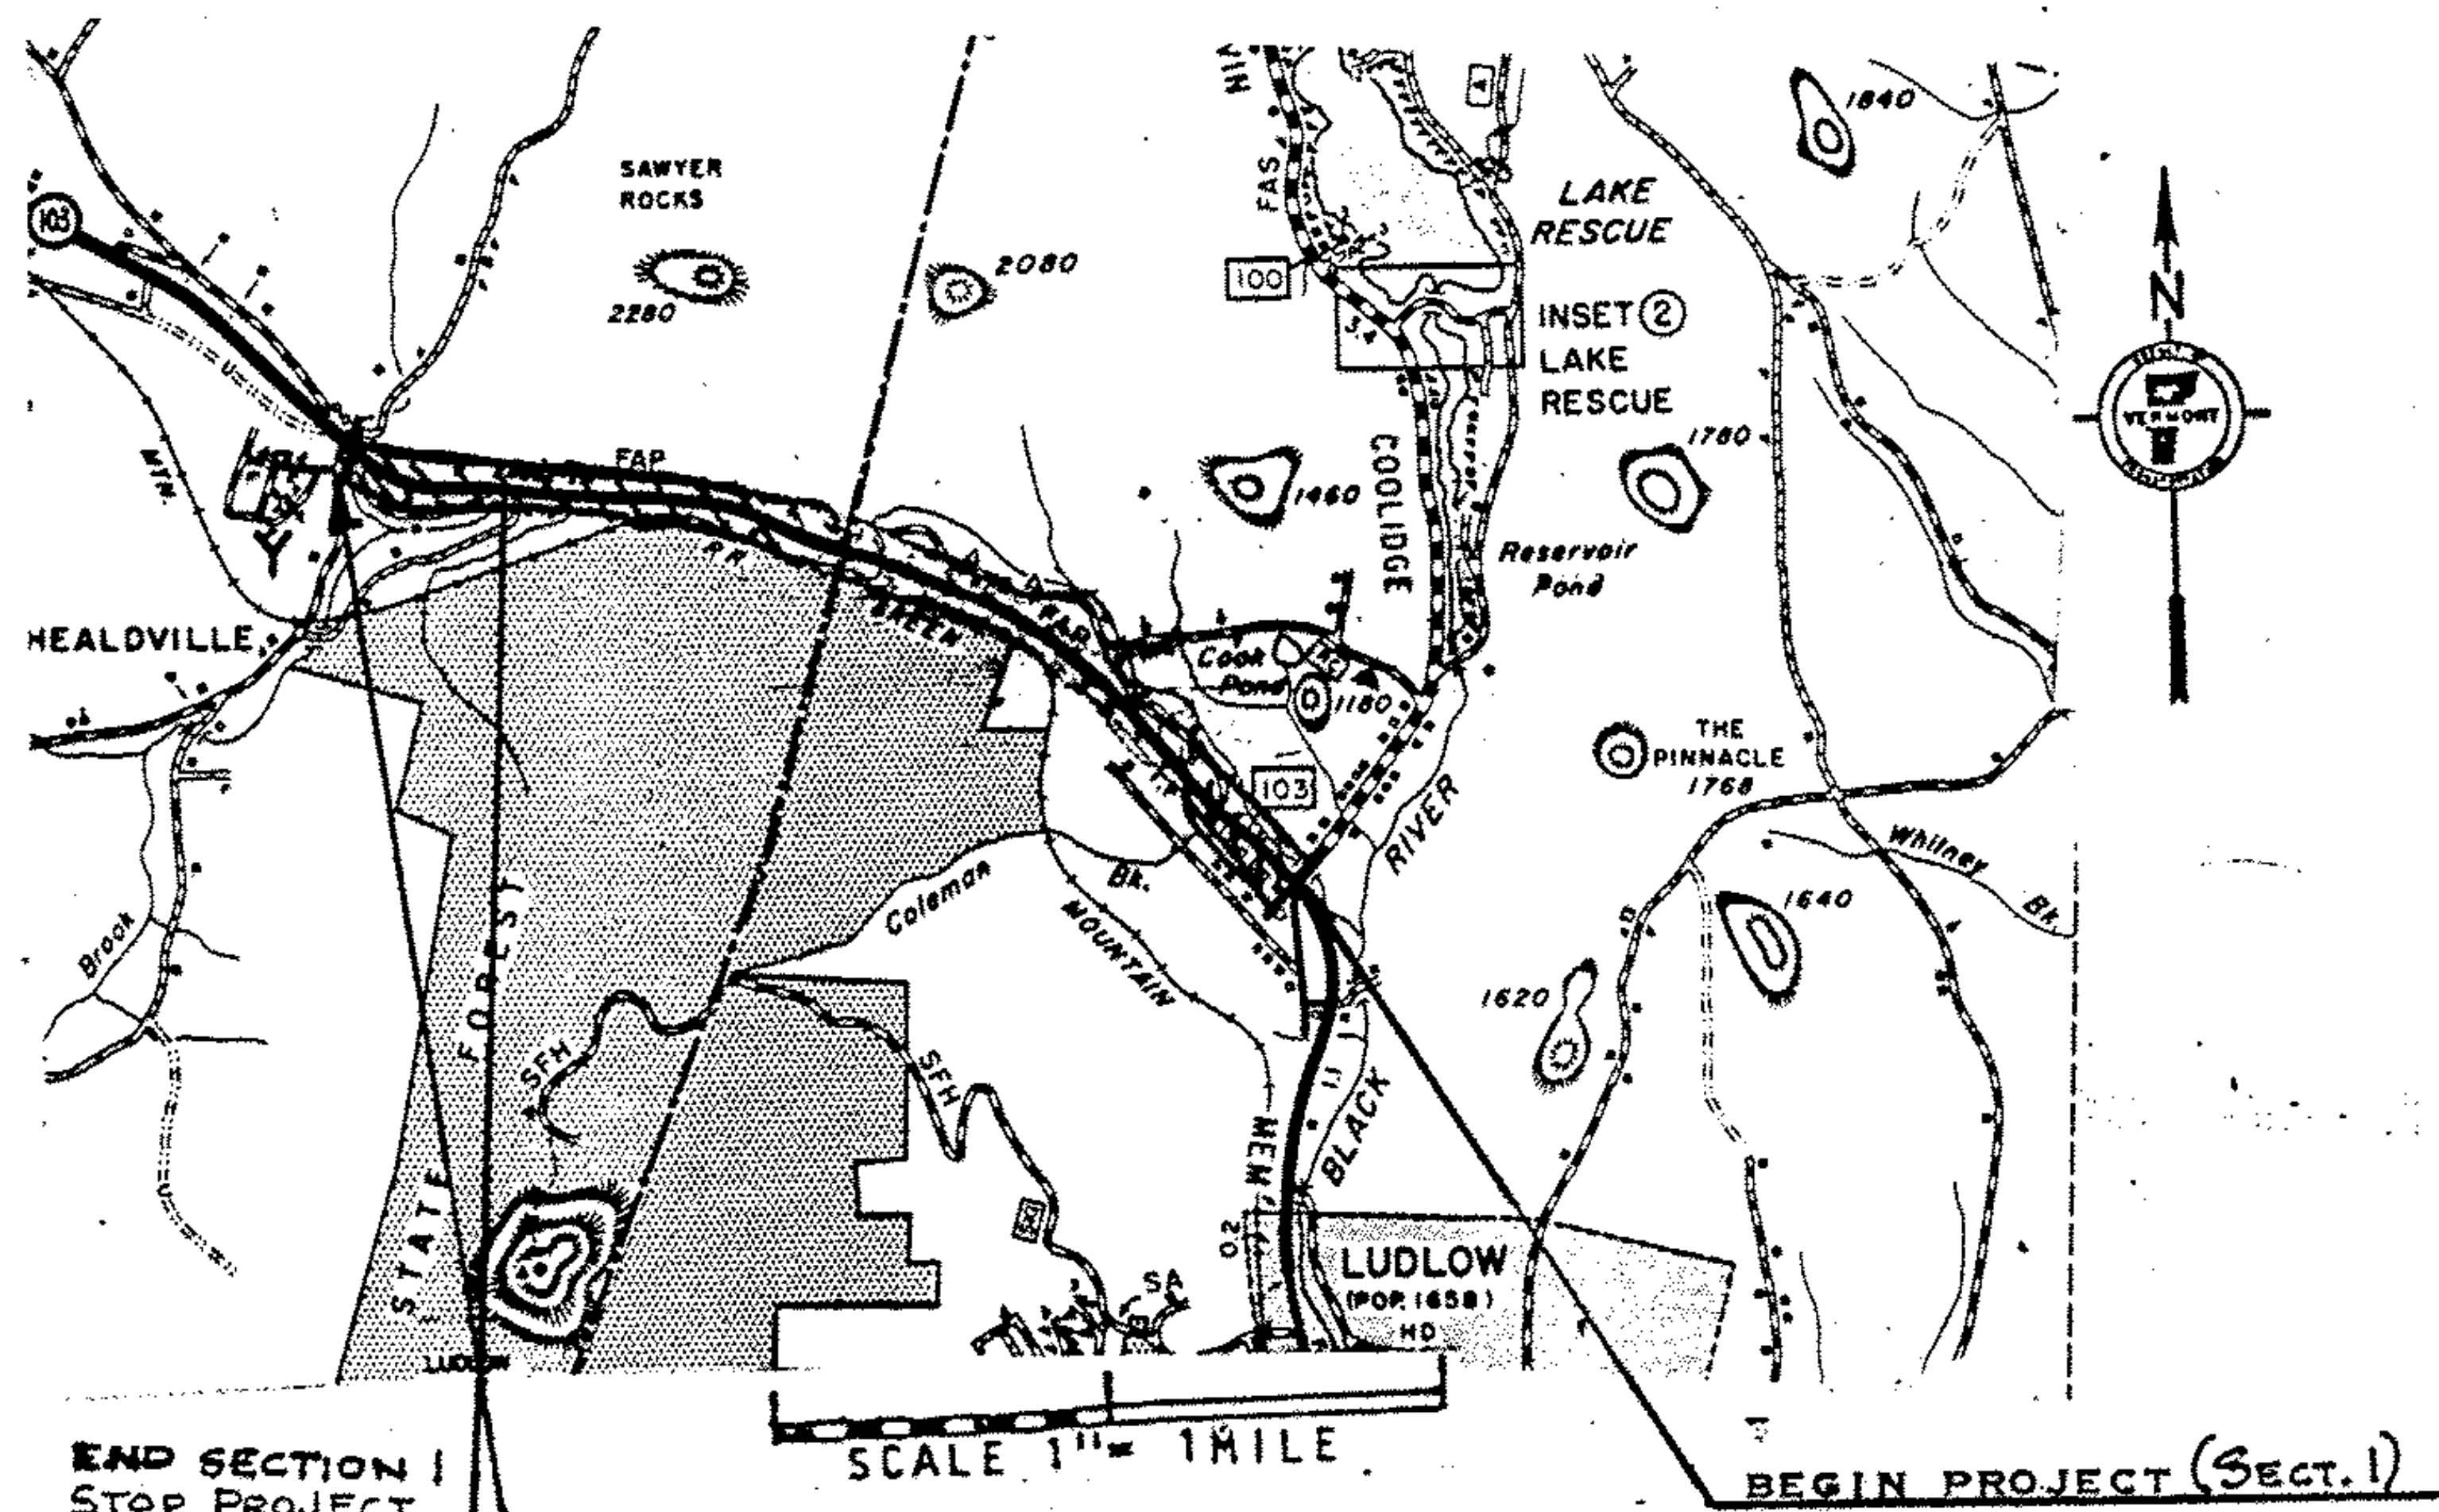

END SECTION I
STOP PROJECT
MM 1.626

BEGIN PROJECT (SECT. I)
MM 4.059

SECTION I

ON VT 103 BEGINNING AT THE JUNCTION OF VT 103 AND VT 100 IN LUDLOW AT
MM 4,059 AND EXTENDING 3.349 MILES TO MM 1.626 IN MT HOLLY

BRIDGE #33
DO NOT PAVE

LENGTH OF SECTION I
3.349 MILES
17683 FEET

NO. F025-1(26)S

PROJECT LUDLOW-MT HOLLY - SHREWSBURY

SHEET 8 OF 24 SHEETS