


# PROJECT DESCRIPTION AND LOCATION

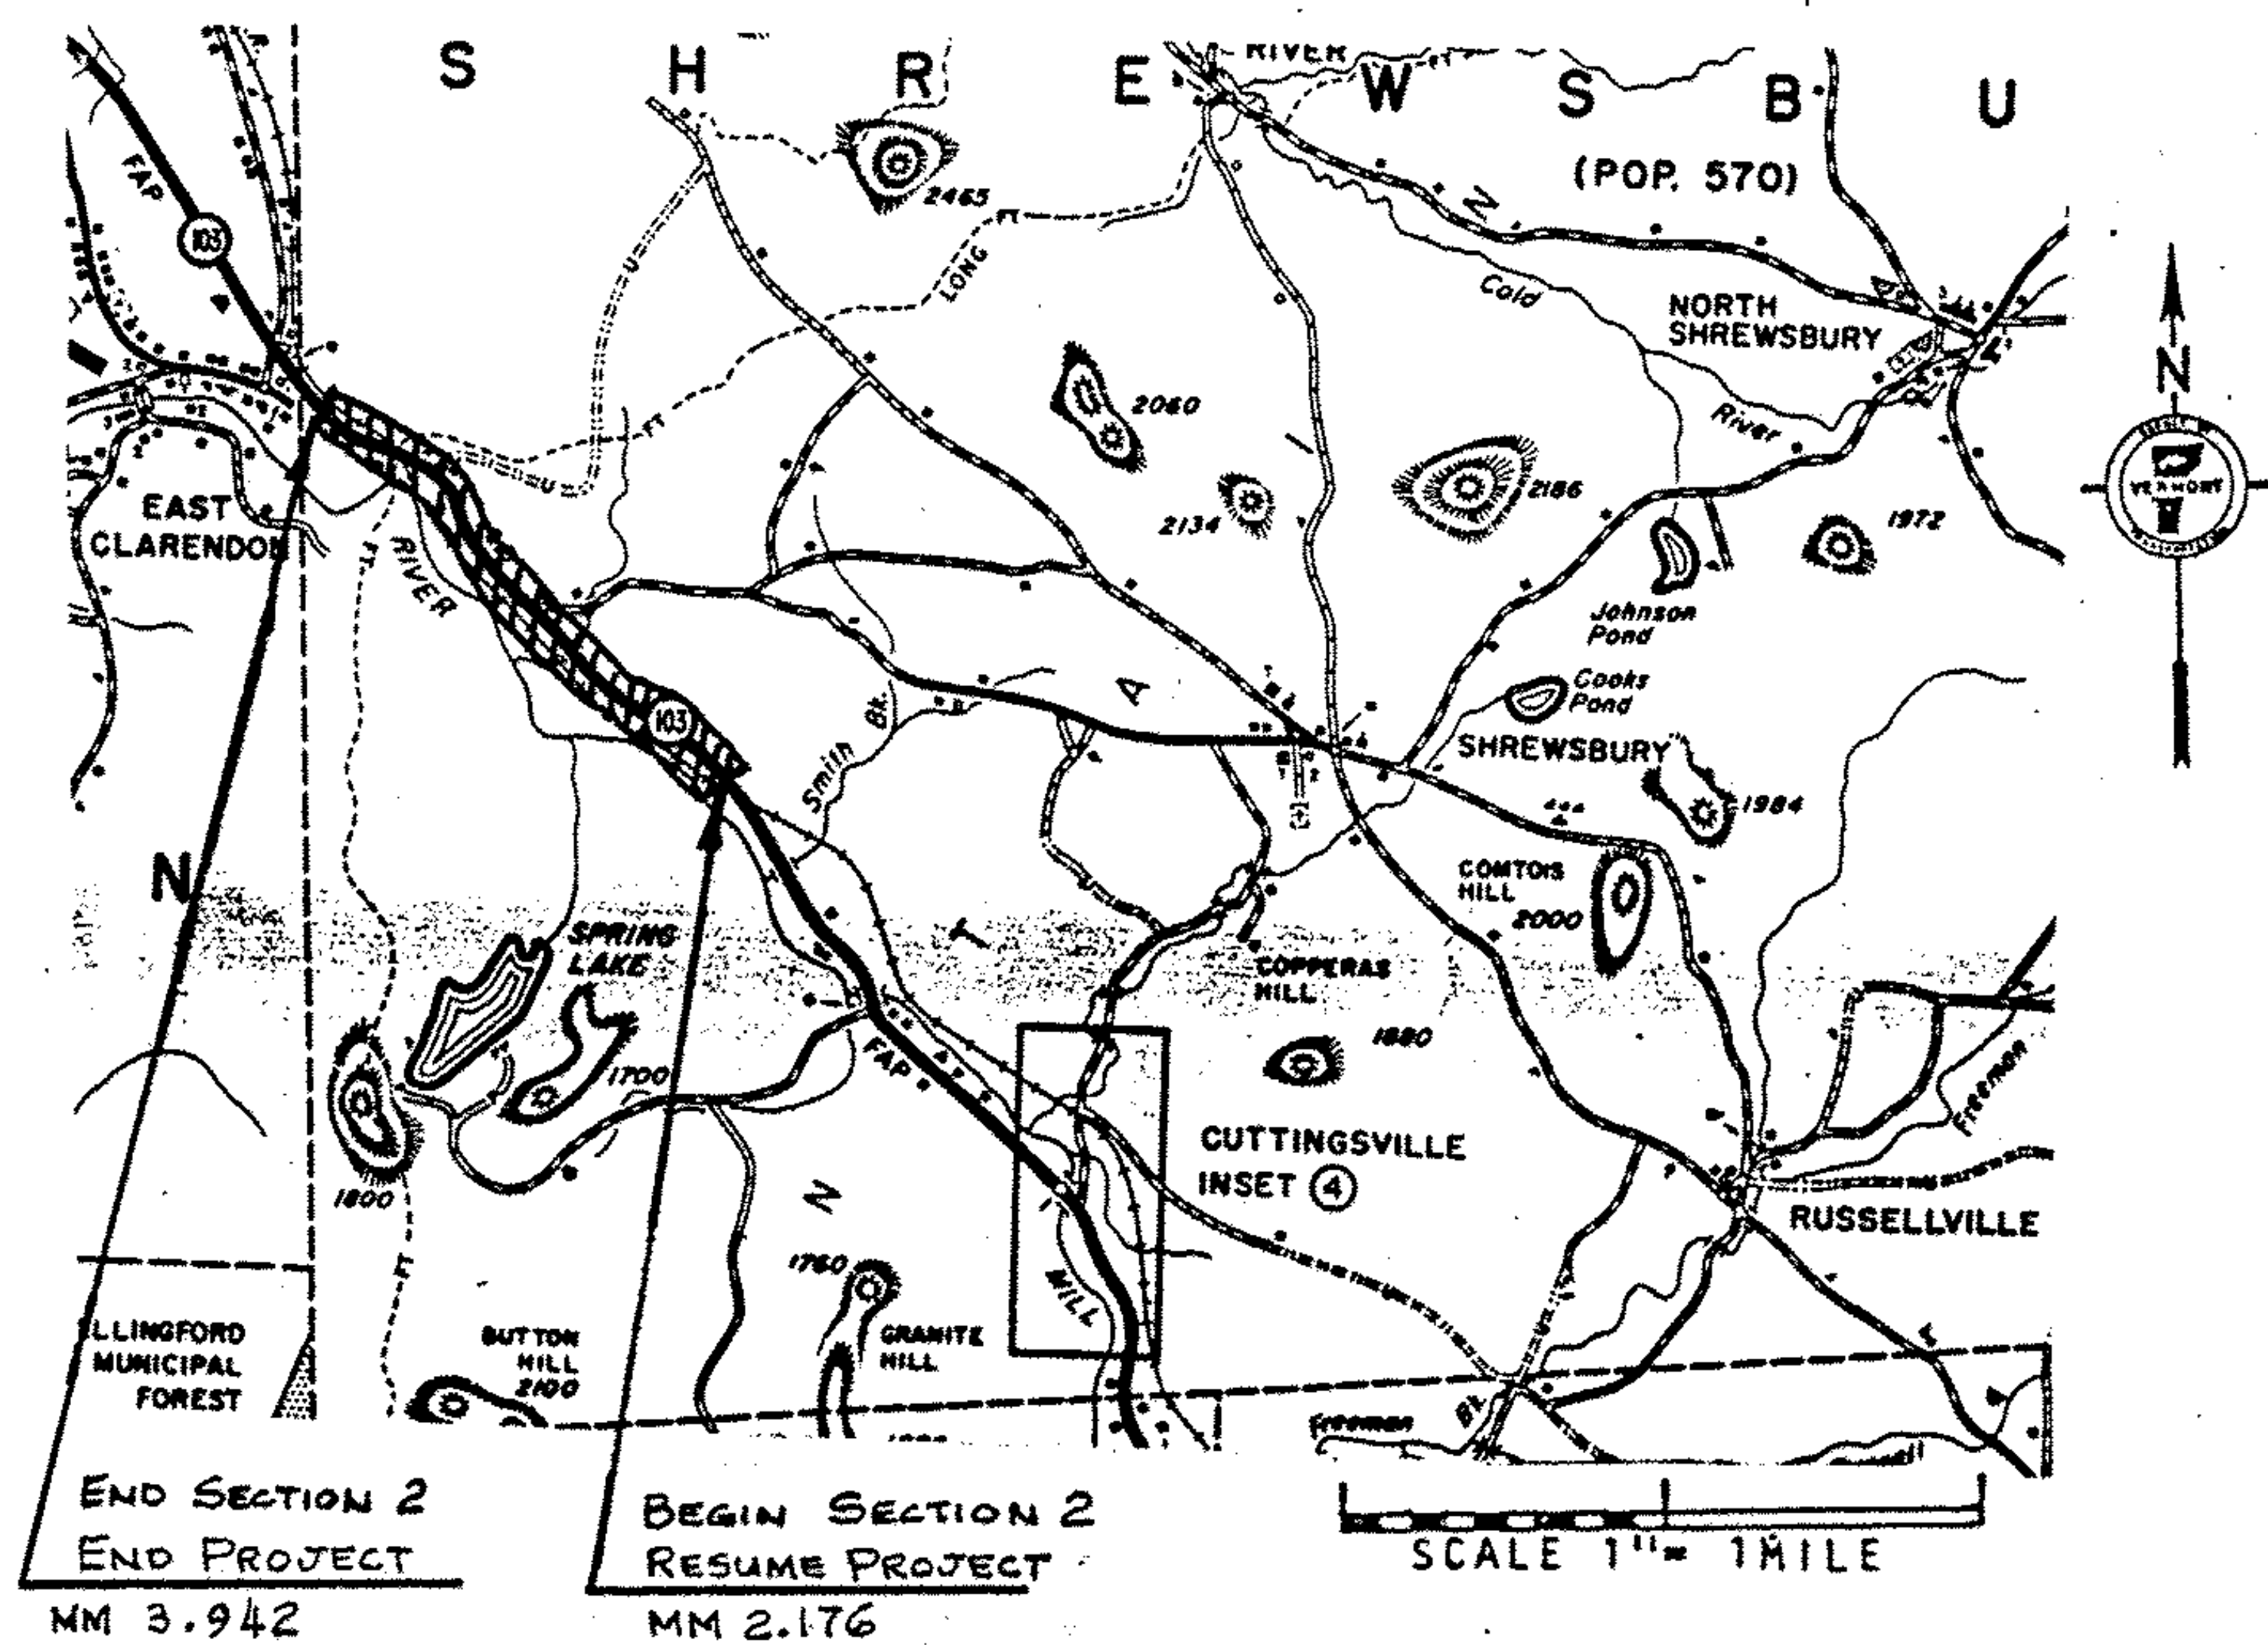

## SECTION 2

ON VT 103-BEGINNING IN THE TOWN OF SHREWSBURY AT MM 2.176 AND  
EXTENDING 1.766 MILES TO MM 3.942

LENGTH OF SECTION 2  
1.766 MILES  
9325 FEET

### LENGTH OF PROJECT

SECT. 1 3.349 MILES  
17683 FEET

SECT. 2 1.766 MILES  
9325 FEET

PROJECT TOTAL = 5.115 MILES  
27008 FEET

LUDLOW - MT. HOLLY -  
PROJECT SHREWSBURY

NO. F025-1(26)S  
SHEET 2 OF 24 SHEETS