


# TYPICAL SECTIONS & DESIGN DATA

ITEM 406.25 BITUMINOUS CONCRETE PAVEMENT  
 LEVELING COURSE TYPE III OR IV (545 TONS/MILE)  
 AS DIRECTED BY THE ENGINEER  
 1" WEARING COURSE TYPE III

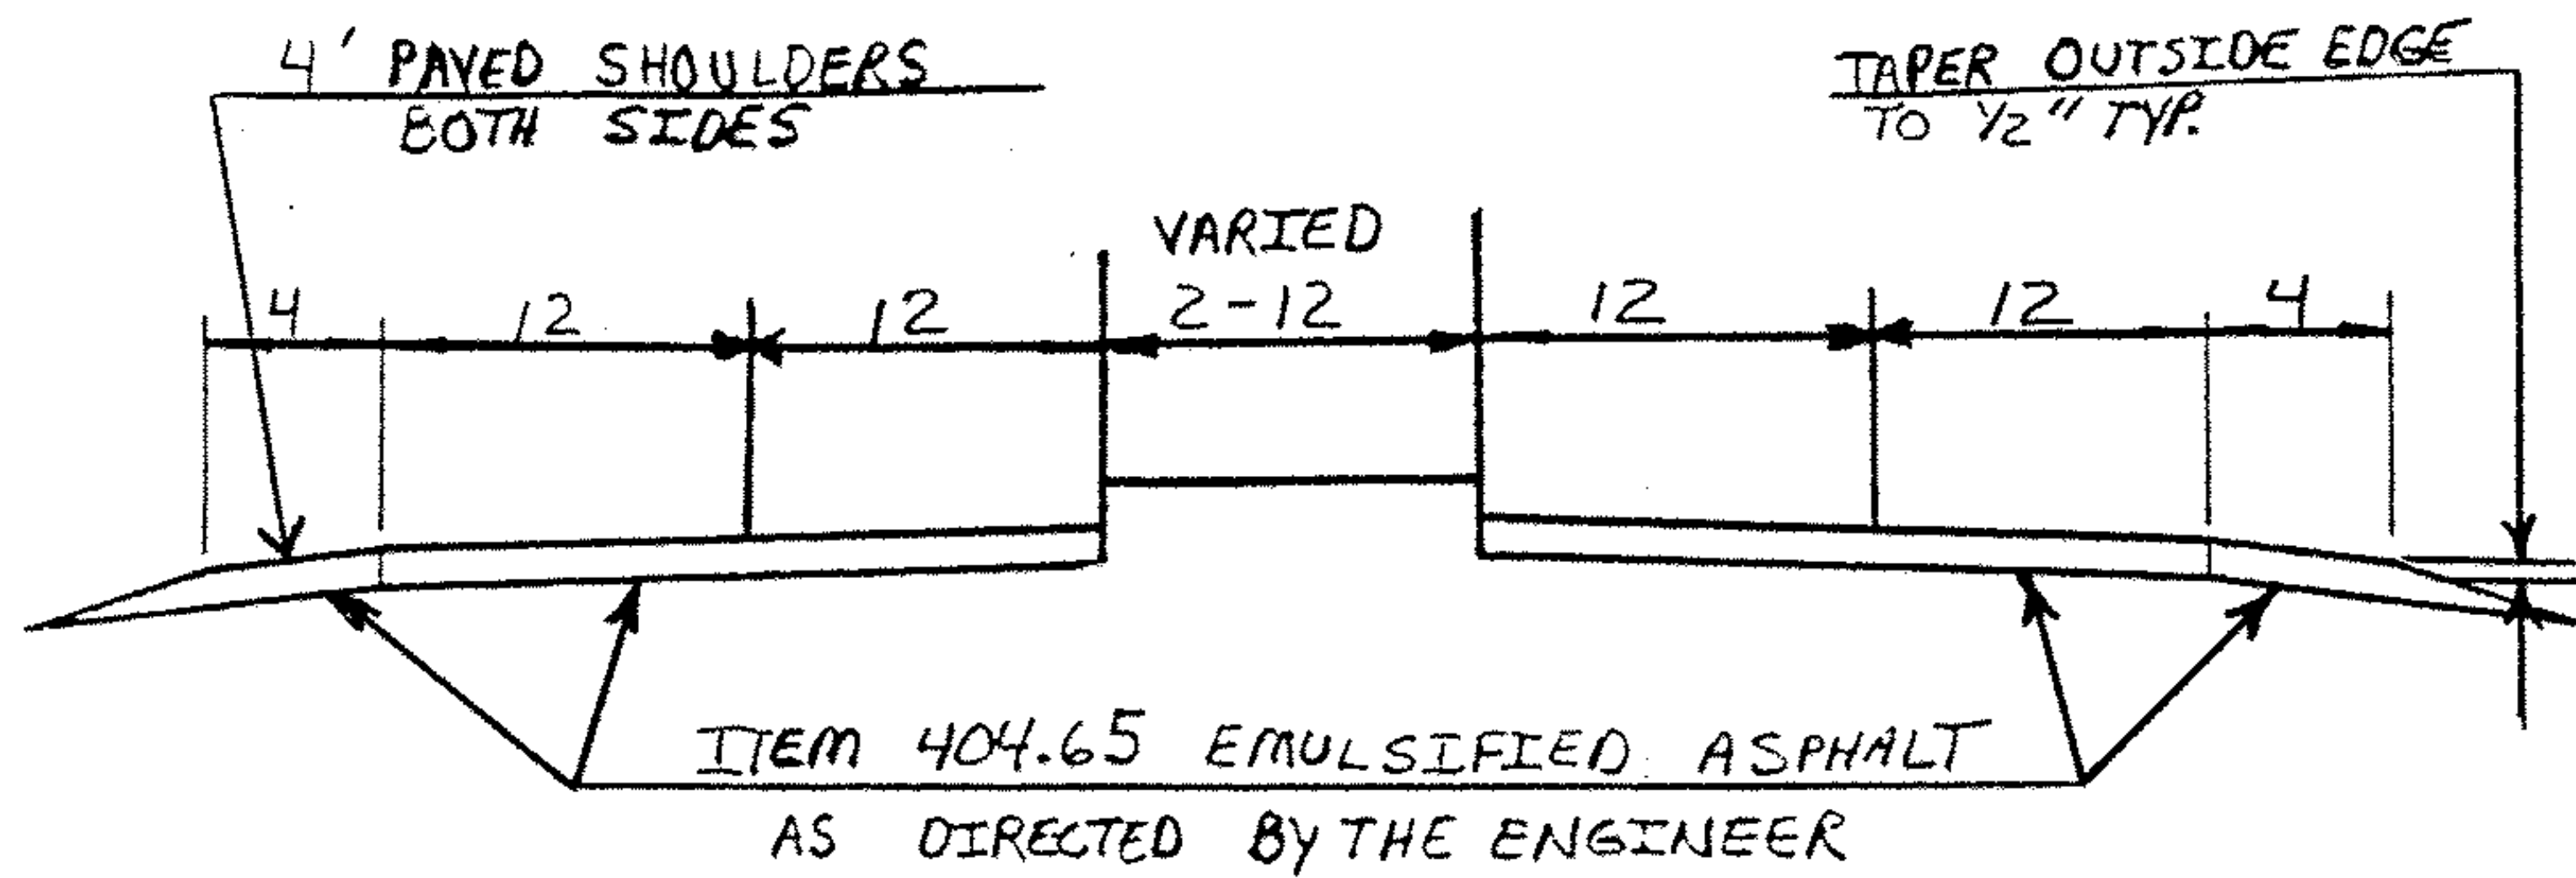

LUDLOW Vt. 103 MM 4.059 ~ MM 4.250

1982 ADT 3130

V = 50