


TYPICAL SECTIONS & DESIGN DATA

ITEM 406.25 BITUMINOUS CONCRETE PAVEMENT
LEVELING COURSE TYPE III OR IV (398 TONS/MILE)
AS DIRECTED BY THE ENGINEER
1" WEARING COURSE TYPE III

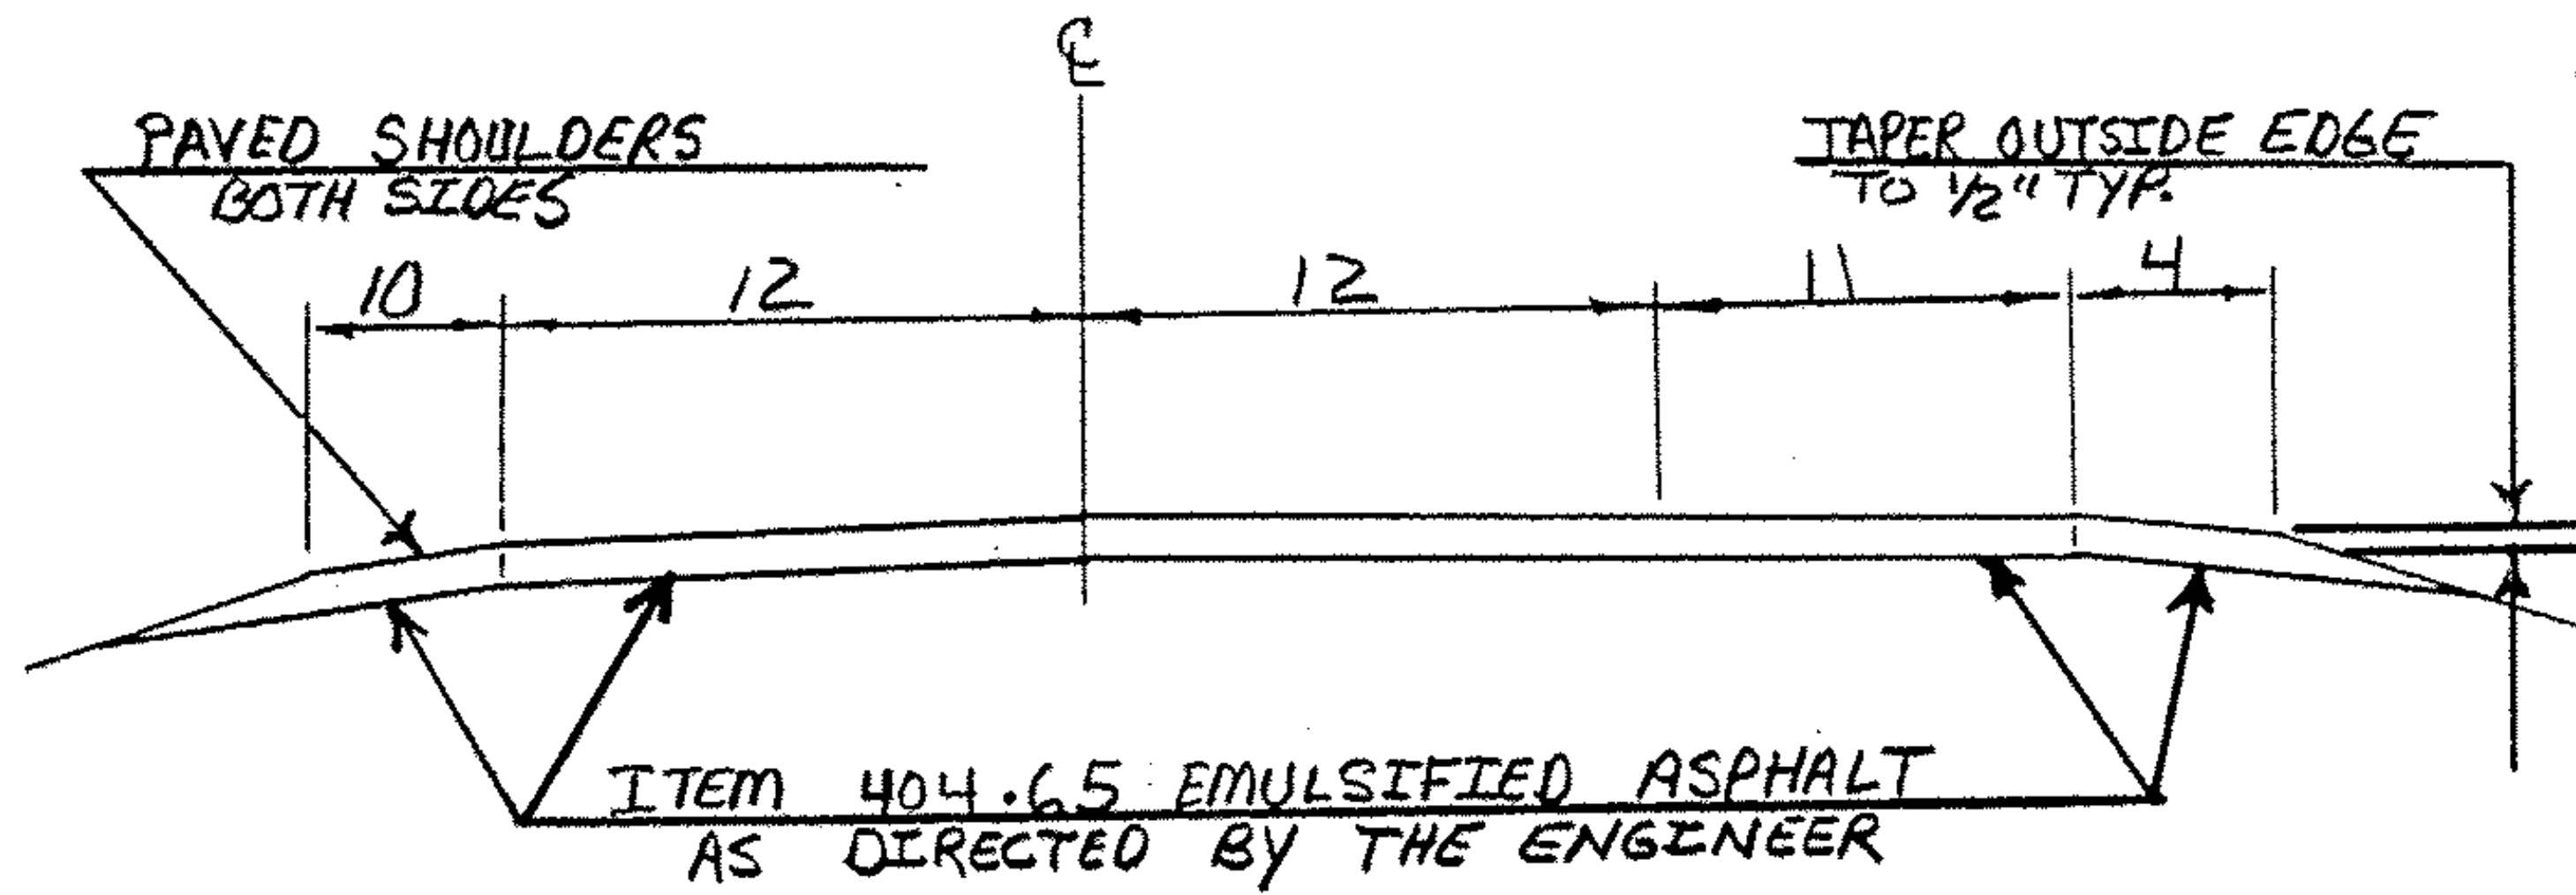

LUDLOW Vt. 103 mm 4.250 ~ mm 5.782

1982 ADT = 3130

v = 50

NO. F025-1(26)S

PROJECT LUDLOW - MT. HOLLY - SHREWSBURY

SHEET 10A OF 24 SHEETS