


TYPICAL SECTIONS & DESIGN DATA

ITEM 406.25 BITUMINOUS CONCRETE PAVEMENT
LEVELING COURSE TYPE III OR IV (273 TONS/MILE)
AS DIRECTED BY THE ENGINEER
1" WEARING COURSE (2 1/4) TYPE III

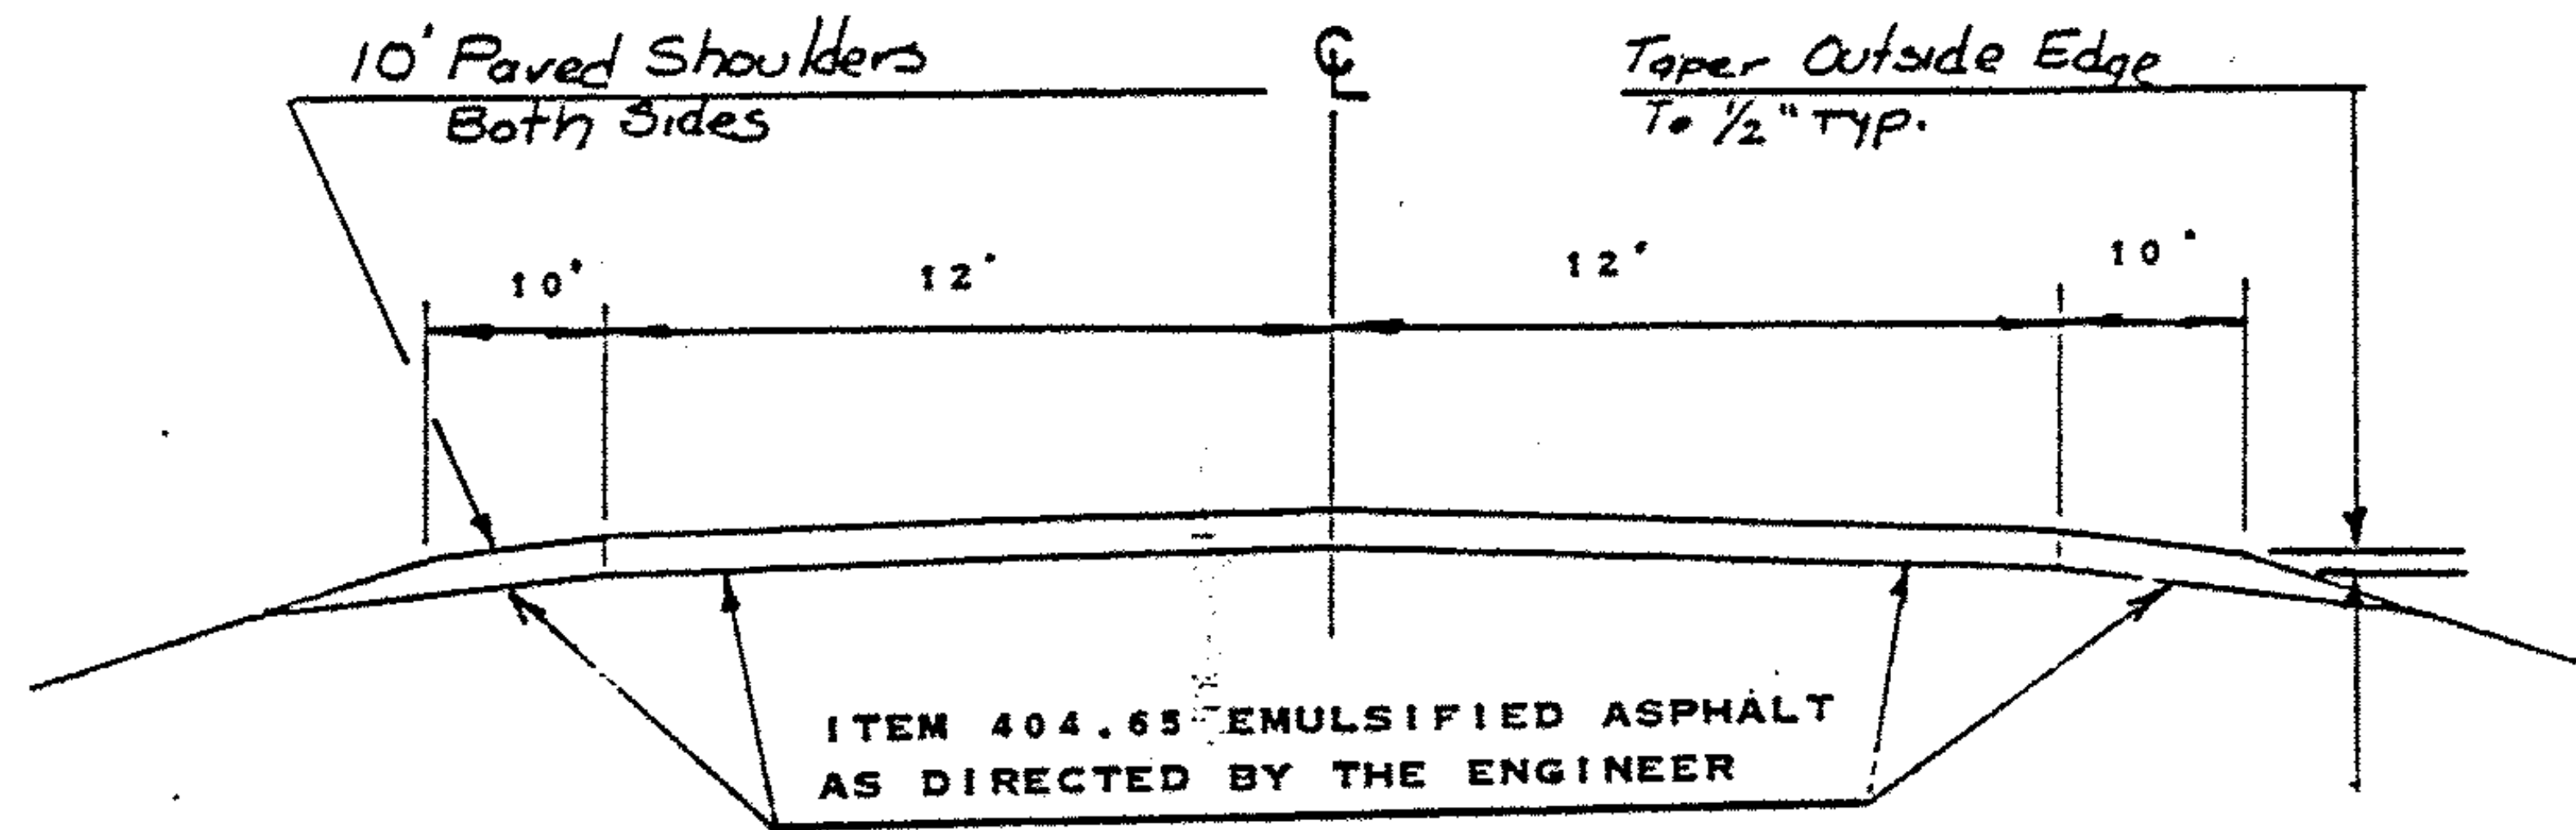

Mt. HOLLY mm 0.000 - Mt. HOLLY MM 1.626
Vt. 103

1980 ADT - 3130
V = 50

PROJECT LUDLOW-MT HOLLY - SHREWSBURY

NO. FO25-1(26)S

SHEET 10 OF 24 SHEETS