



ITEM 406.25 BITUMINOUS CONCRETE PAVEMENT
 LEVELING COURSE TYPE III OR IV (327 TONS/MILE)
 AS DIRECTED BY THE ENGINEER
 1 1/2" WEARING COURSE (21/4") TYPE III

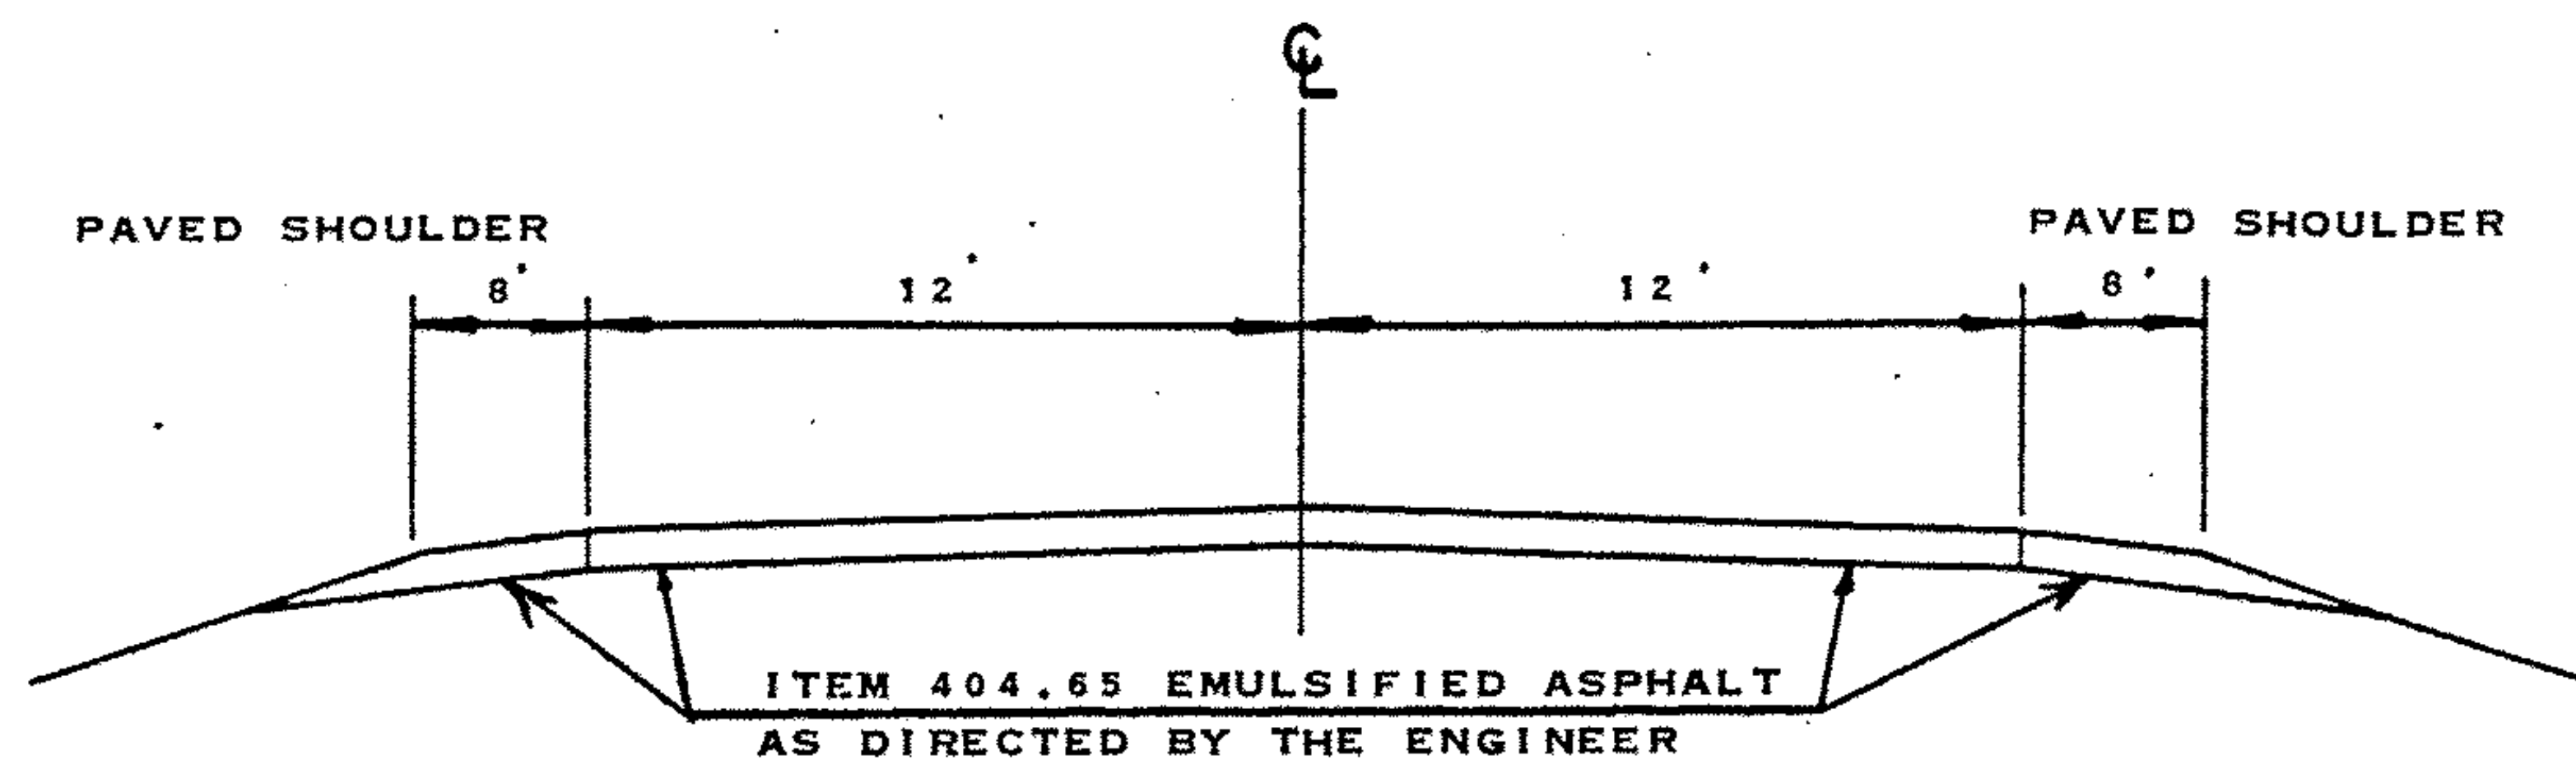

SHREWSBURY
 MM 2.176 MM 3.210

ITEM 406.25 BITUMINOUS CONCRETE PAVEMENT
 LEVELING COURSE TYPE III OR IV (491 TONS/MILE)
 AS DIRECTED BY THE ENGINEER
 1 1/2" WEARING COURSE (21/4") TYPE III

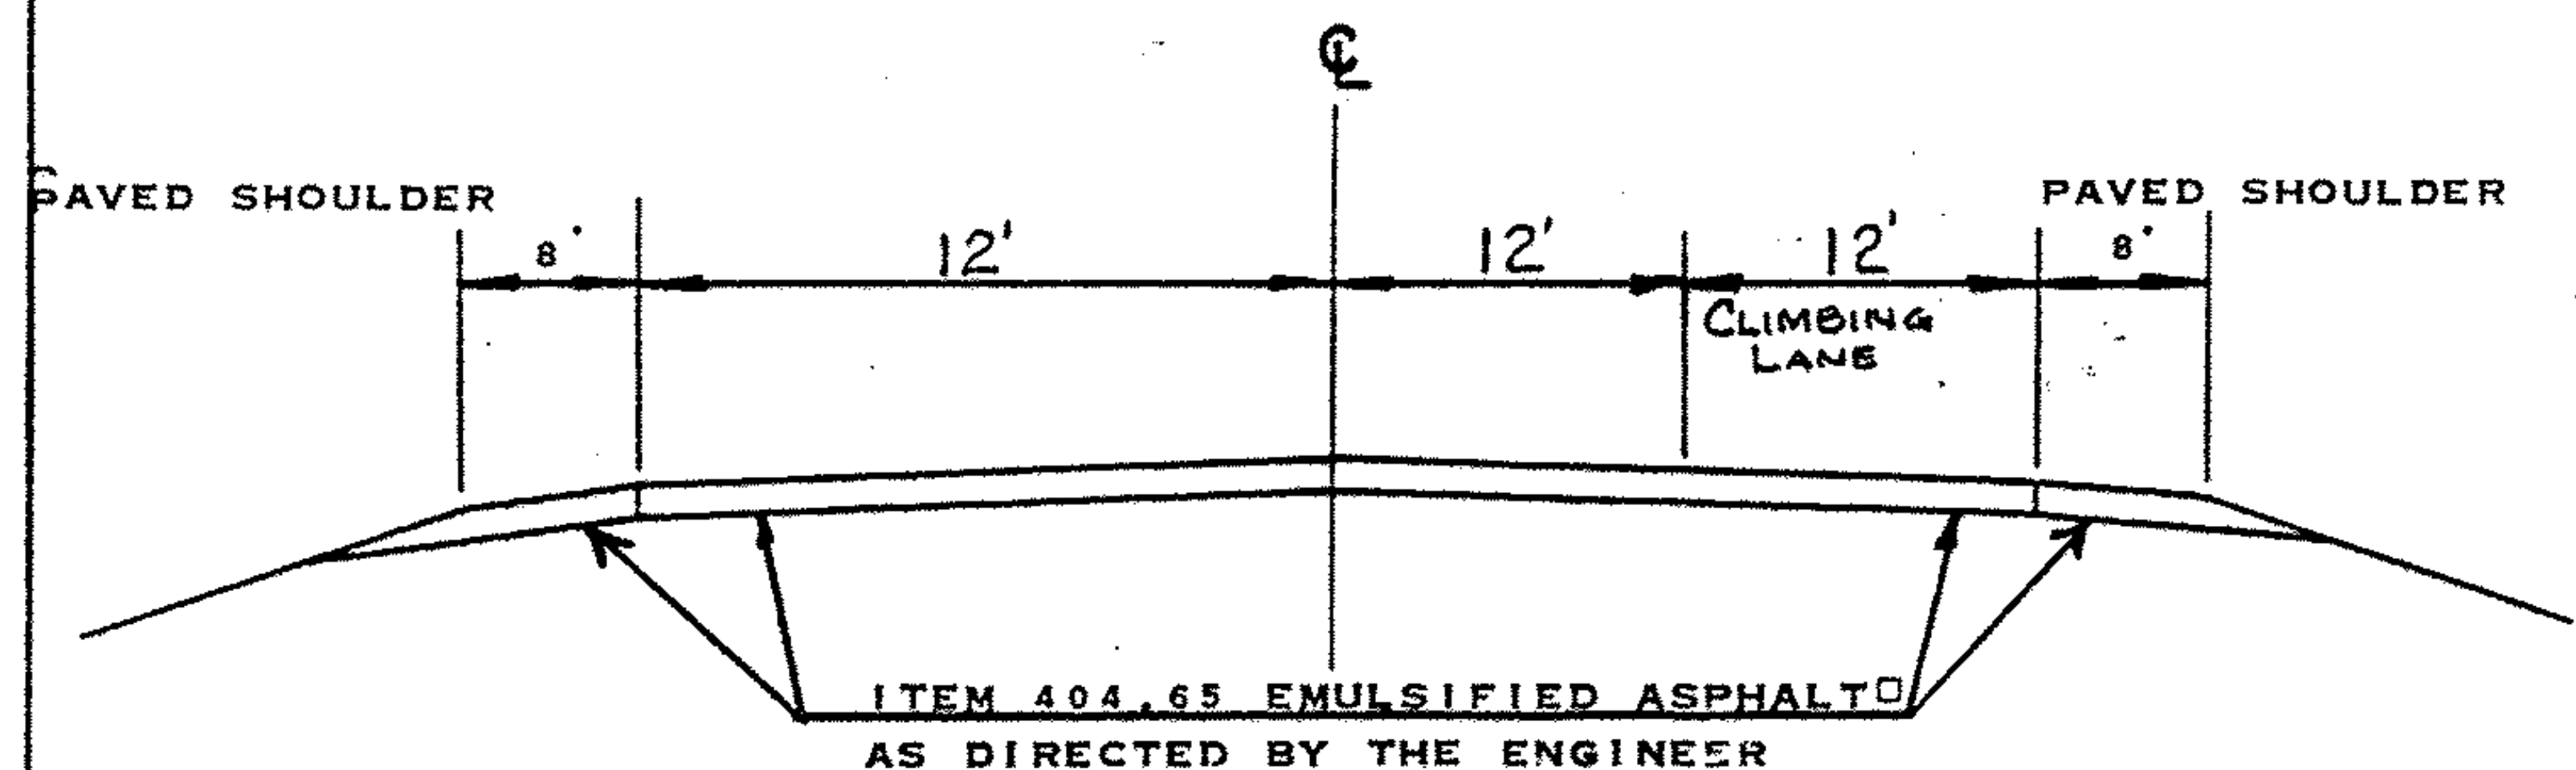

SHREWSBURY
 MM 3.210 MM 3.942

1982 ADT 4680
 V 50

PROJECT LUDLOW-MT. HOLLY-SHREWSBURY

NO. F025-1(26)S
 SHEET 11 OF 24