


DETAILS

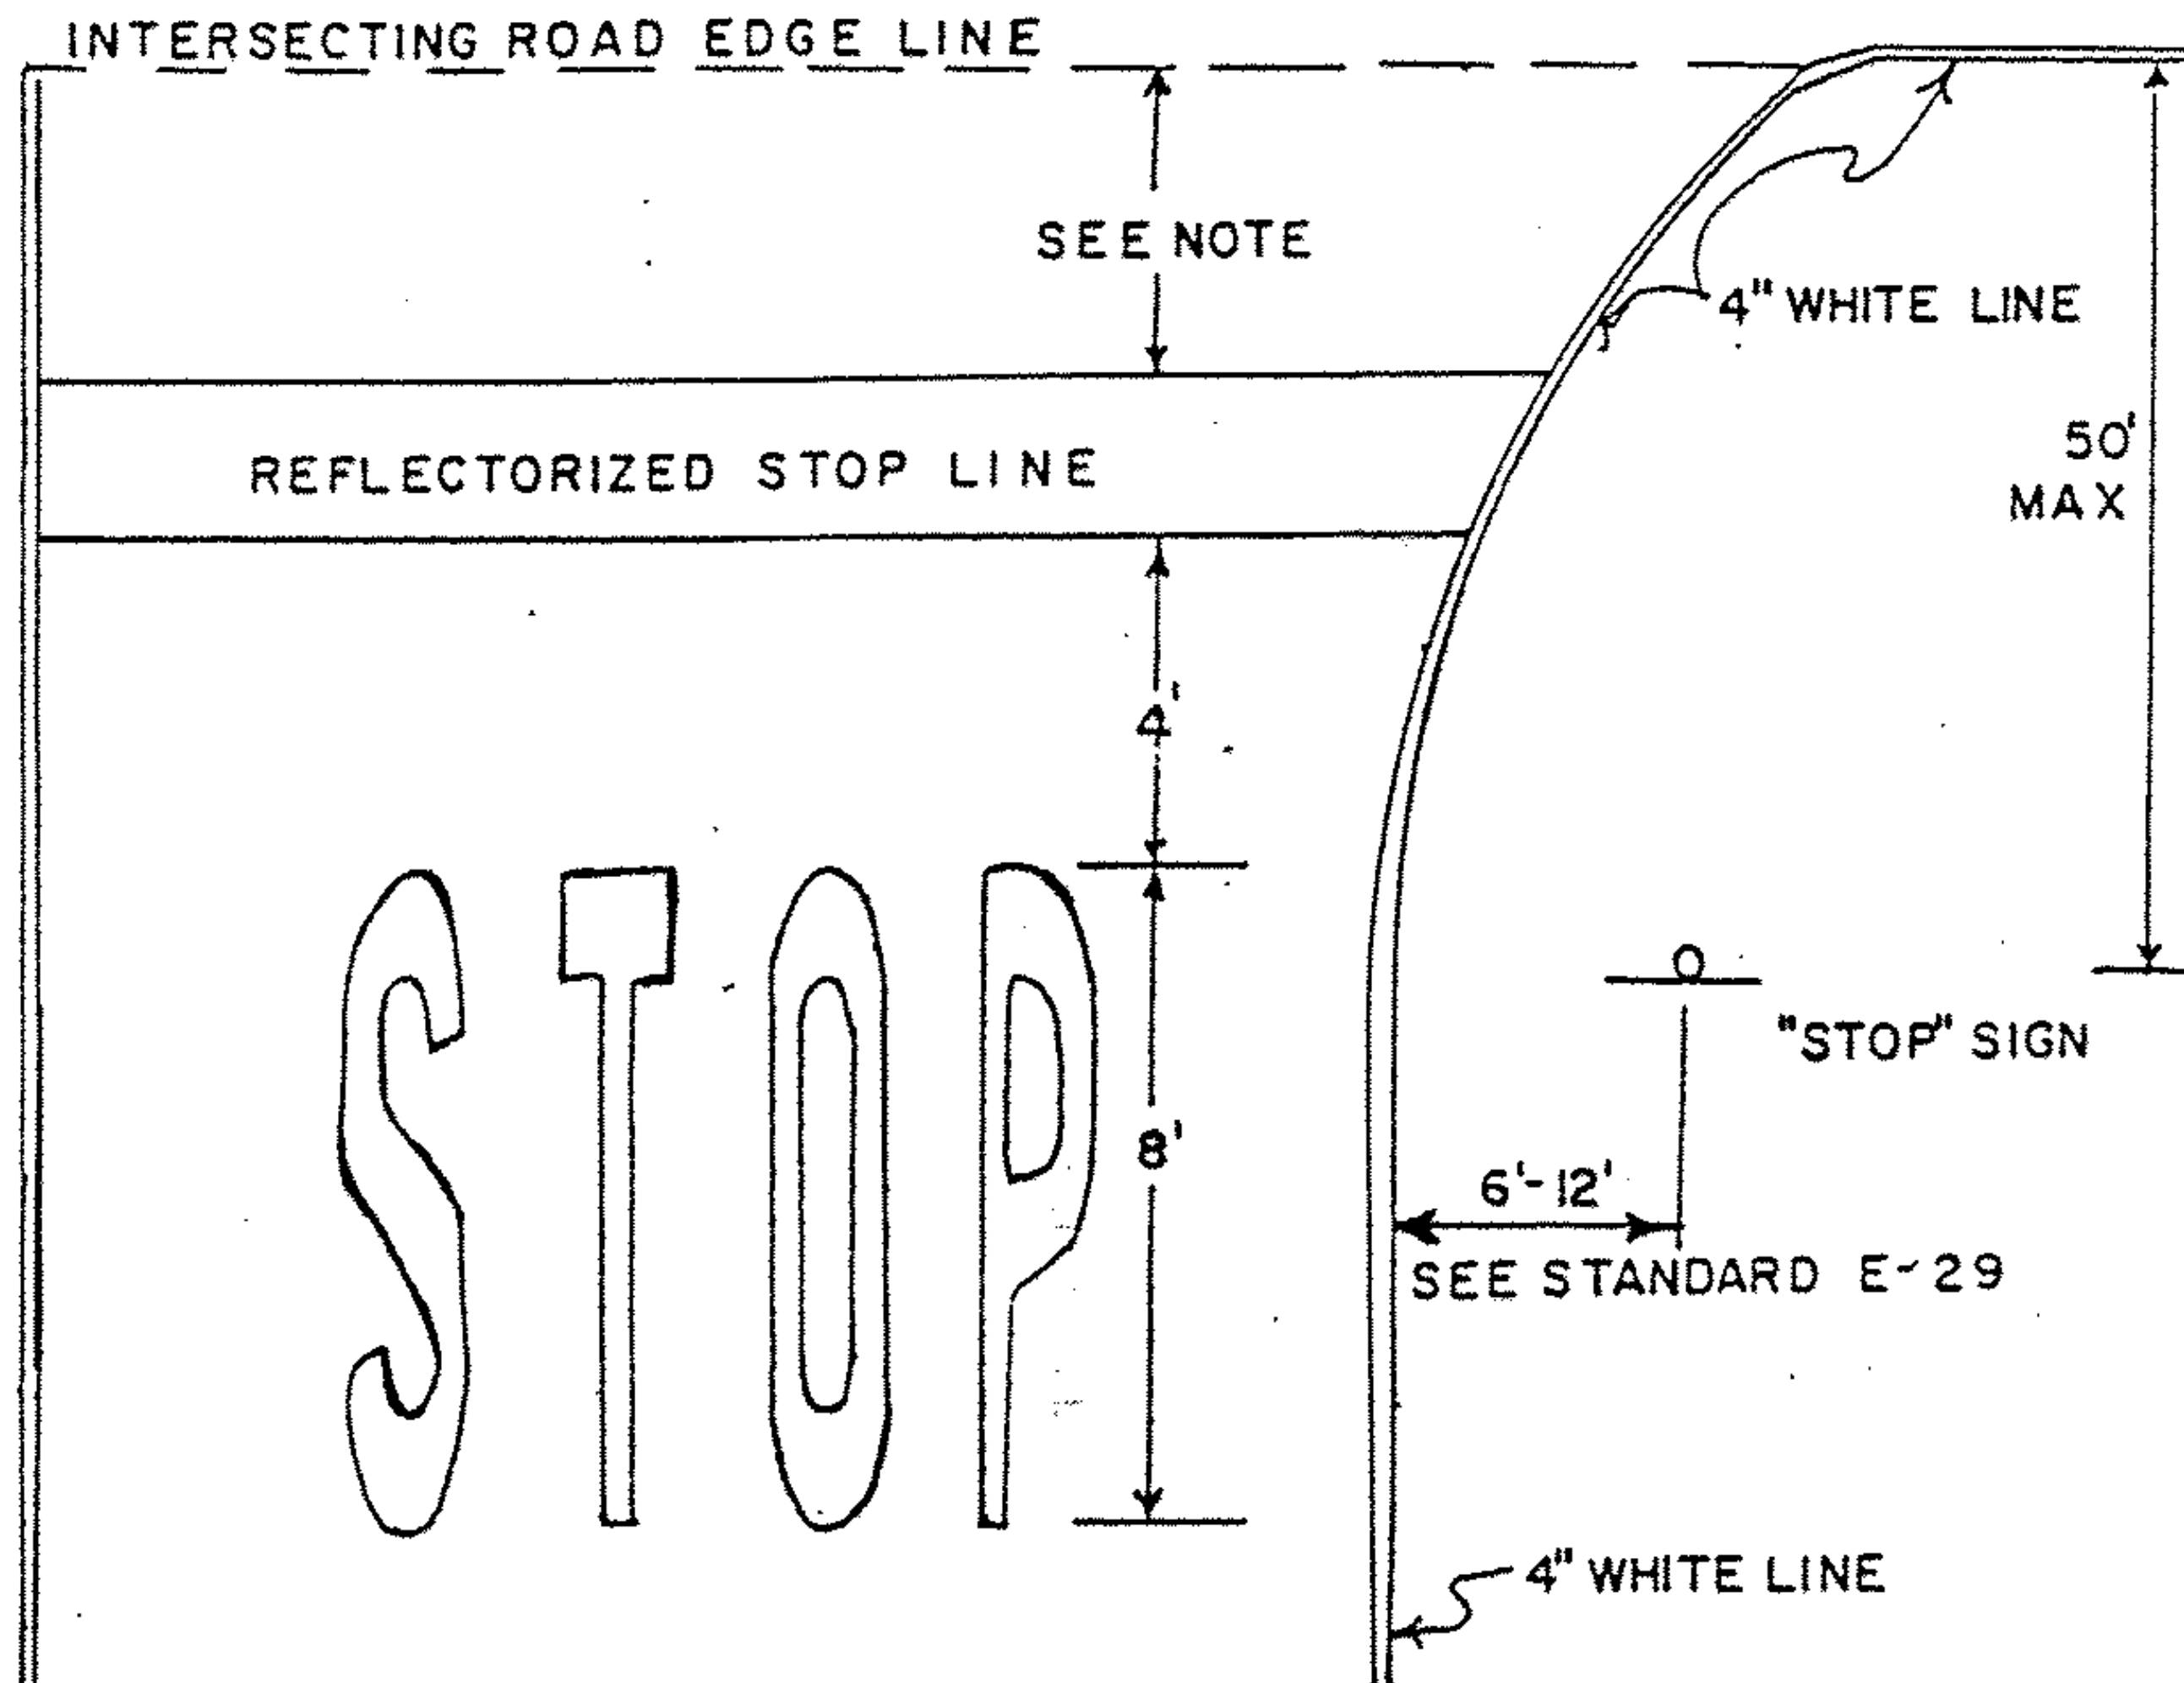

NOTE.

PAVEMENT MARKING DETAILS

1. THE STOP LINE SHOULD BE PLACED AT THE DESIRED STOPPING POINT, IN NO CASE MORE THAN 30 FEET OR LESS THAN 4' FROM THE NEAREST EDGE OF THE INTERSECTING ROADWAY.

PROJECT LUDLOW
LUDLOW-MT HOLLY-SHREWSBURY

NO. HMA 2630
F025-1(26)S
SHEET 17 OF 24 SHEETS