


**TEMPORARY 4\"/>

MM 0920	- 0.965	= 240 LF ± 2
0965	- 1.060	= 500 LF ± 4
1060	- 1.100	= 210 LF ± 2
1110	- 1.113	= 118 LF ± 2
113	- 1.225	= 500 LF ± 4
1225	- 1.266	= 165 LF ± 2
1269	- 1.310	= 220 LF ± 2
1310	- 1.353	= 65 LF ± 2
1331	- 1.390	= 260 LF ± 2
1380	- 1.438	= 312 LF ± 2
1438	- 1.530	= 488 LF ± 2
1530	- 1.577	= 250 LF ± 2
1579	- 1.640	= 338 LF ± 2
1640	- 1.795	= 510 LF ± 2
1795	- 1.950	= 345 LF ± 2

& Lost During SHIMAZING (25)**

TEMPORARY 4\"/>

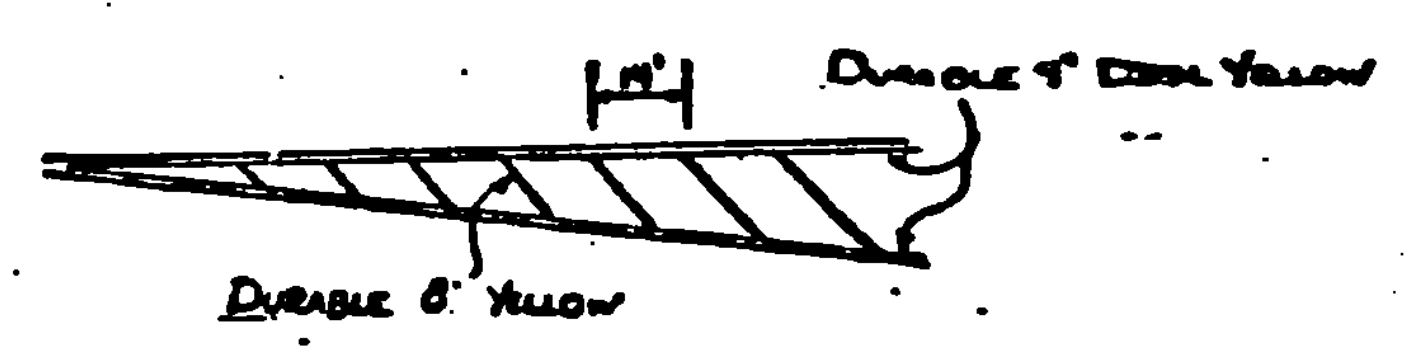


- PAINTED CURB**
- Island - MM 1.06
 - Island - MM 1.10
 - Island - MM 1.12
 - Island - MM 1.24
 - Island - MM 1.26
 - Island - MM 1.28
 - Island - MM 1.55
 - Island - MM 1.94
 - Island - MM 1.95

DURABLE 8\"/>

DURABLE 4\"/>

DURABLE ARROW MARKINGS
 MM 1.12 LT-LT TURN LANE
 MM 1.24 RT-LT TURN LANE
 MM 1.60 LT-LT TURN LANE

DURABLE LETTER IN WORD MARKINGS
 MM 1.12 LT-LT TURN LANE - ONLY, ONLY
 MM 1.24 RT-LT TURN LANE - ONLY, ONLY
 MM 1.60 LT-LT TURN LANE - ONLY, ONLY

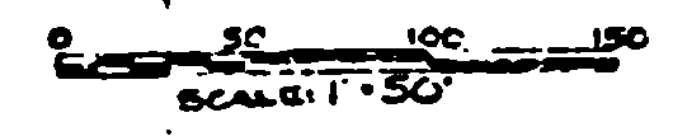

DATUM
 VERTICAL _____
 HORIZONTAL _____

SURVEYED BY	_____	DATE	_____
DRAWN BY	JFM	DATE	_____
TRACED BY	EM	DATE	_____
GEORGIA - U.S. Pr. 7			
PROJ. HMA NO. 2636			
SHEET 14 OF 34			

F023-1(3)S
 SHEET 14 OF 32