


# PROJECT DESCRIPTION AND LOCATION

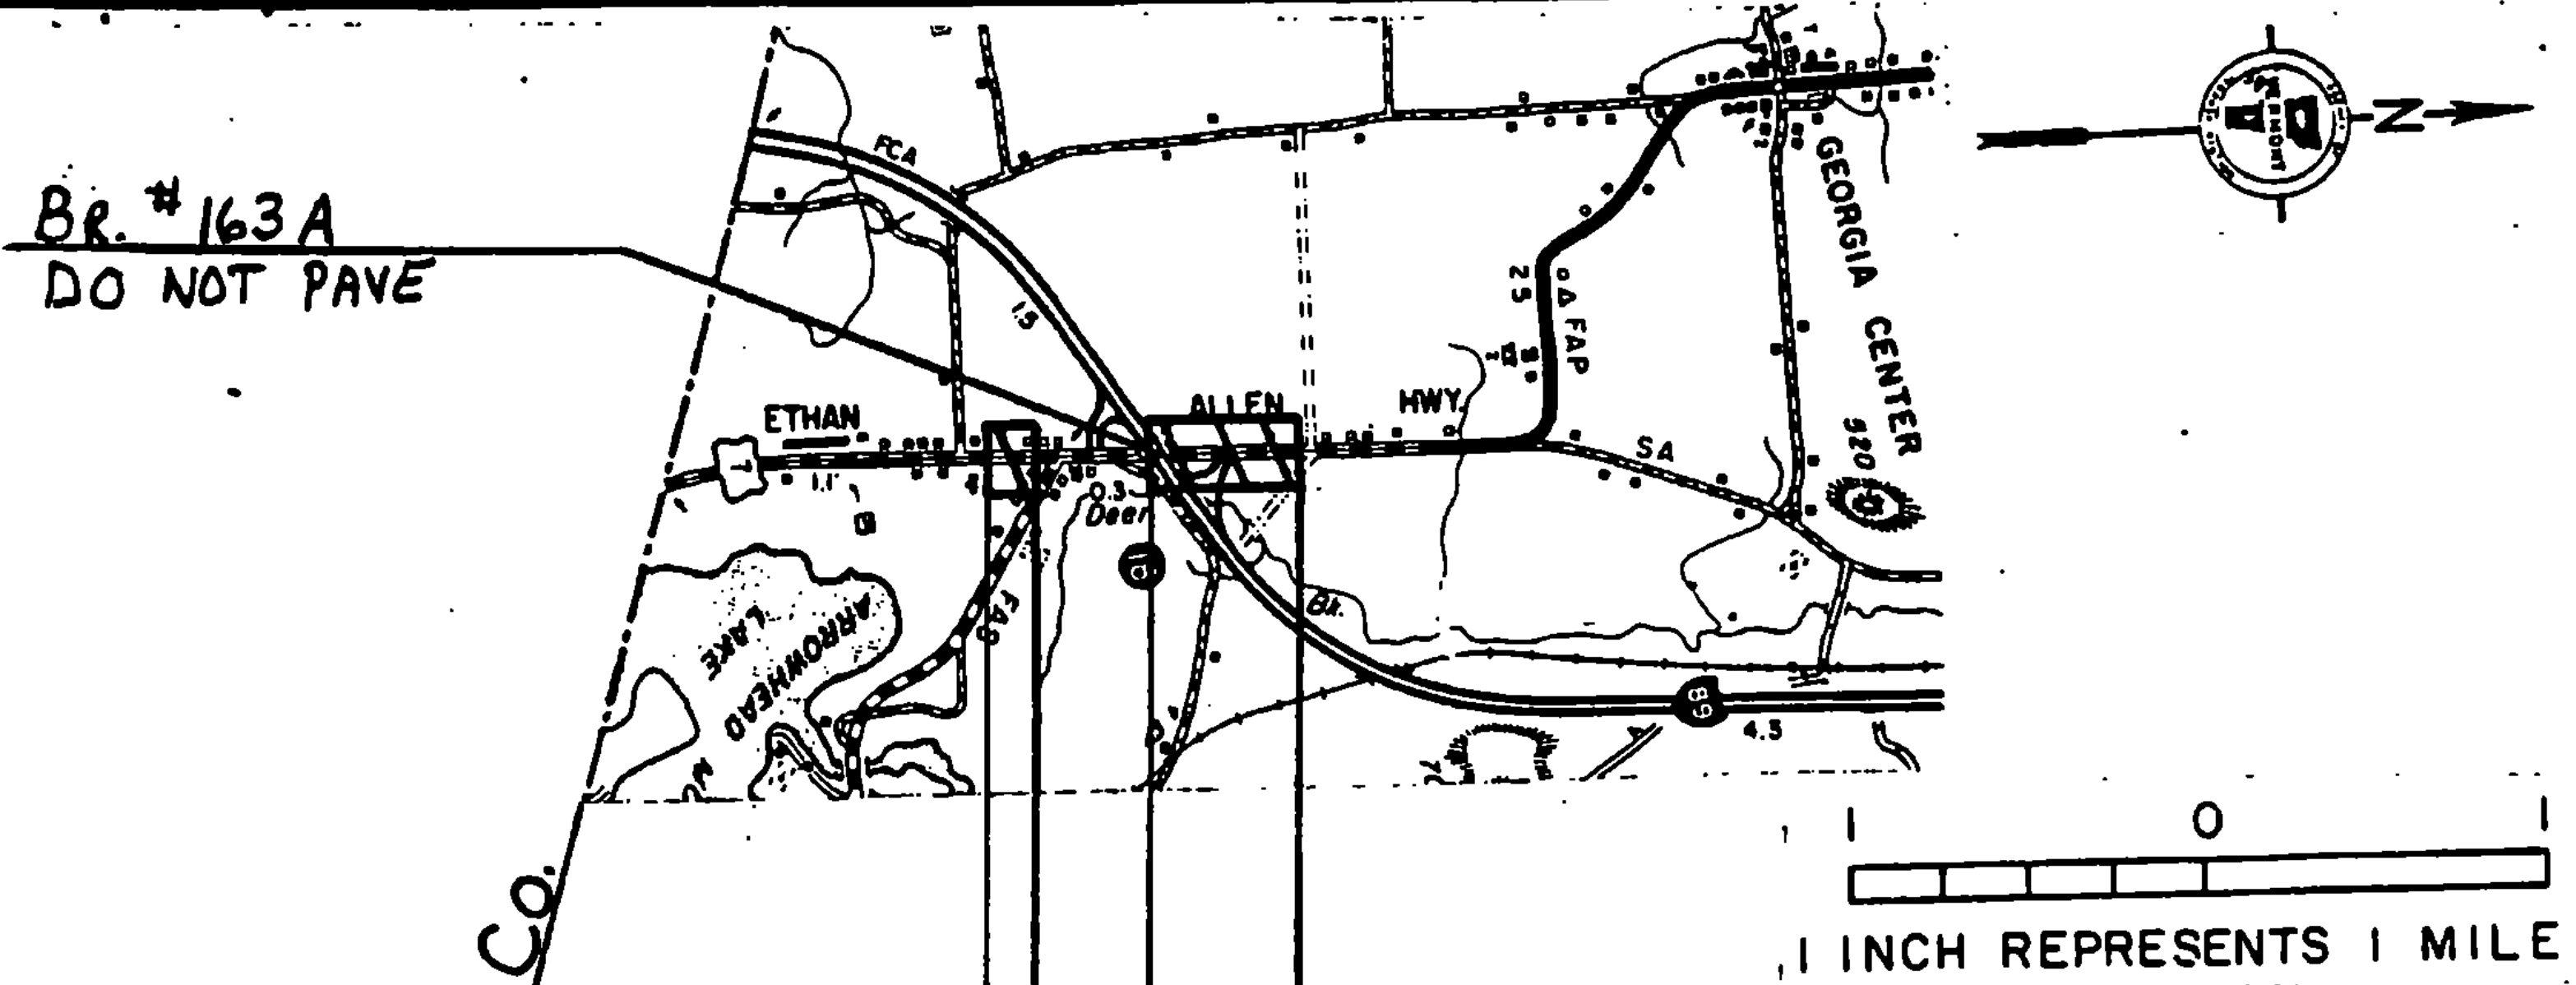

MILTON-CHITENDEN CO.  
 GEORGIA-FRANKLIN CO.

LENGTH OF PROJECT  
 3331 FEET  
 0.631 MILE

TRAFFIC DATA  
 1982 ADT = 2650  
 V = 50 MPH

BEGIN PART 1  
 MM 0.922

END PART 2  
 MM 1.850

END PART 1  
 MM 1.103

BEGIN PART 2  
 MM 1.400

THIS PROJECT IS DIVIDED INTO TWO PARTS - PART 1 BEGINS AT A POINT ON U.S. RTE 7 APPROX. 1 MILE NORTH OF THE MILTON-GEORGIA TOWN LINE AT MM 0.922 AND EXTENDS TO MM 1.103. PART 2 BEGINS AT MM 1.400 AND EXTENDS TO MM 1.850.