


TYPICAL SECTIONS & DESIGN DATA

ITEM 406.25 BITUMINOUS CONCRETE PAVEMENT
LEVELING COURSE, TYPE III OR IV (48' WIDE @ 655 TONS/MI.)
AS DIRECTED BY THE ENGINEER
1" WEARING COURSE, TYPE III

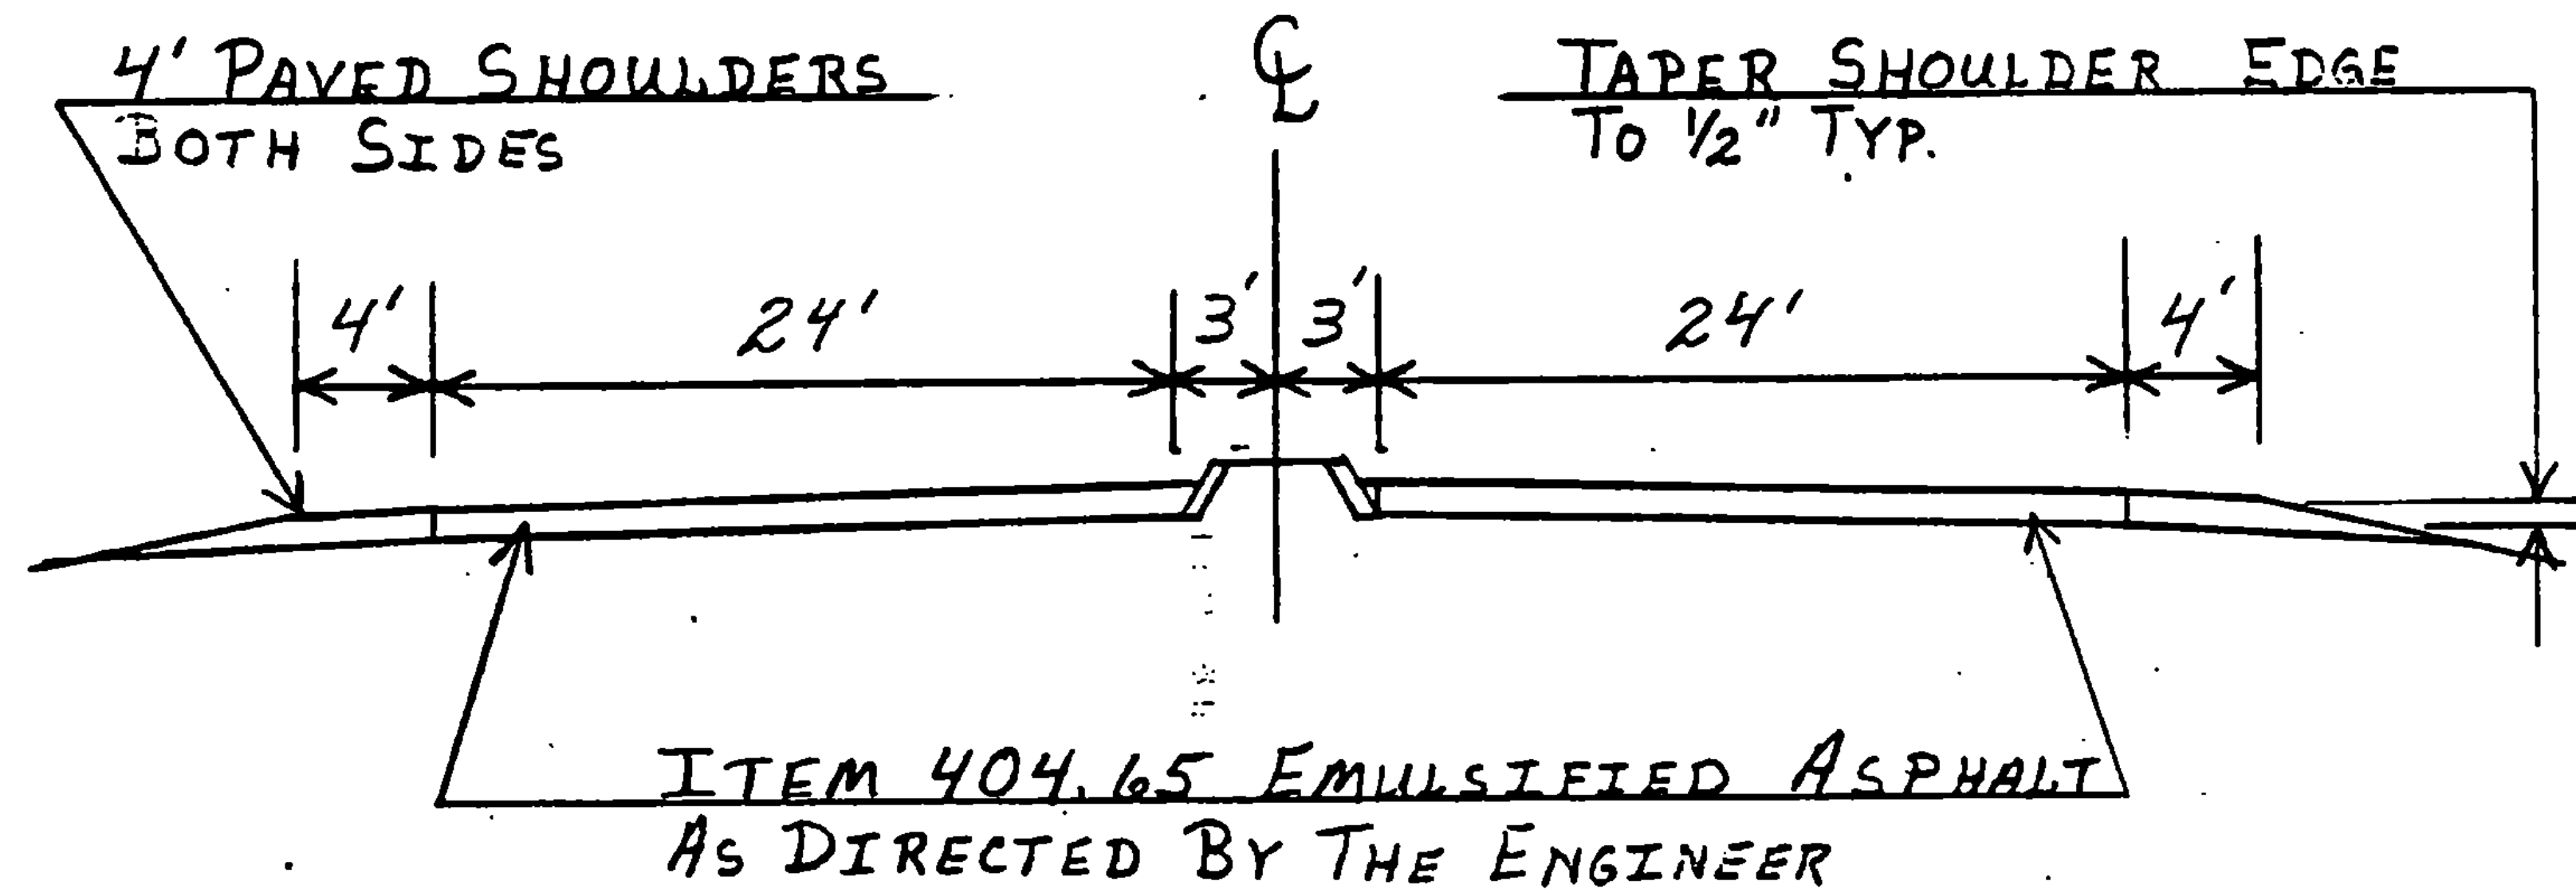

ST. ALBANS MM 0.085~0.221