


PROJECT DESCRIPTION AND LOCATION

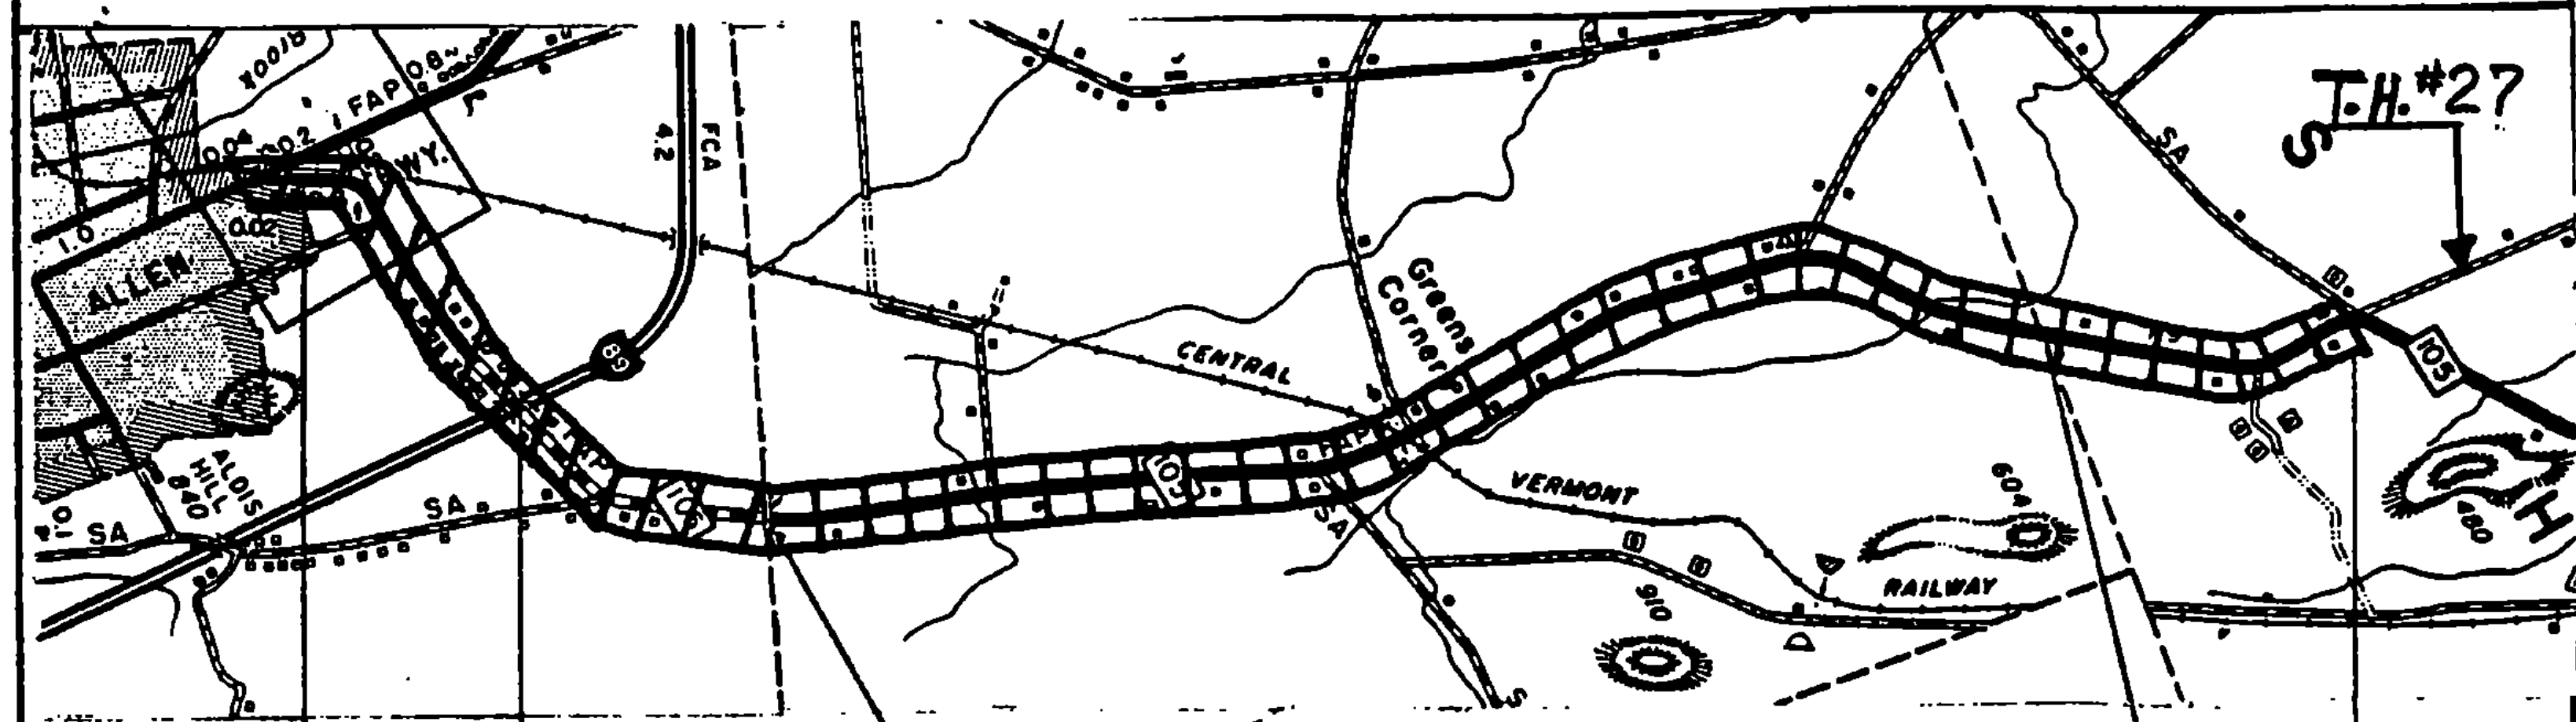

BRIDGE # 1
DO NOT PAVE

T/L SWANTON MM 3.900
L SHELDON MM 0.000

SWANTON MM 0.00
ST ALBANS TOWN MM 1.929 T/L

BEGIN PROJECT T/L
MM 0.000-ST. ALBANS TOWN
MM 0.023 ST. ALBANS CITY

END PROJECT
MM 0.960-SHELDON

SEGMENT # 1

BEGINNING AT A POINT ON VT. RTE. 105, MM 0.000 (ST ALBANS TOWN) ABOUT 1/10 MI. EASTERLY OF THE JCT. OF U.S. RTE. 7 AND VT. RTE. 105, AND PROCEEDING EASTERLY A DISTANCE OF 6.789 MILES TO SHELDON MM 0.960-INTERSECTION OF TOWN ROAD 27 AND VT. RTE. 105.

LENGTH OF SEGMENT 1
6.789 MI.
35846 FT.

NO. HMA 2625

PROJECT ST. ALBANS-SHELDON

SHEET 32 OF 52 SHEETS