


PROJECT DESCRIPTION AND LOCATION

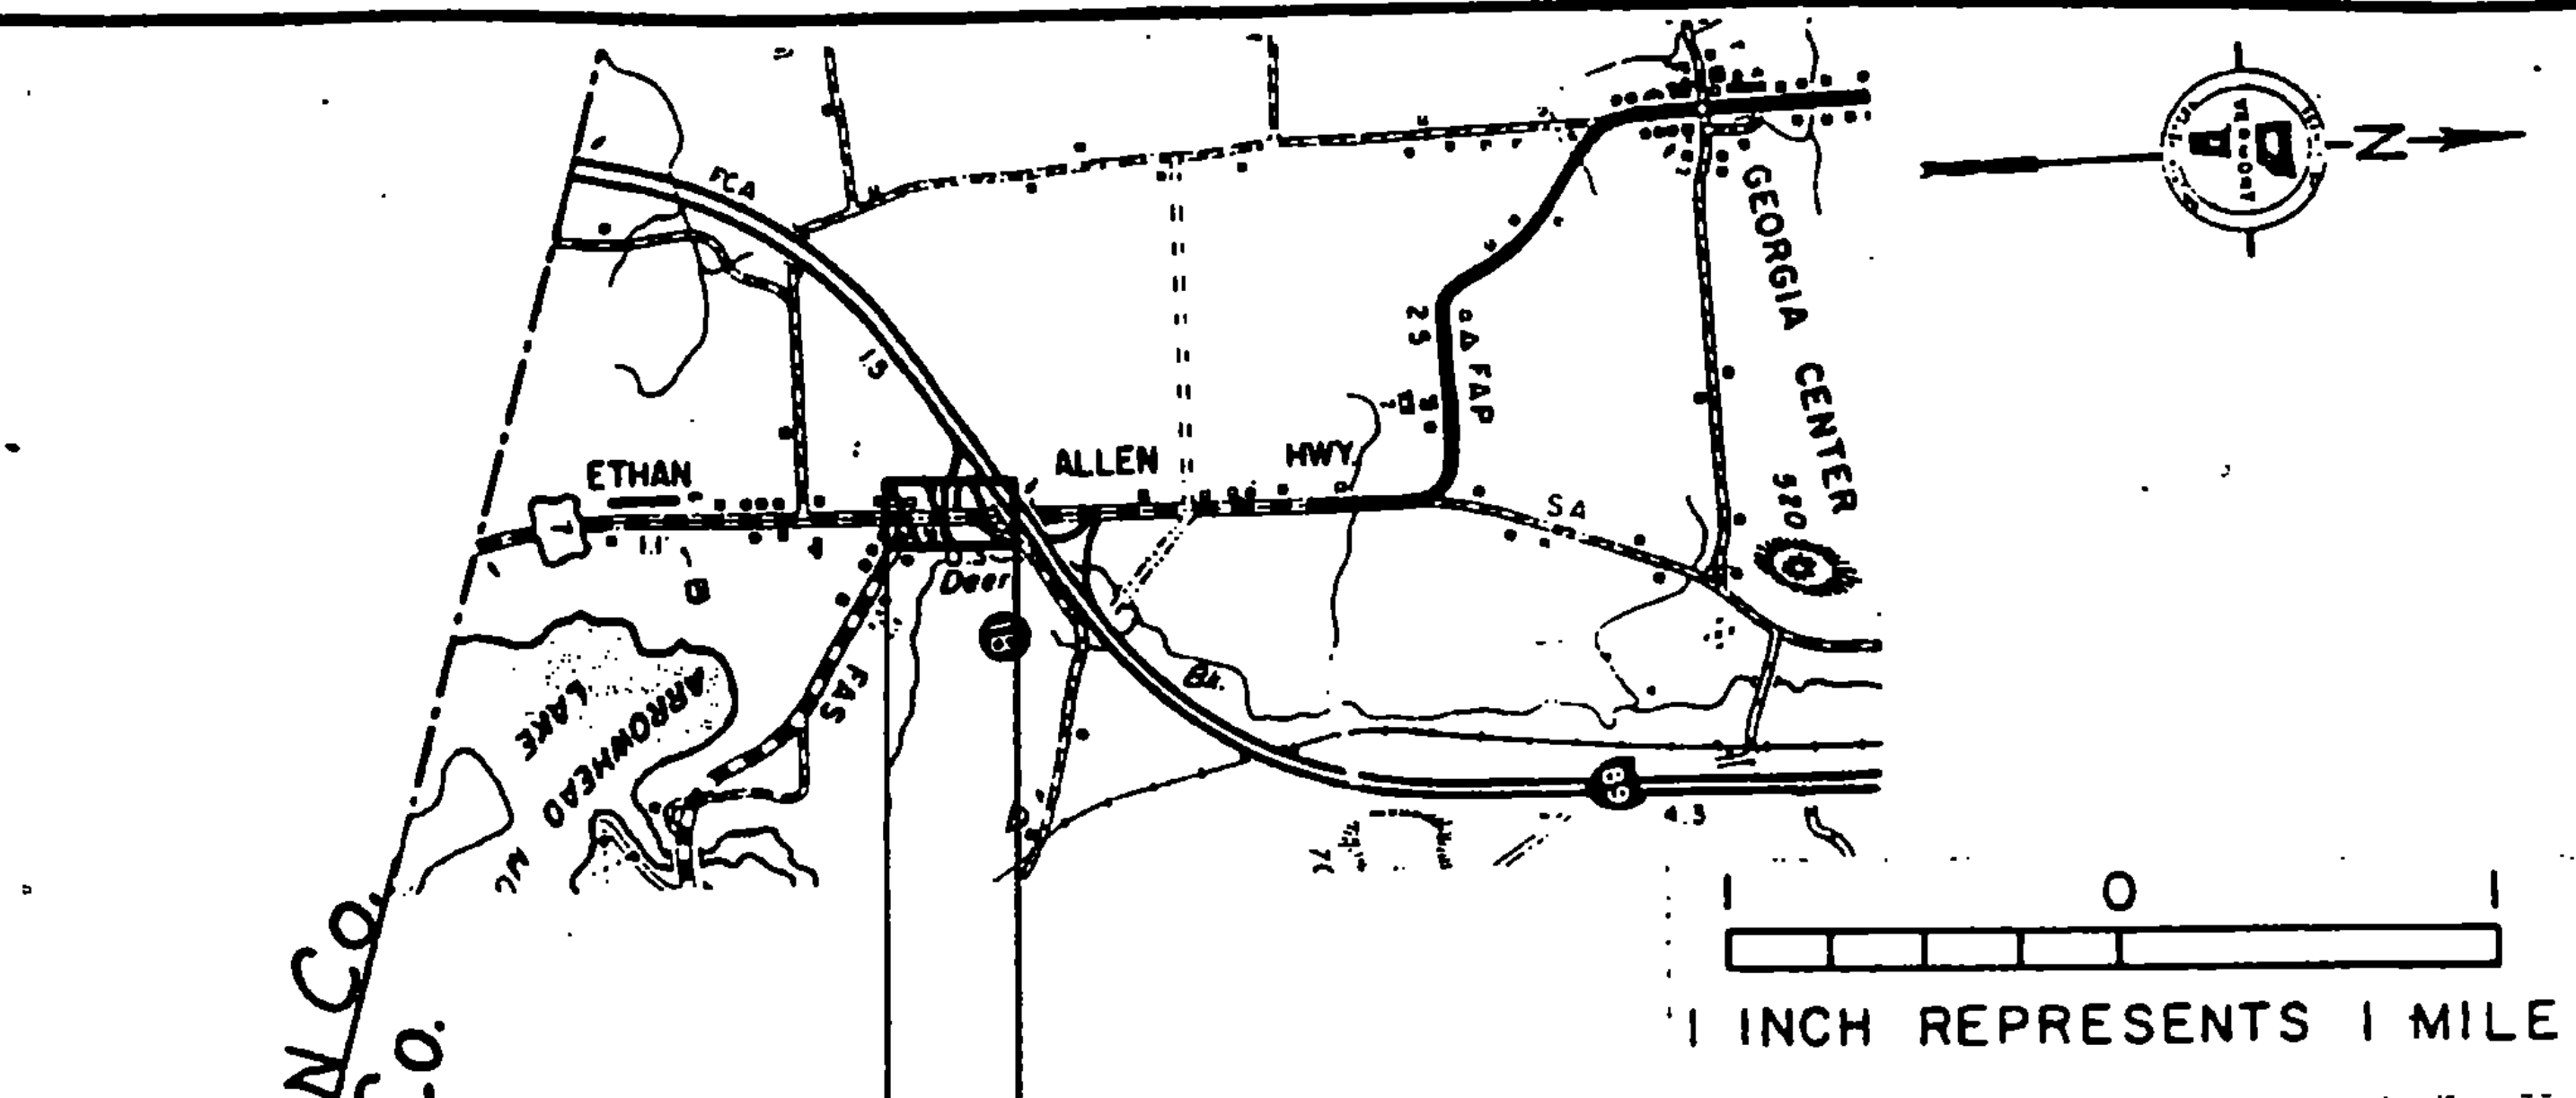

LENGTH OF PROJECT
0.297 MILES
1568 FEET

BEGIN PROJECT
MM 1.103

END PROJECT
MM 1.400

THIS PROJECT BEGINS AT A POINT 1.10 MILES NORTH OF THE MILTON-GEORGIA TOWN LINE AT MM 1.103 AND EXTENDS NORTHERLY 0.297 MILES TO MM 1.400.

TRAFFIC DATA
1982 ADT= 2650
V=50 MPH