


PROJECT DESCRIPTION AND LOCATION

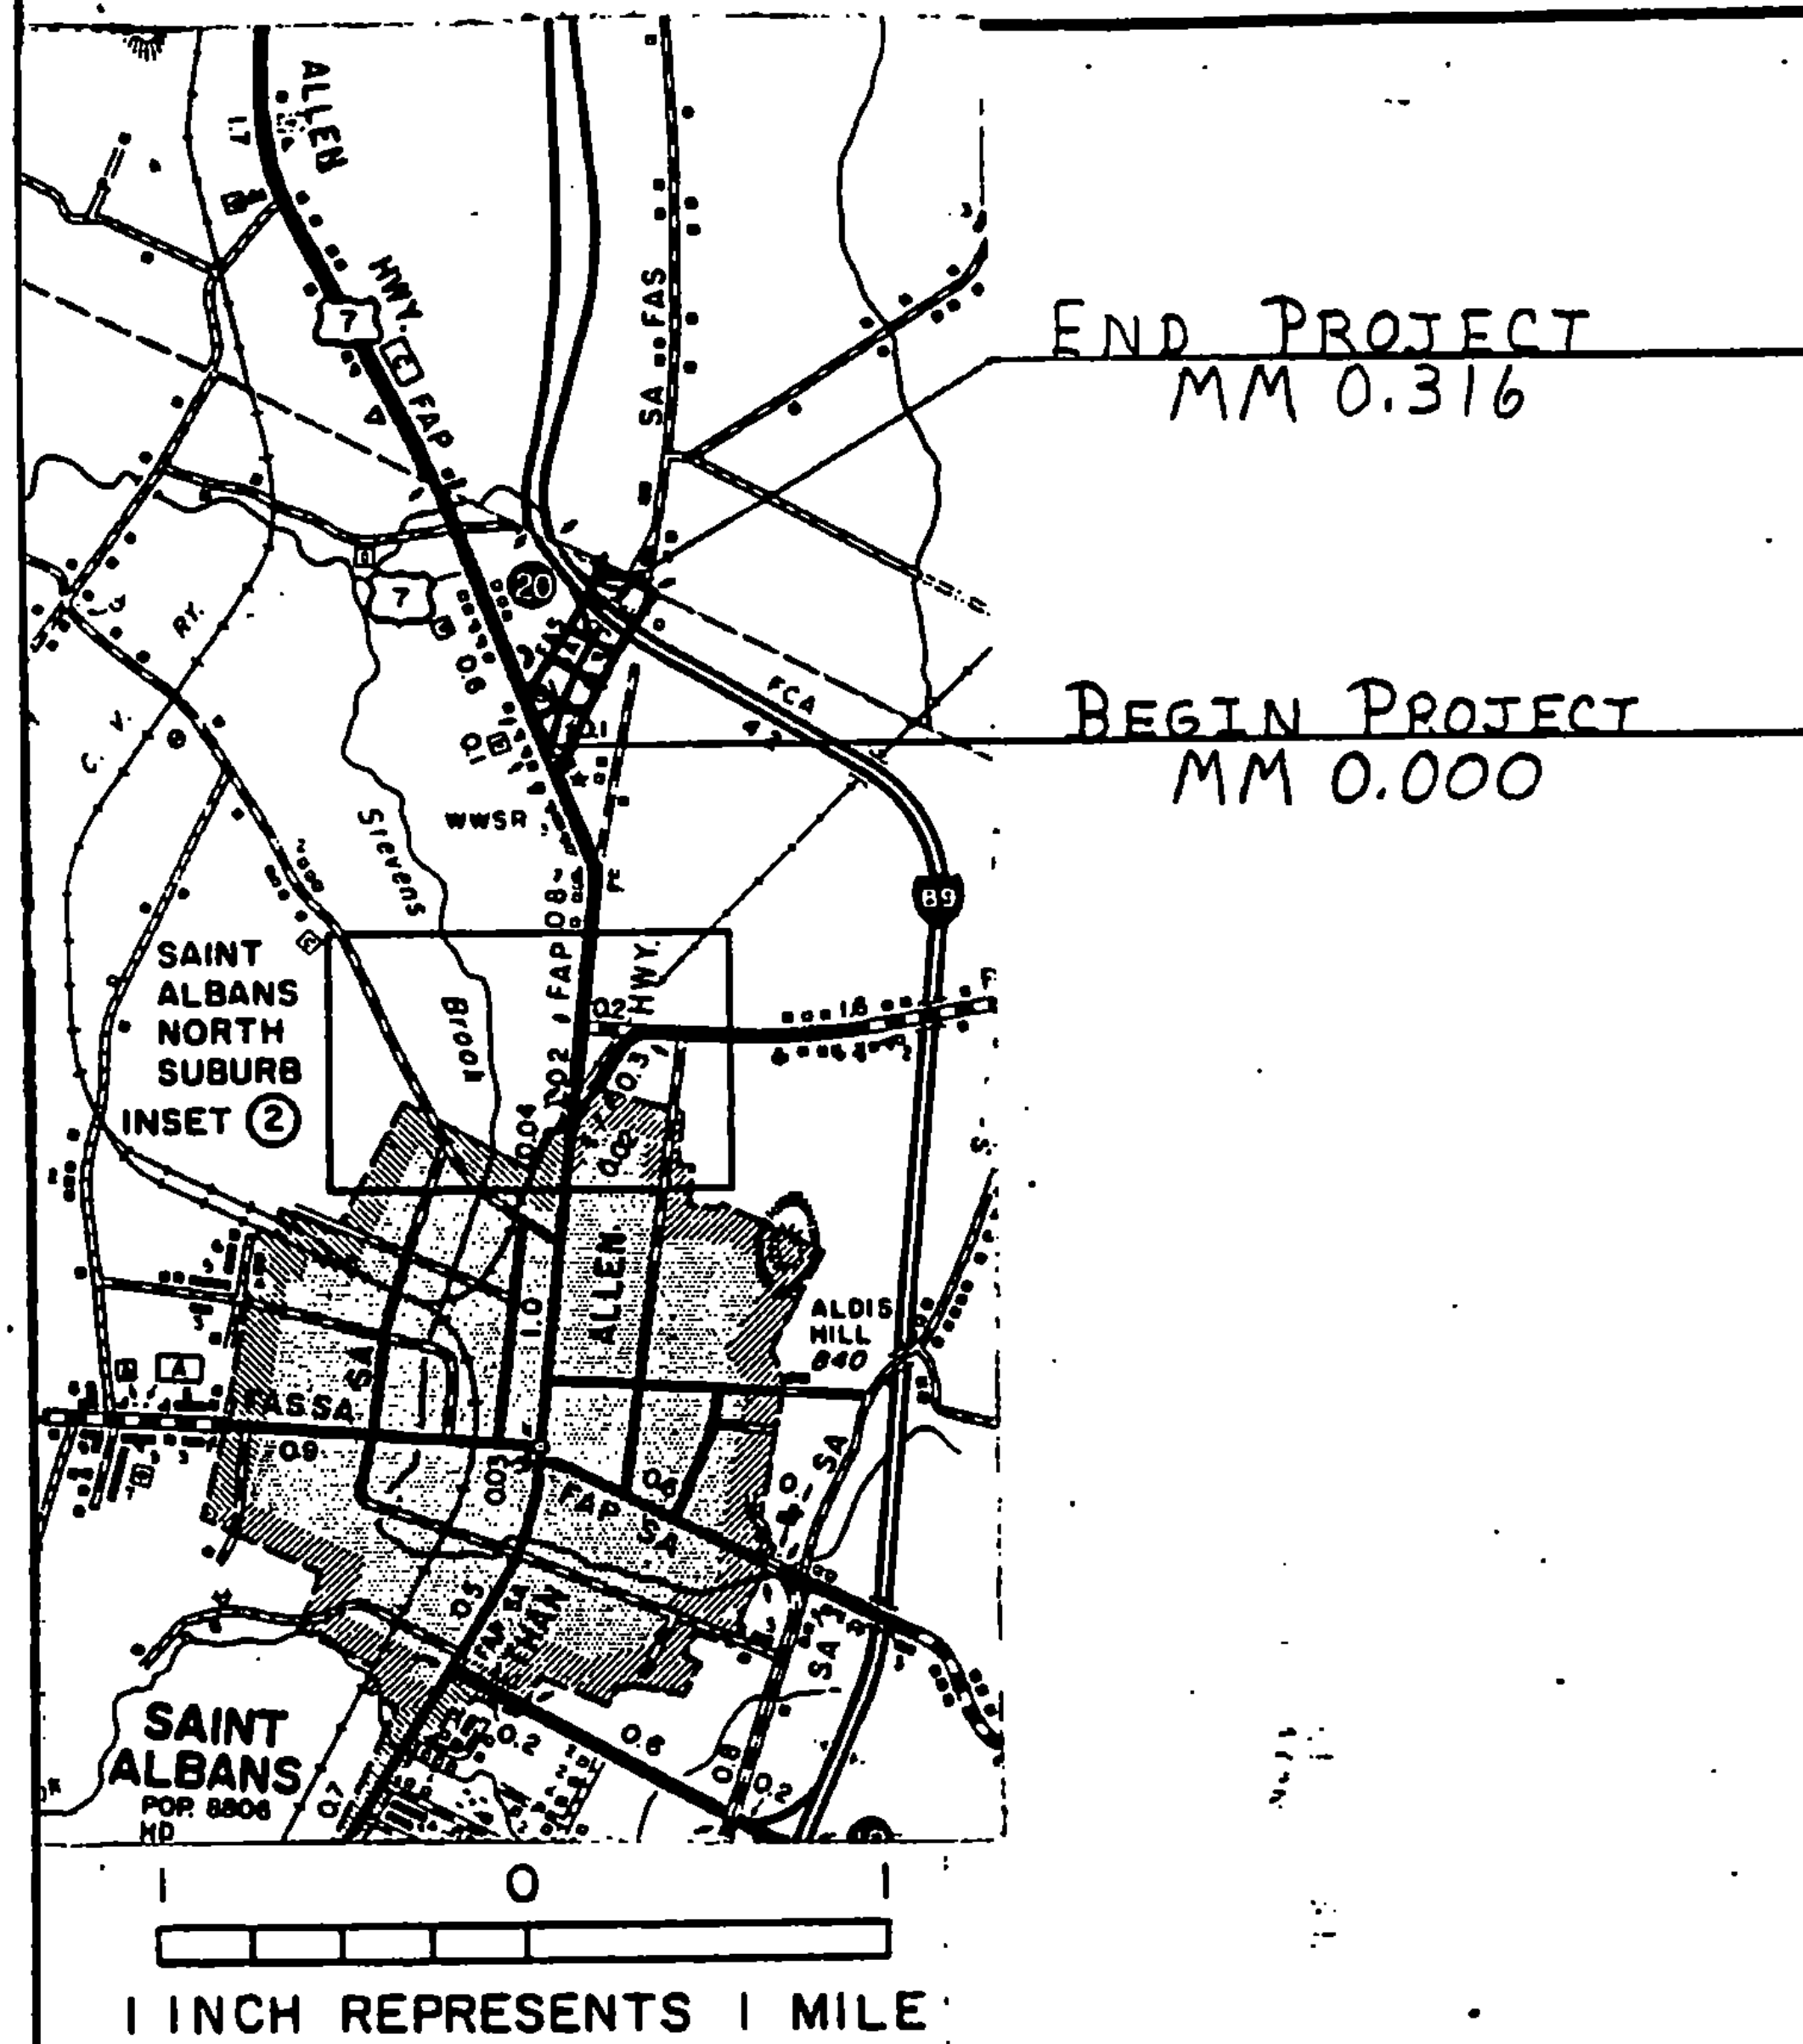

BEGINNING AT THE JUNCTION OF U.S. RTE. 7 AND VT. RTE. 207 AT MM 0.000 AND PROCEEDING NORTH EASTERLY .316 MILES TO MM 0.316, THE TERMINUS OF VT. RTE. 207. INCLUDING APPROACH OF 0.167 MILES:

LENGTH OF PROJECT
0.483 MILES
2550 FEET

TRAFFIC DATA
1982 ADT 2640
V= 50

PROJECT ST. ALBANS

NO. RS 0297(7)

SHEET 23 OF 52 SHEETS