


TYPICAL SECTIONS & DESIGN DATA

ITEM 406.25 BITUMINOUS CONCRETE PAYEMENT
LEVELING COURSE, TYPE III OR IV (16' WIDE @ 218 TONS/MI.)
AS DIRECTED BY THE ENGINEER
1" WEARING COURSE, TYPE III

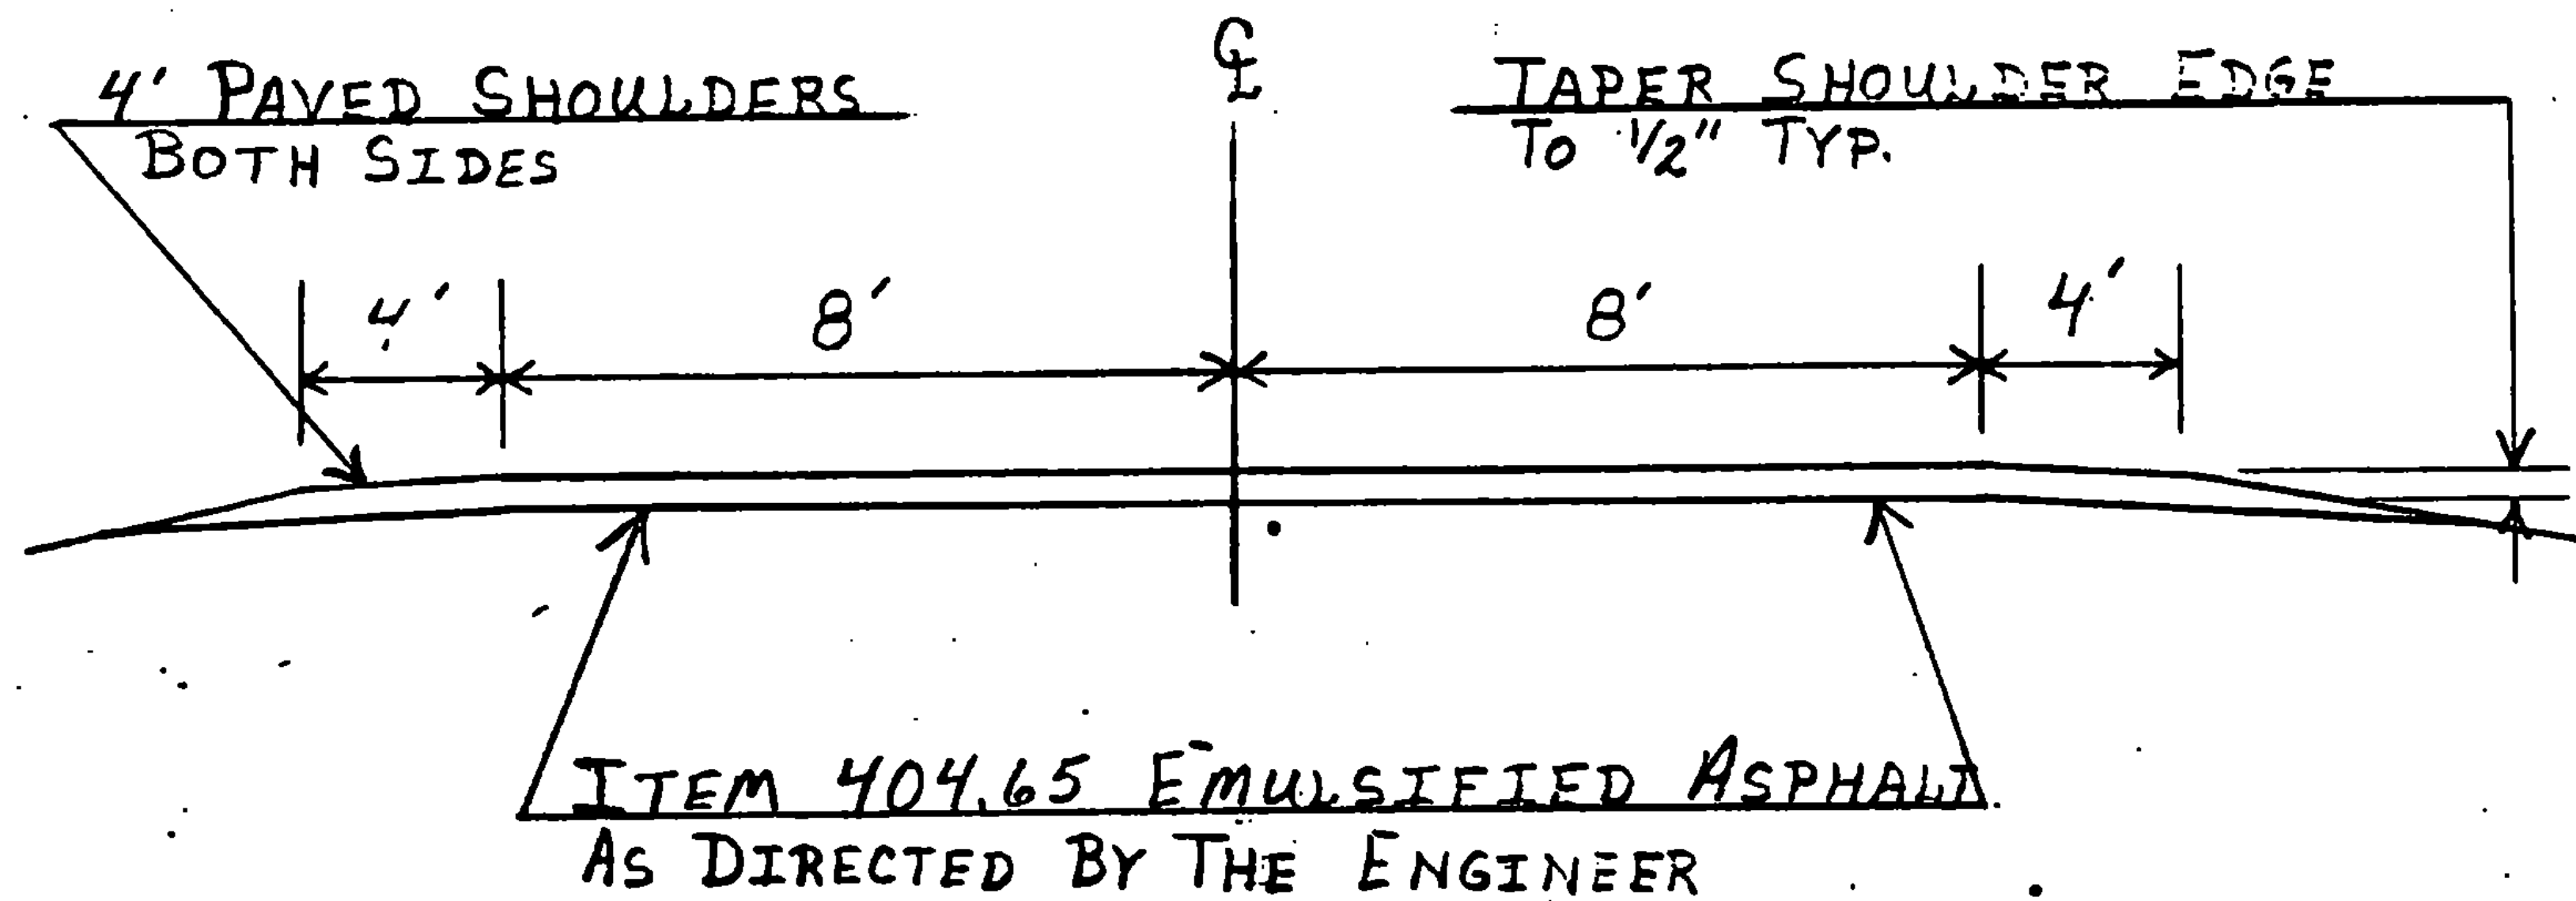

ST. ALBANS - APPROACH RAMP 0.167 MI.