

TEMP. 4" WHITE LINE
EDGE LINES RT.-AS SHOWN
CENTER LINES (DASHED) AS SHOWN

DURABLE 4" WHITE LINE
LANE LINE @ INTERSECTION-AS SHOWN

DURABLE 24" STOP BARS
U.S. 7 INTERSECTION-AS SHOWN


DURABLE 8" WHITE LINE
GORE AREA AS SHOWN
(SEE DETAIL SHEET)

TEMP. 4" YELLOW LINE
EDGE LINES LT.-AS SHOWN

DURABLE 4" YELLOW LINE
PRINTED ISLAND @ INTERSECTION

PAINTED CURBS
ENDS OF ISLANDS-AS SHOWN
(SEE DETAIL SHEET)


DURABLE ARROW MARKINGS
LANE LINE-AS SHOWN

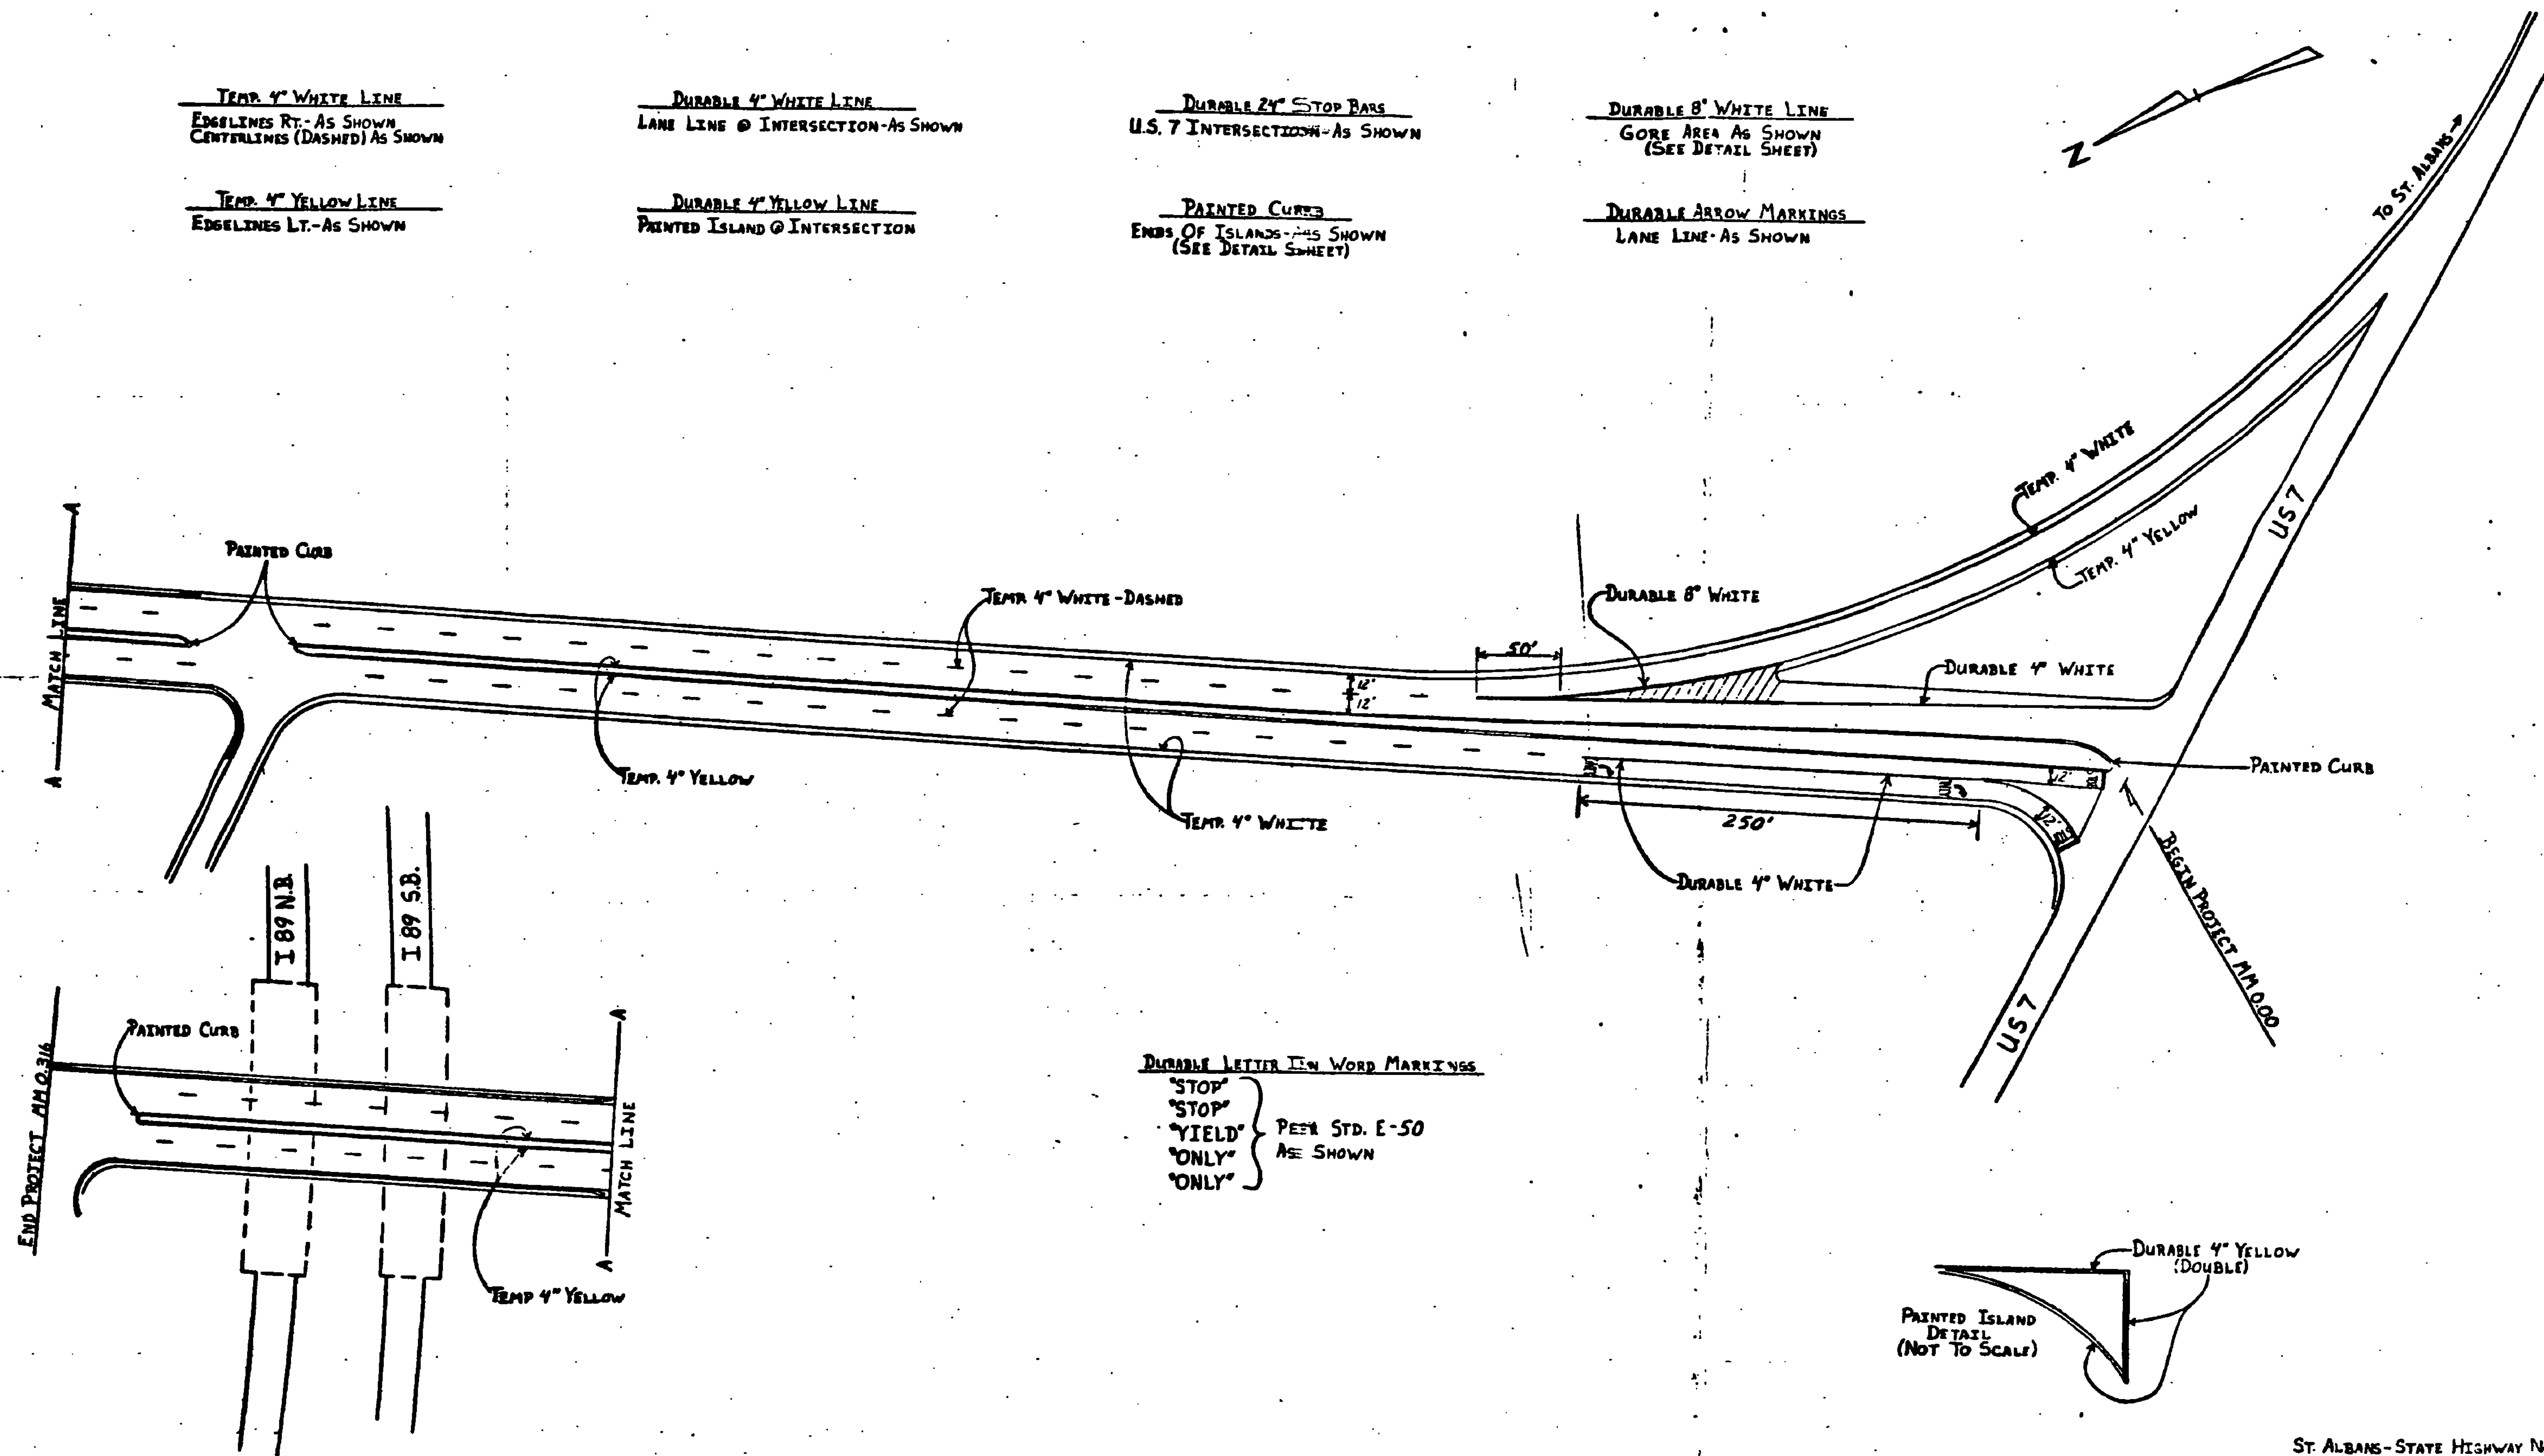

DURABLE LETTER IN WORD MARKINGS

"STOP"
"STOP"
"YIELD"
"ONLY"
"ONLY"

PER STD. E-50
AS SHOWN

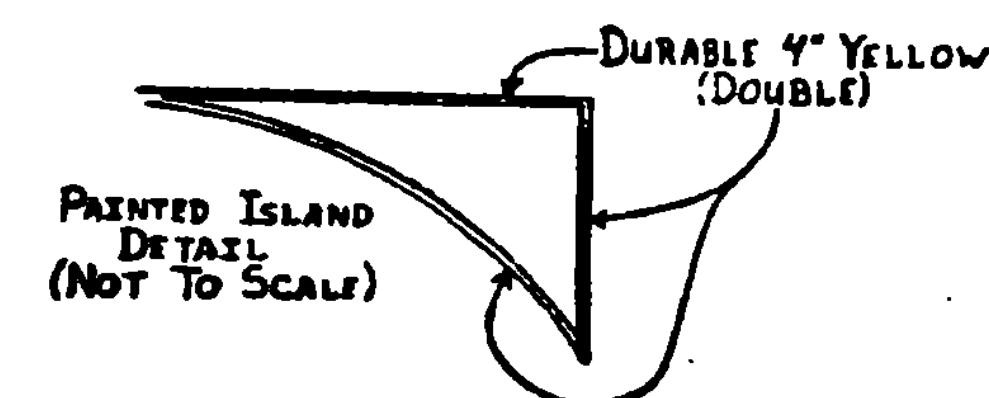

DATUM
VERTICAL _____
HORIZONTAL _____

0 50 100 150
SCALE 1" = 50'

SHEET 29 OF 52

ST. ALBANS-STATE HIGHWAY NO.

SURVEYED BY _____ DATE _____
DRAWN BY JLR DATE _____
TRACED BY JLR DATE _____
ST. ALBANS VT. 207
PROJ. RS NO. 0297(?)
SHEET OF