



SPECIAL MARKING DETAILS

Painted Island Detail

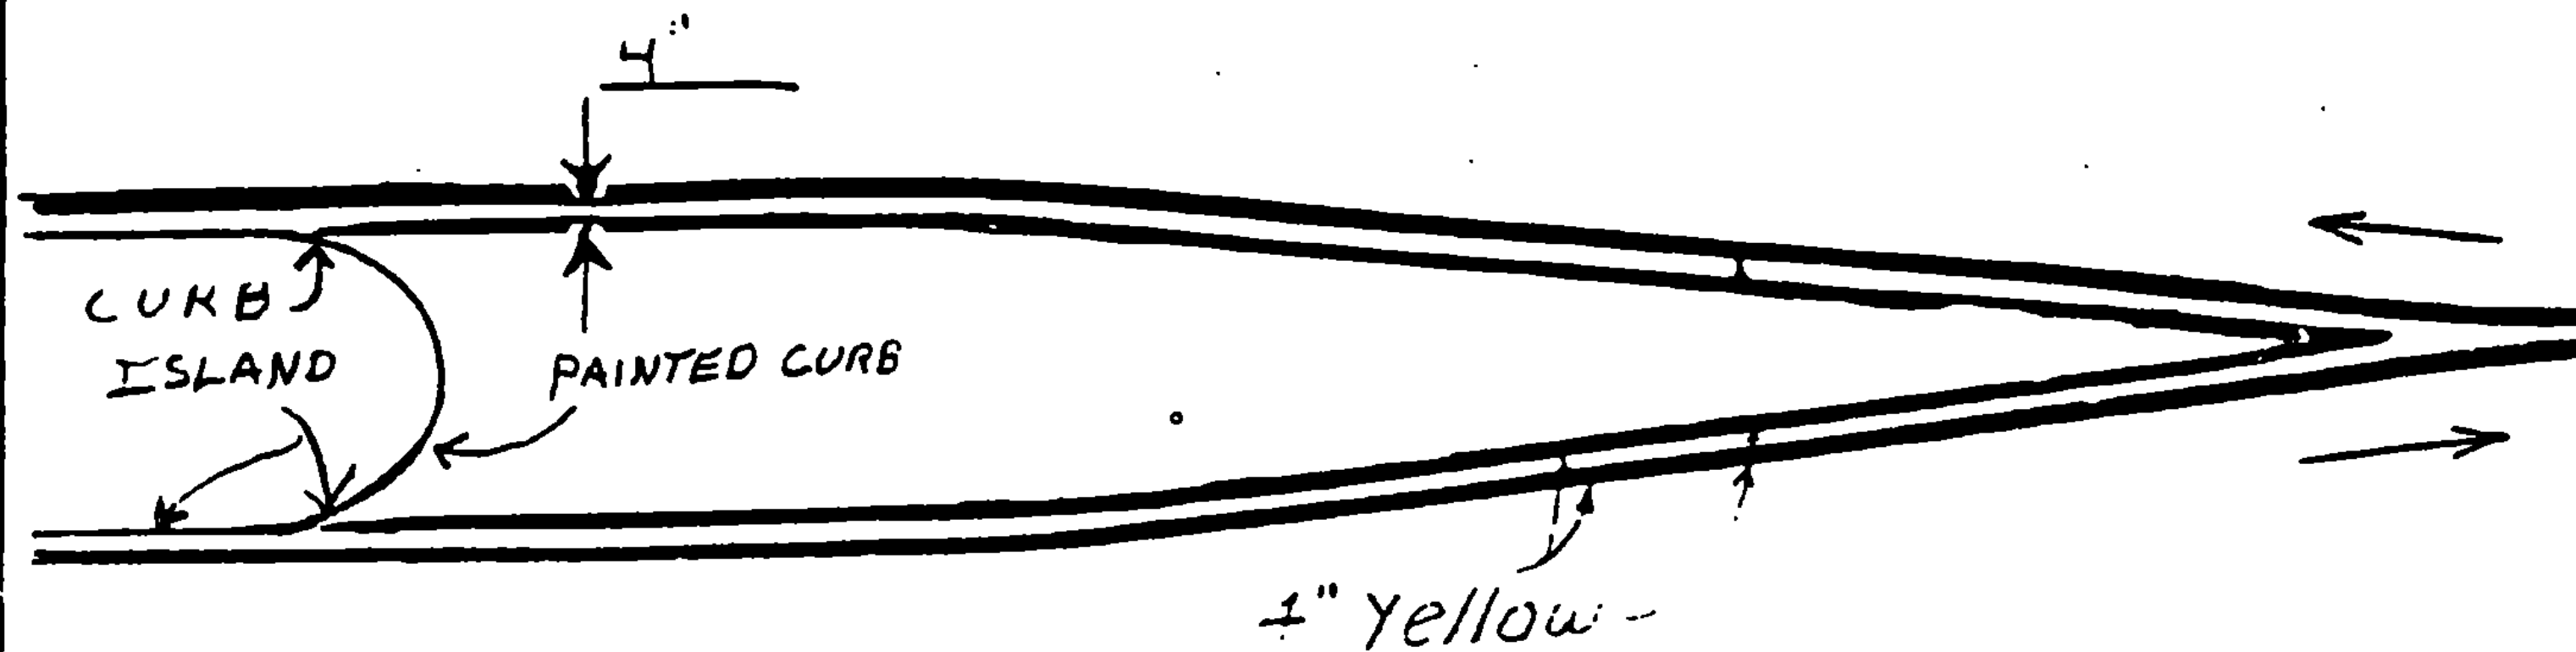


Not to Scale

Gore Marking Detail

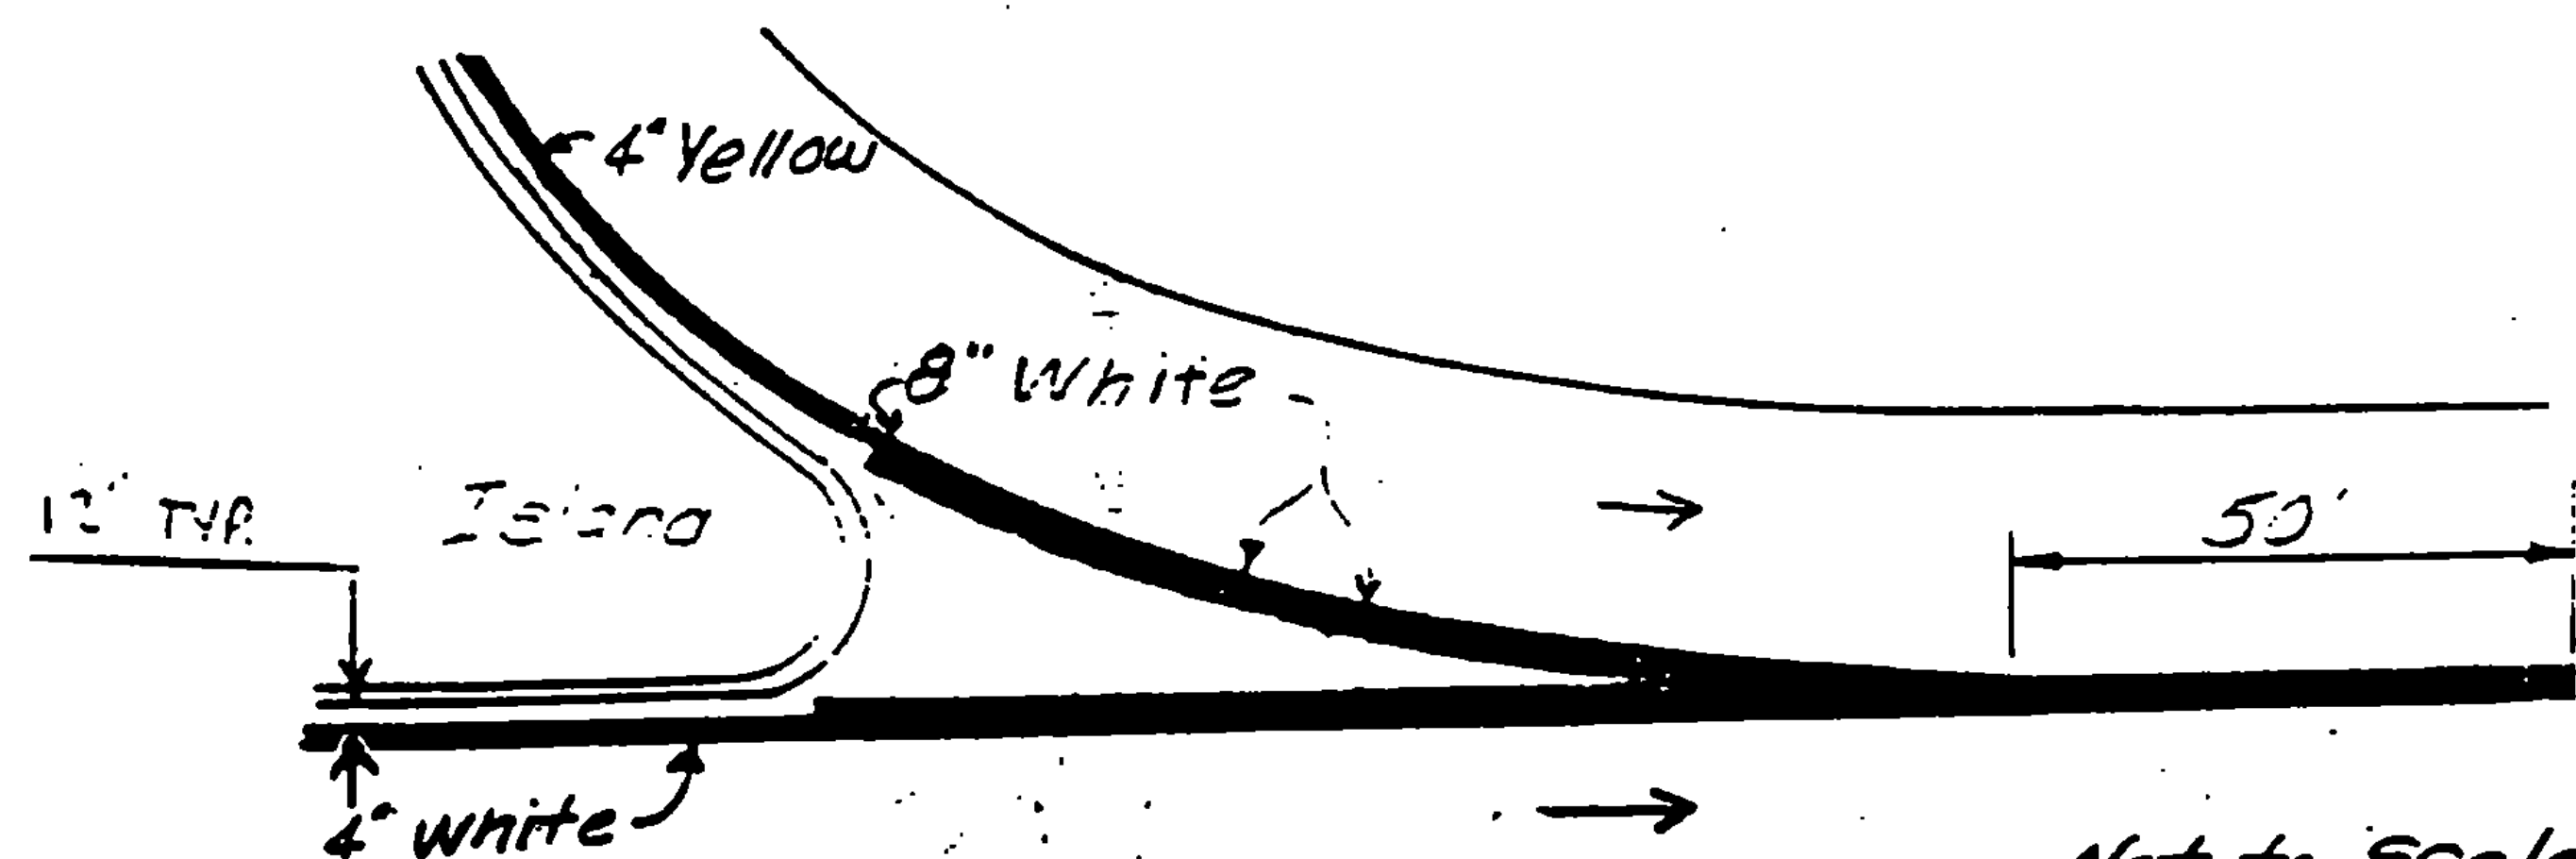

Not to Scale

Turn Lane and Painted Curb Detail

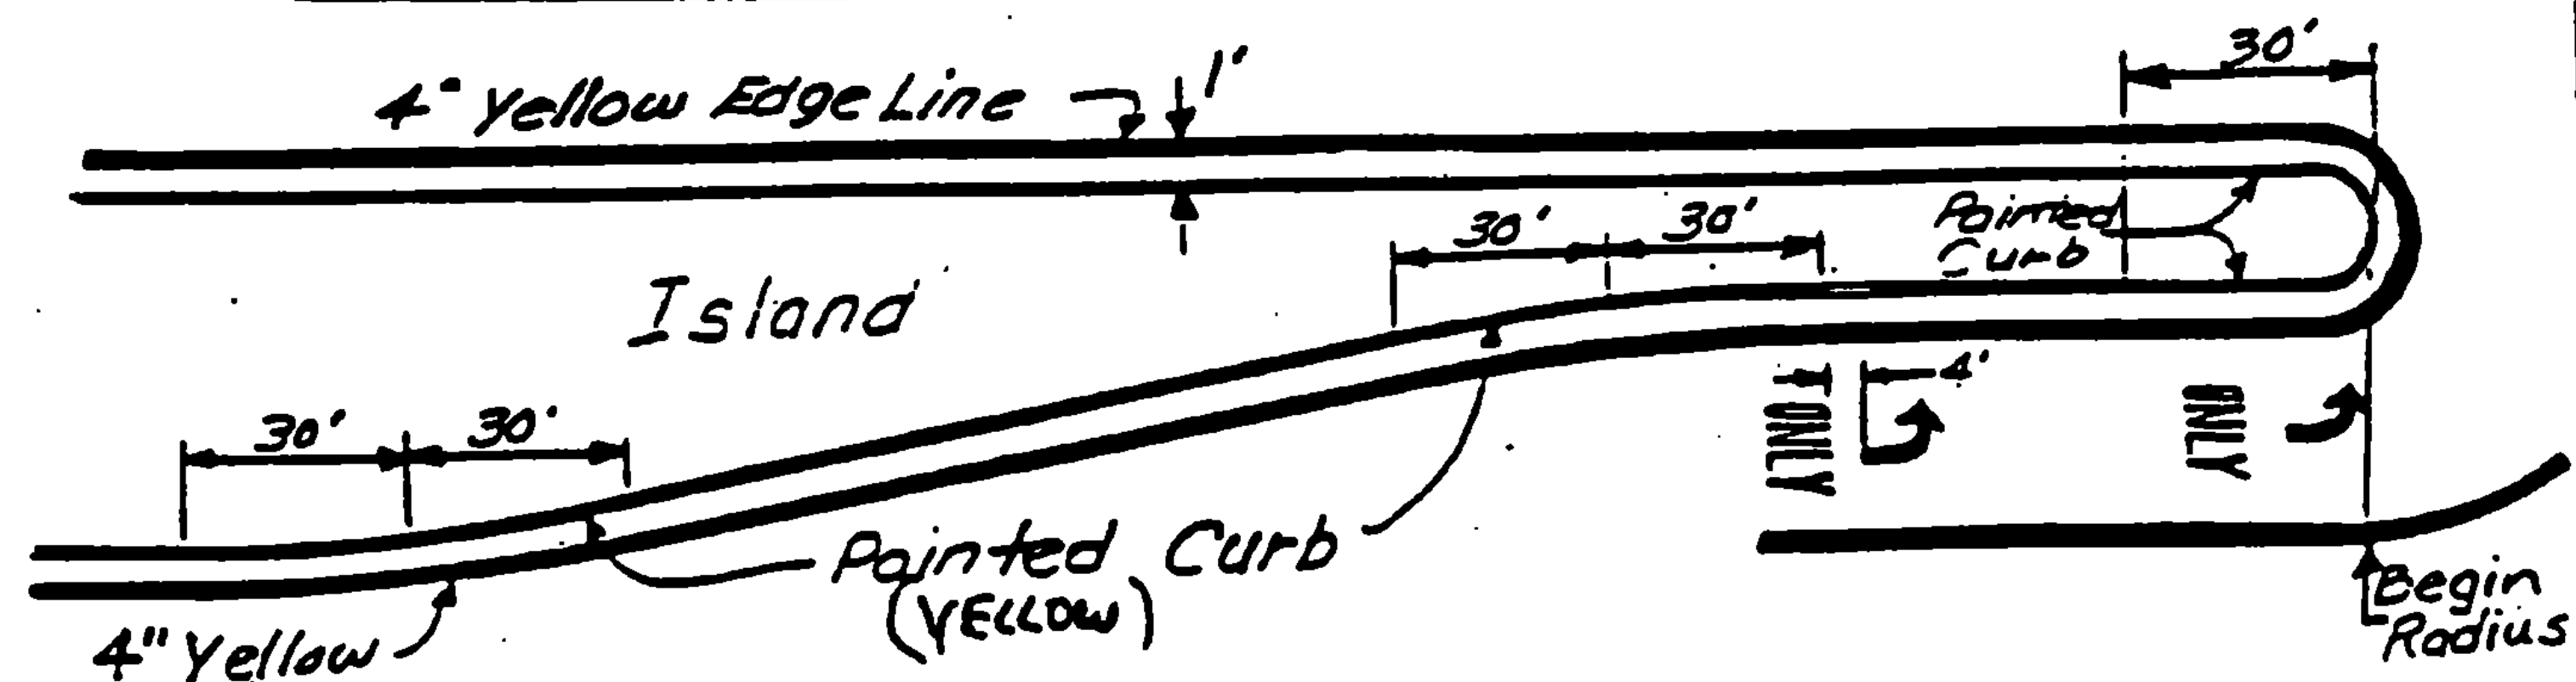

Not to Scale

NO. RS 0297(7)

PROJECT ST. ALBANS

SHEET 30 OF 52 SHEETS