


# STOP BAR DETAILS


13.

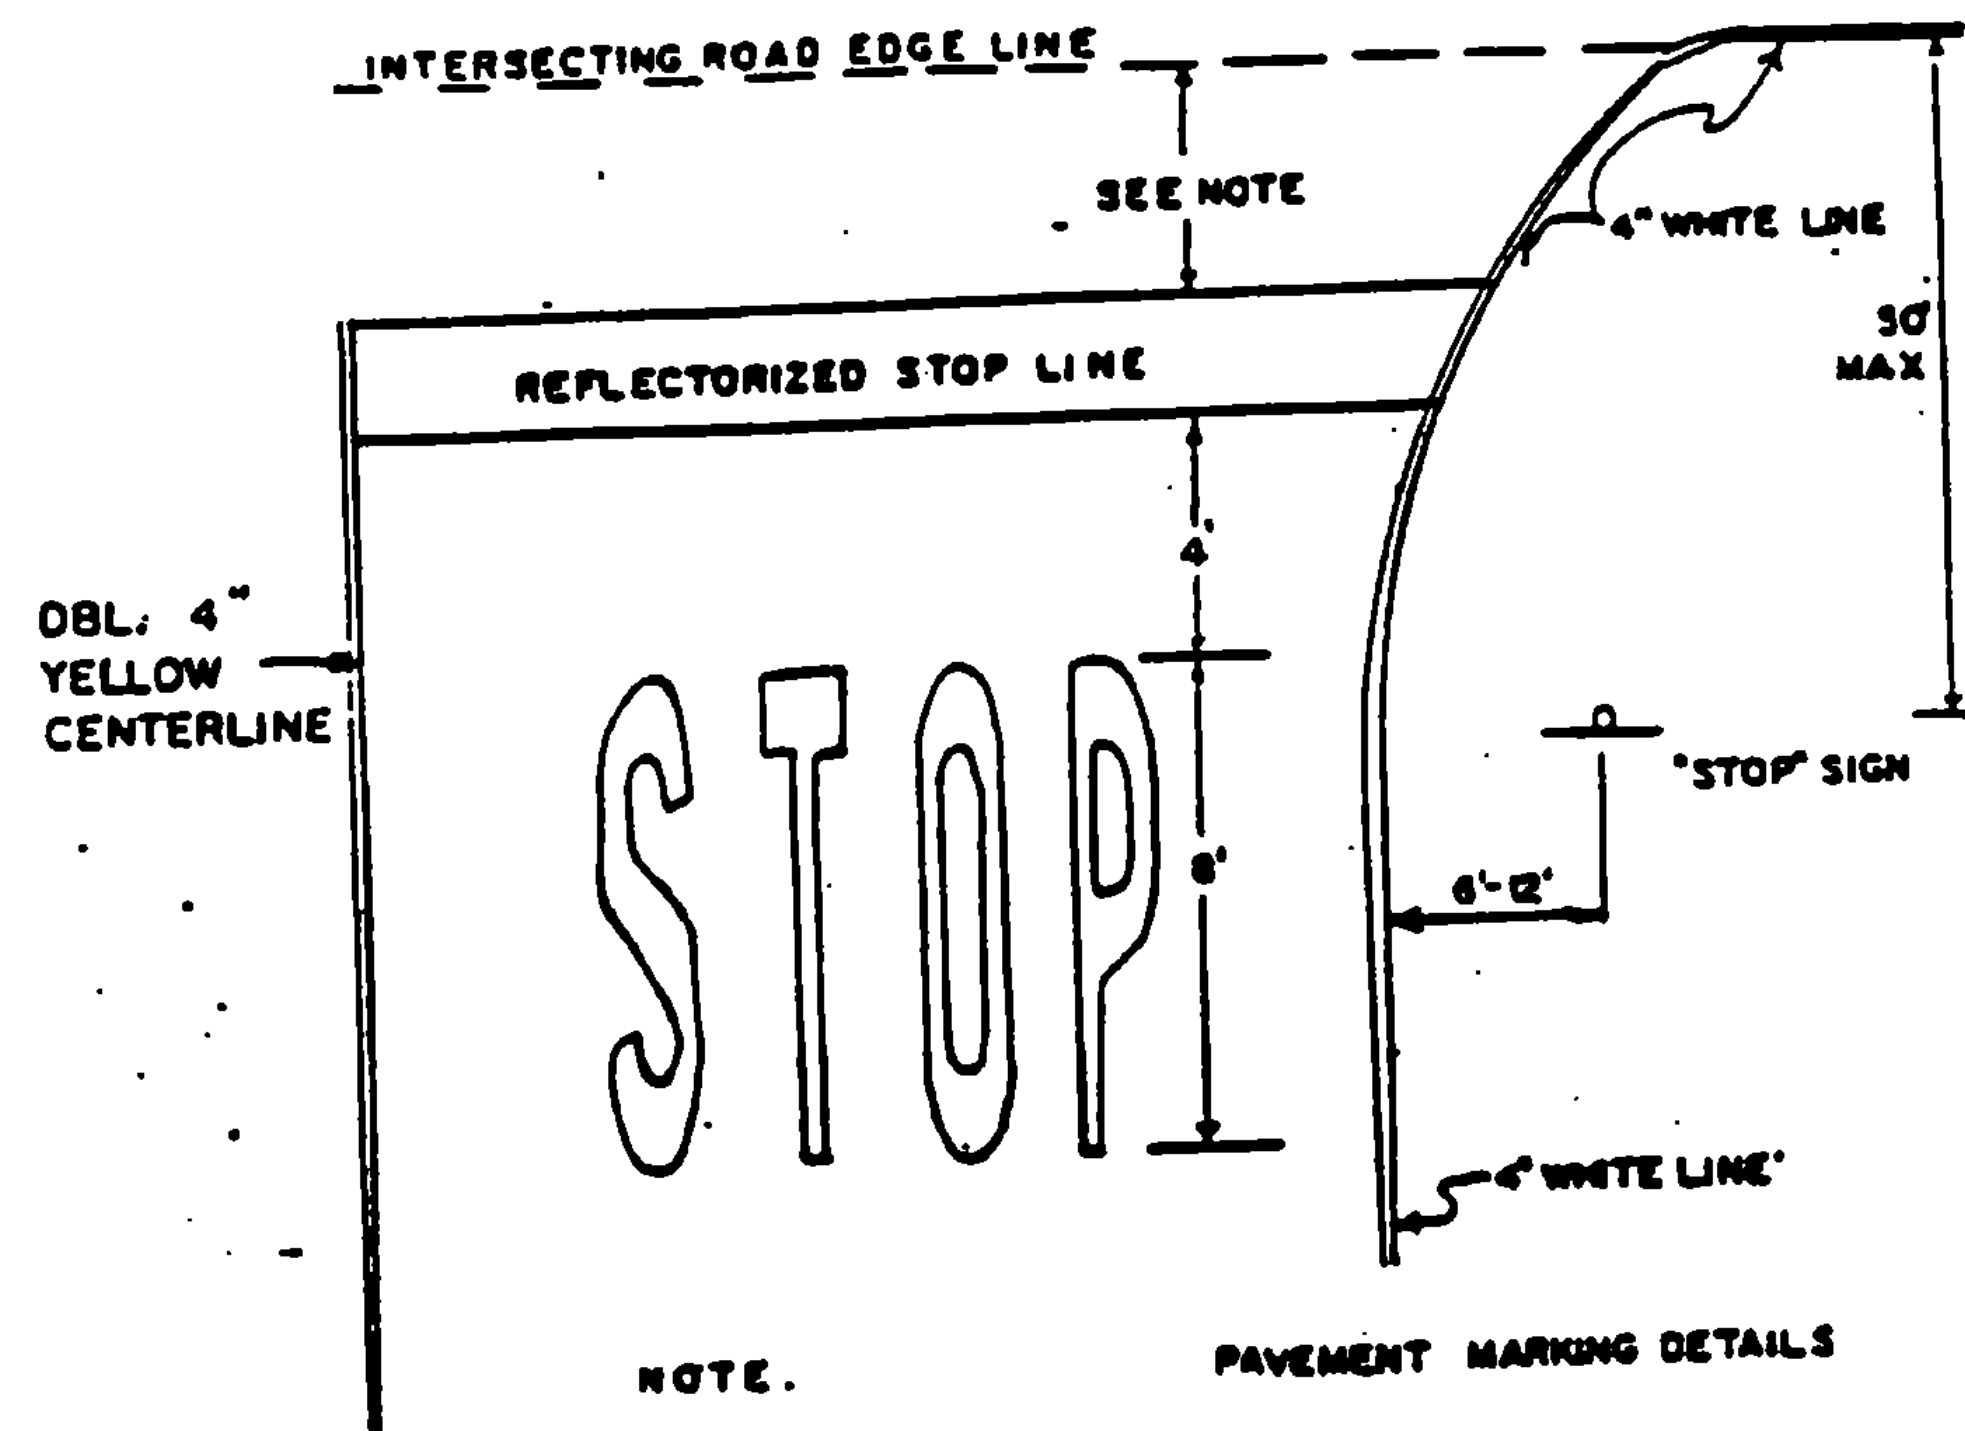

NOTE.  
PAVEMENT MARKING DETAILS

1. THE STOP LINE SHOULD BE PLACED AT THE DESIRED STOPPING POINT, IN NO CASE MORE THAN 30 FEET OR LESS THAN 4' FROM THE NEAREST EDGE OF THE INTERSECTING ROADWAY, OR EDGE OF CROSSWALK.

NOT TO SCALE

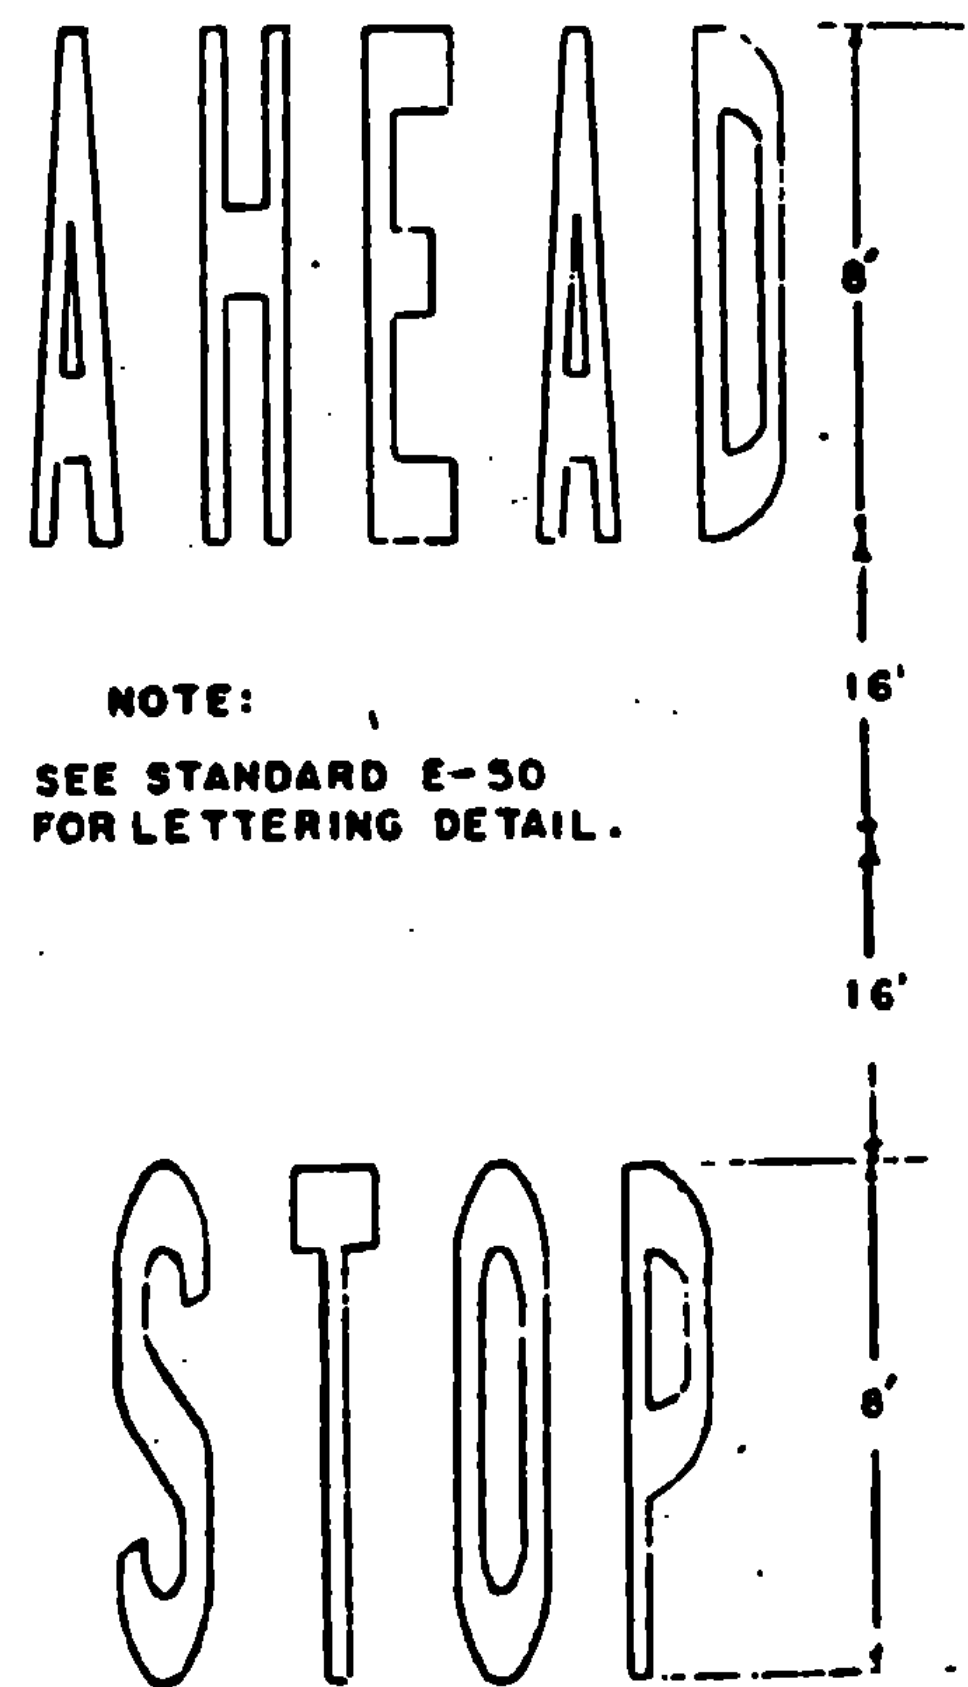

NOTE:  
SEE STANDARD E-50  
FOR LETTERING DETAIL.

No. RS 0297(7)

PROJECT ST. ALBANS

SHEET 31 OF 52 SHEETS