


TYPICAL SECTIONS & DESIGN DATA

ITEM 406.25 BITUMINOUS CONCRETE PAVEMENT
LEVELING COURSE, TYPE III OR IV (22' WIDE @ 250 TONS/MI.)
AS DIRECTED BY THE ENGINEER
1" WEARING COURSE, TYPE III

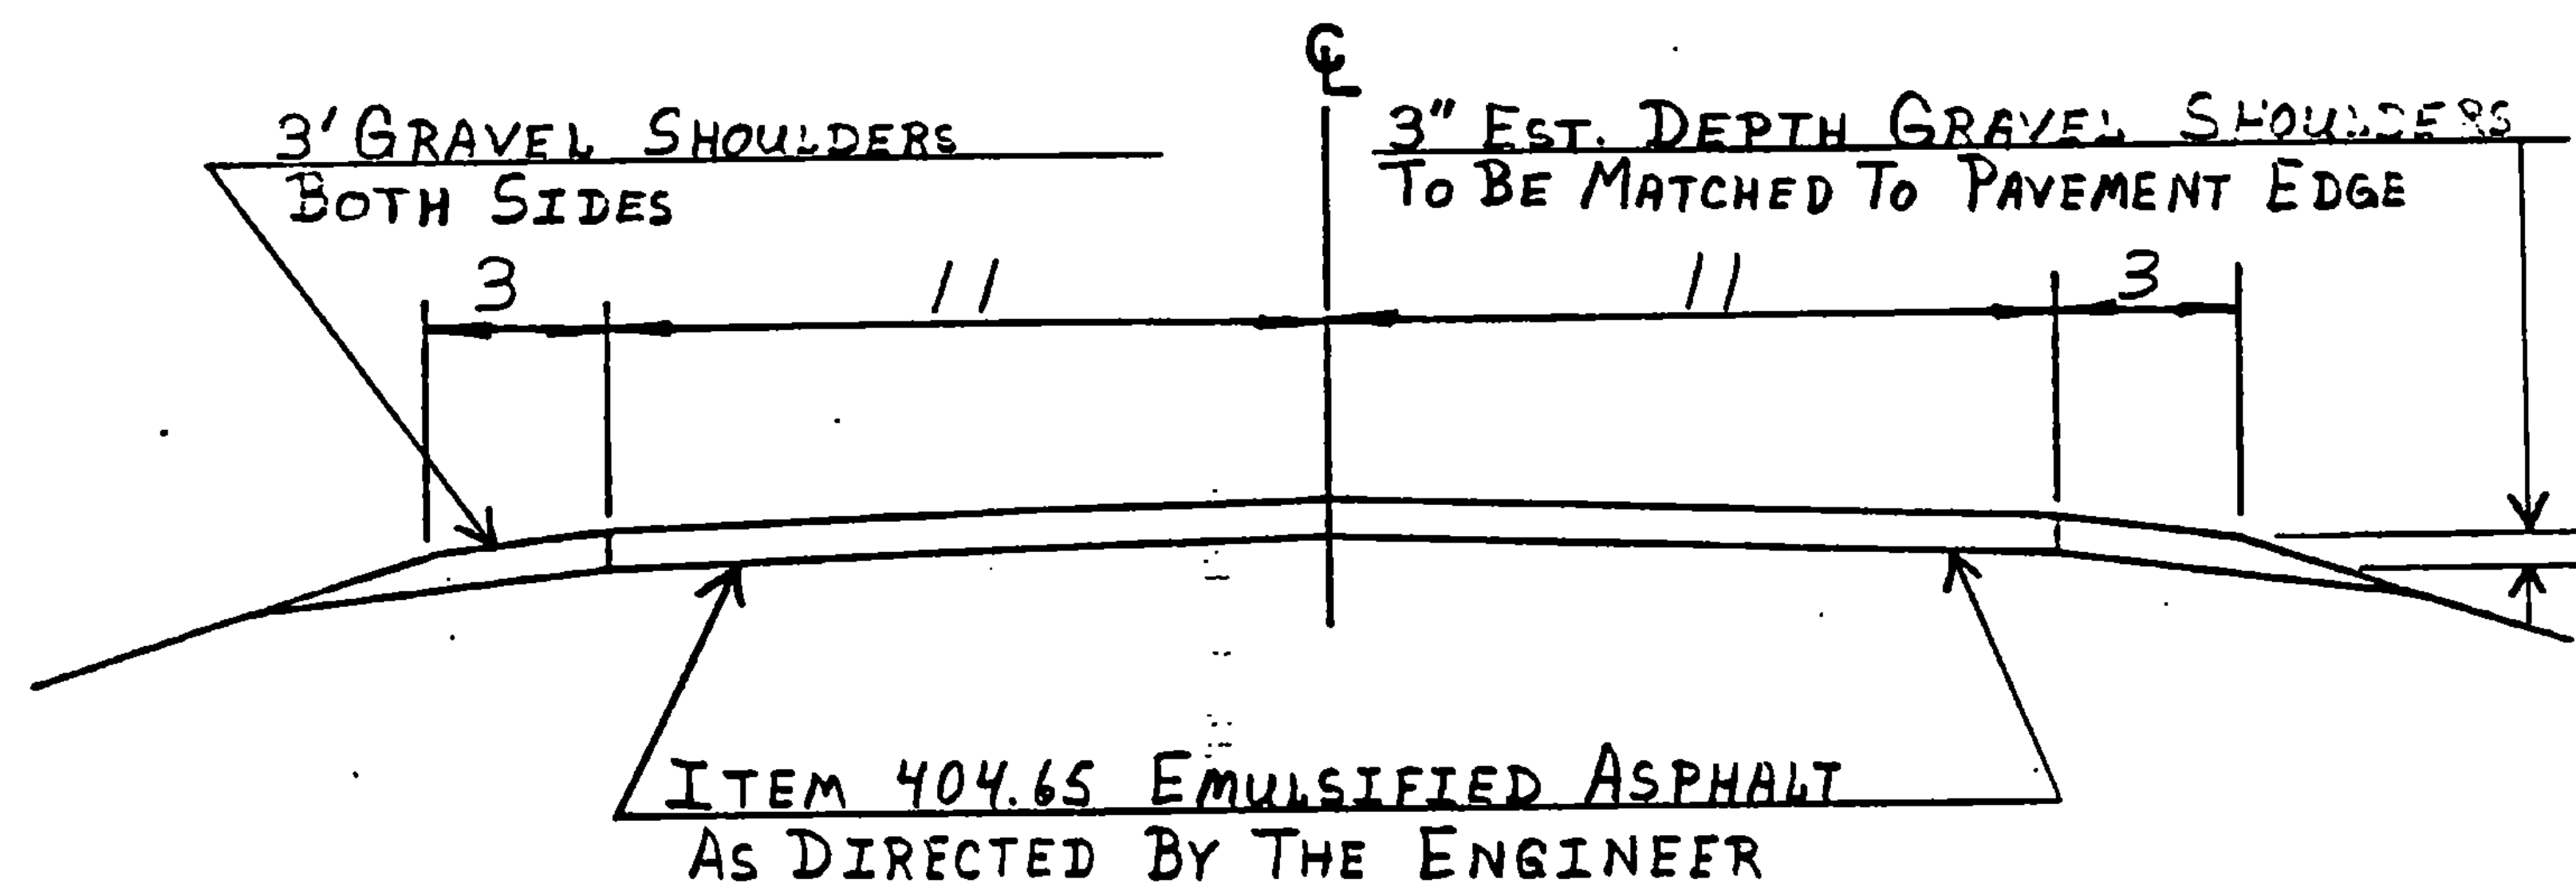

ENOSBURG MM. 0.000 ~ 0.464