



TD
SEE SHEET 534 FOR NEW SIGNS 0.0 THRU 0.26

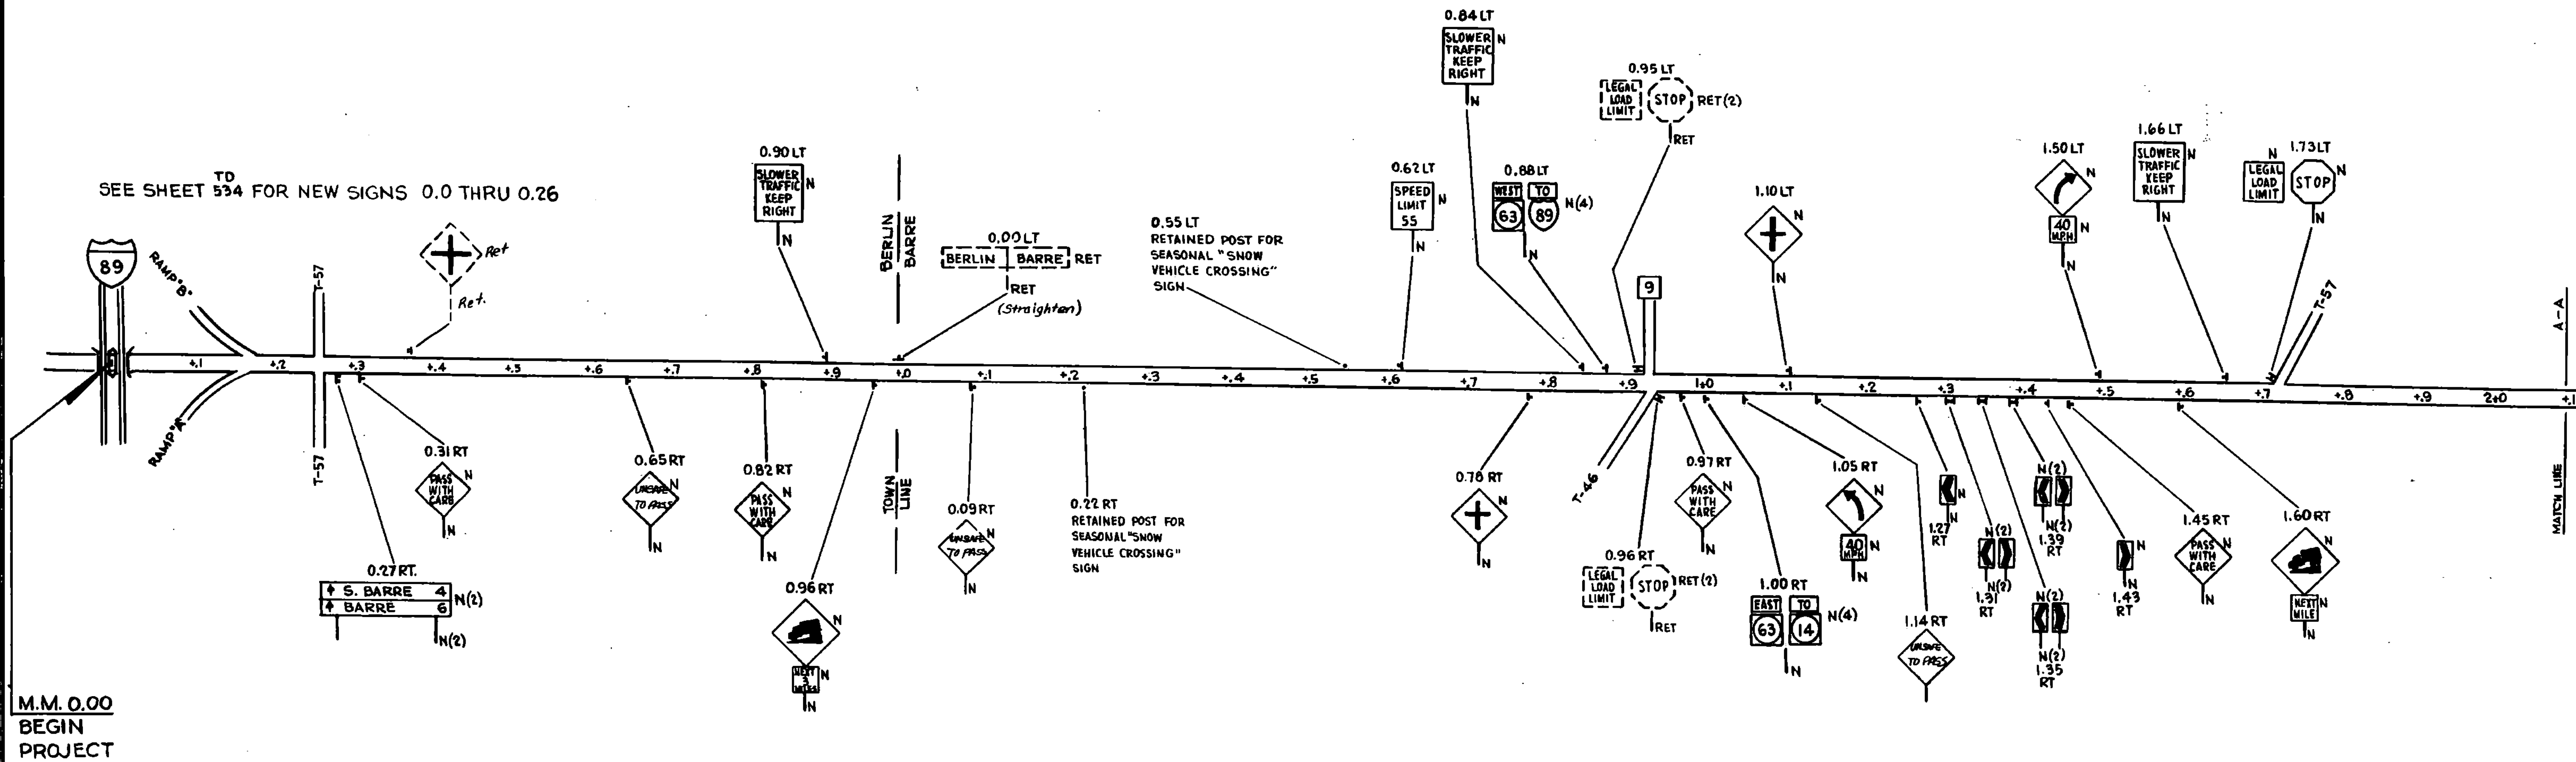

M.M. 0.00
BEGIN
PROJECT

TD
SEE SHEET 536 FOR NEW SIGNS 2.50 THRU 2.91

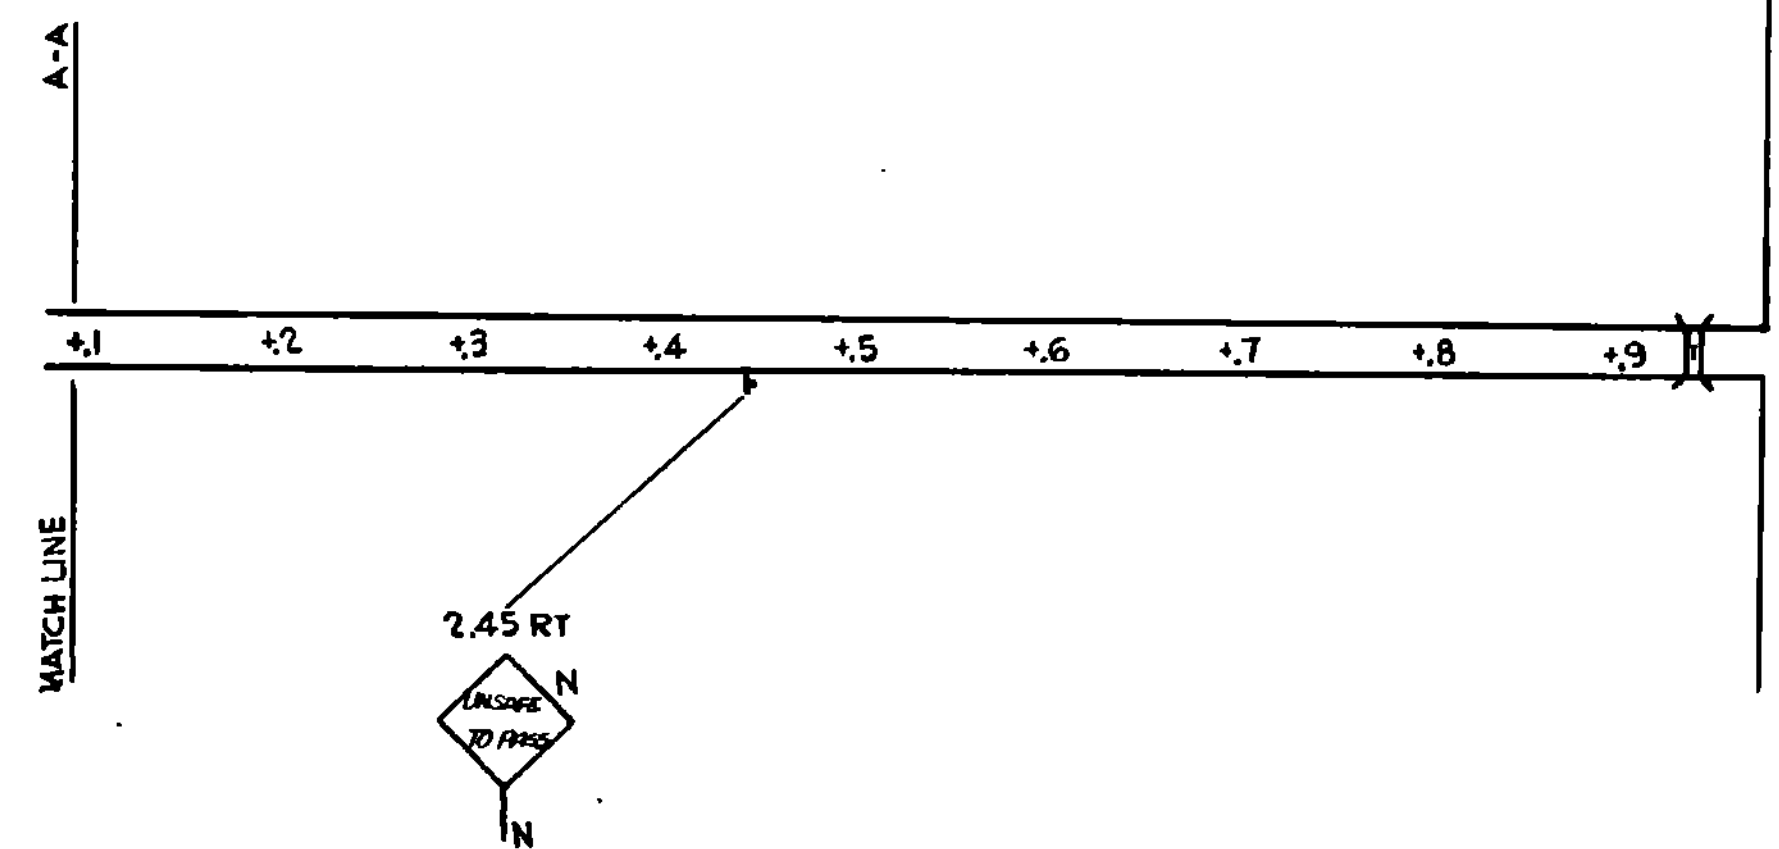

NEW AND SALVAGED
SIGNS
0.26 TO 2.50

SURVEYED BY _____ DATE _____
DRAWN BY _____ DATE _____
TRACED BY _____ DATE _____

BERLIN - BARRE

STATEWIDE NO. F-SFTY (85)S
SHEET 89 OF 200

TRAFFIC SHEET NO. TD 535 SHEET _____ OF _____

DATUM

VERTICAL	_____
HORIZONTAL	_____

BRUNING 53428.3