

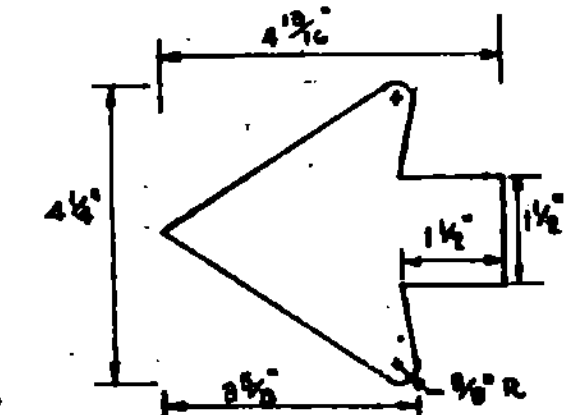
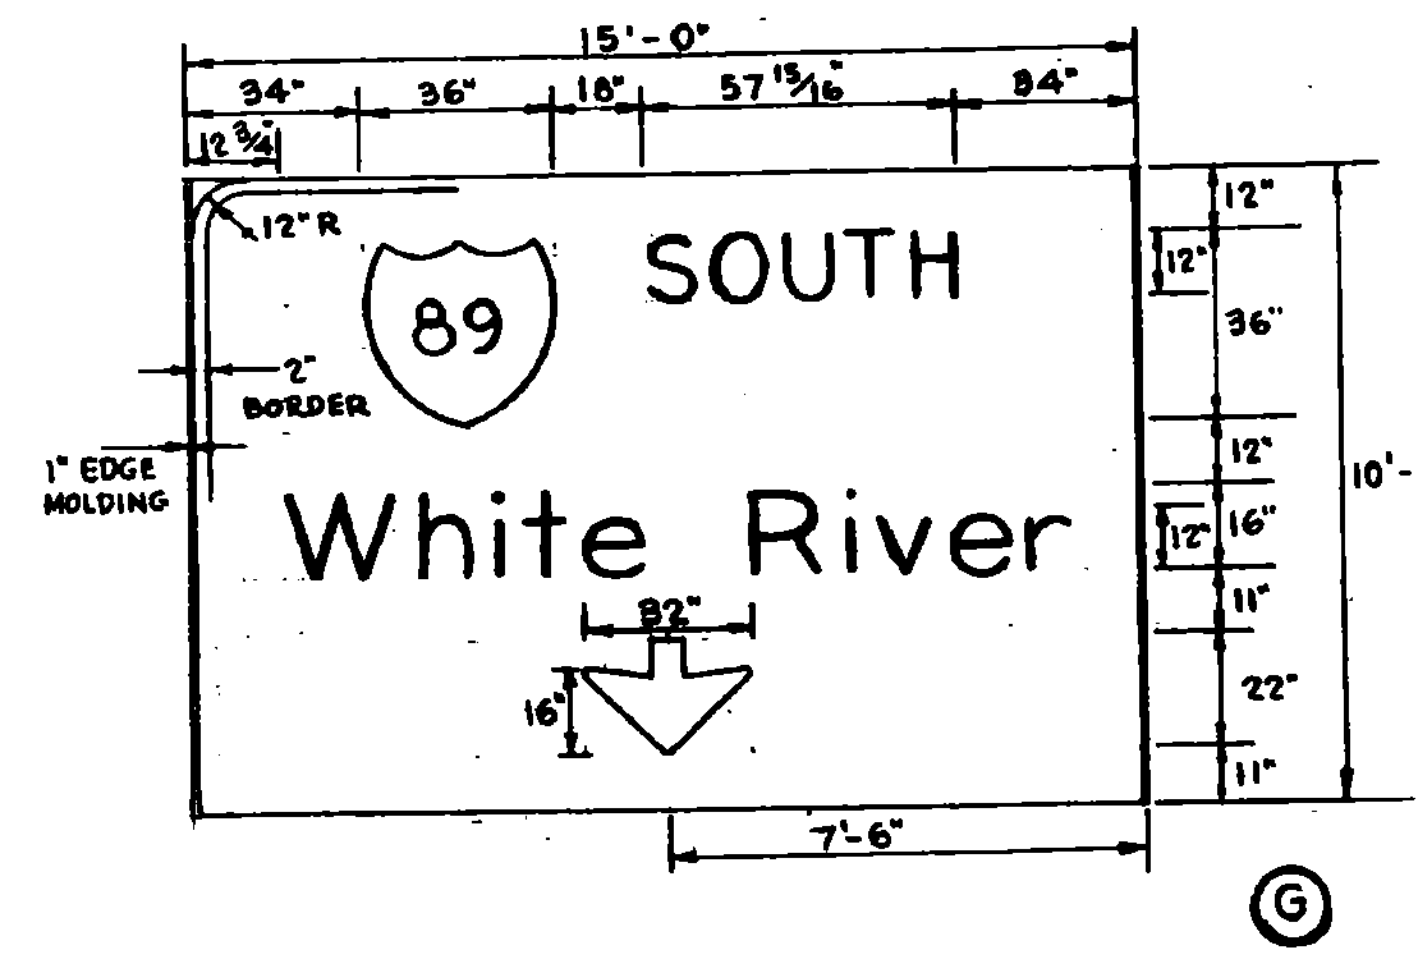
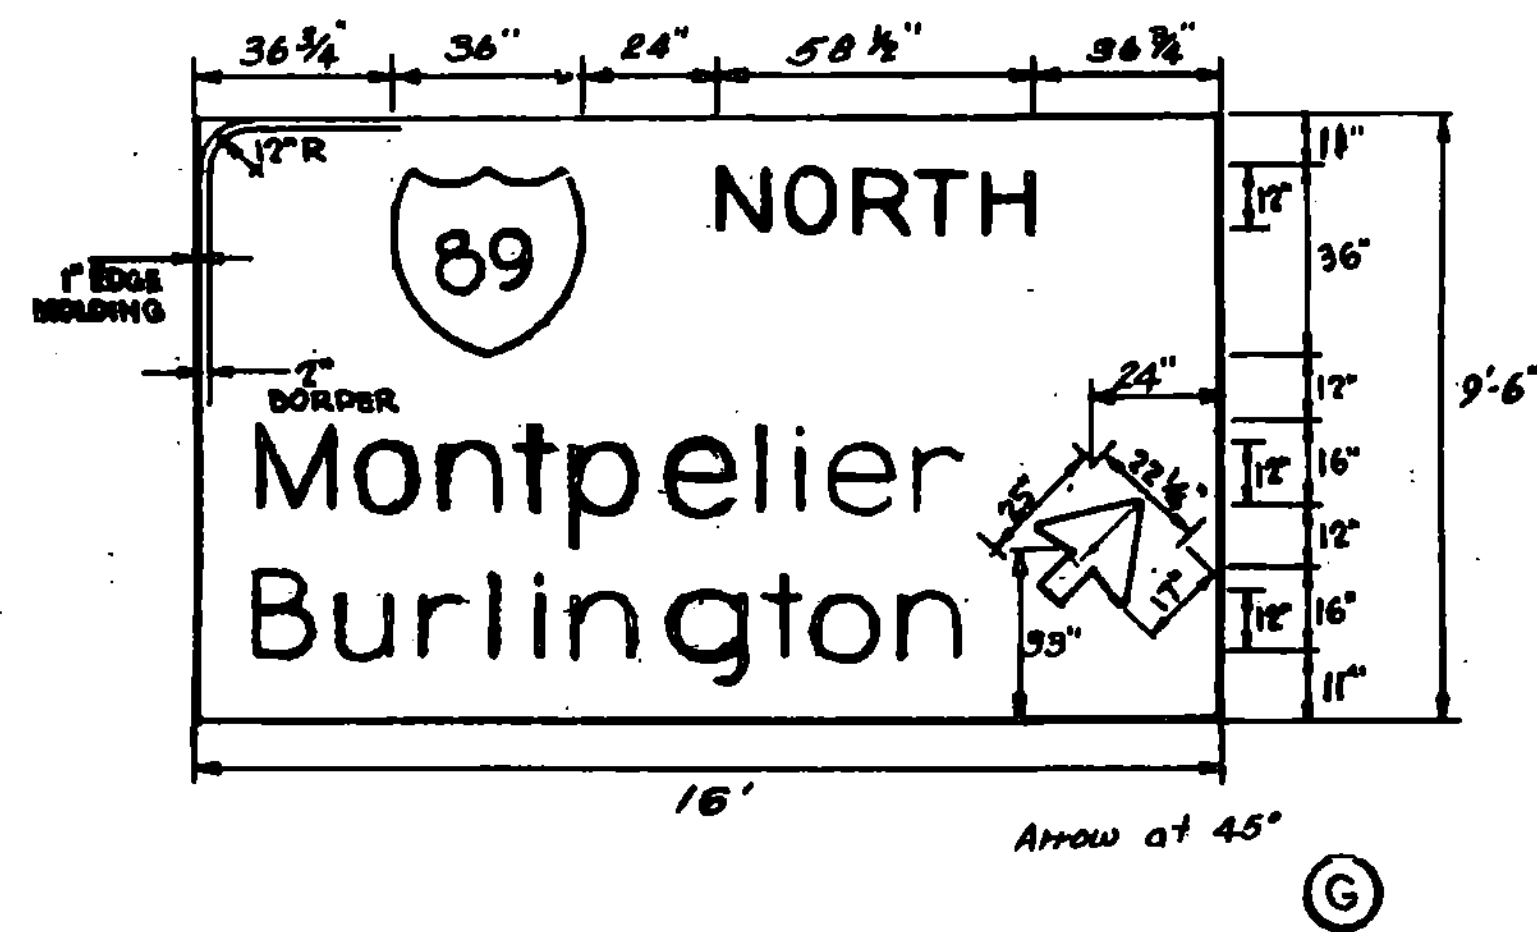
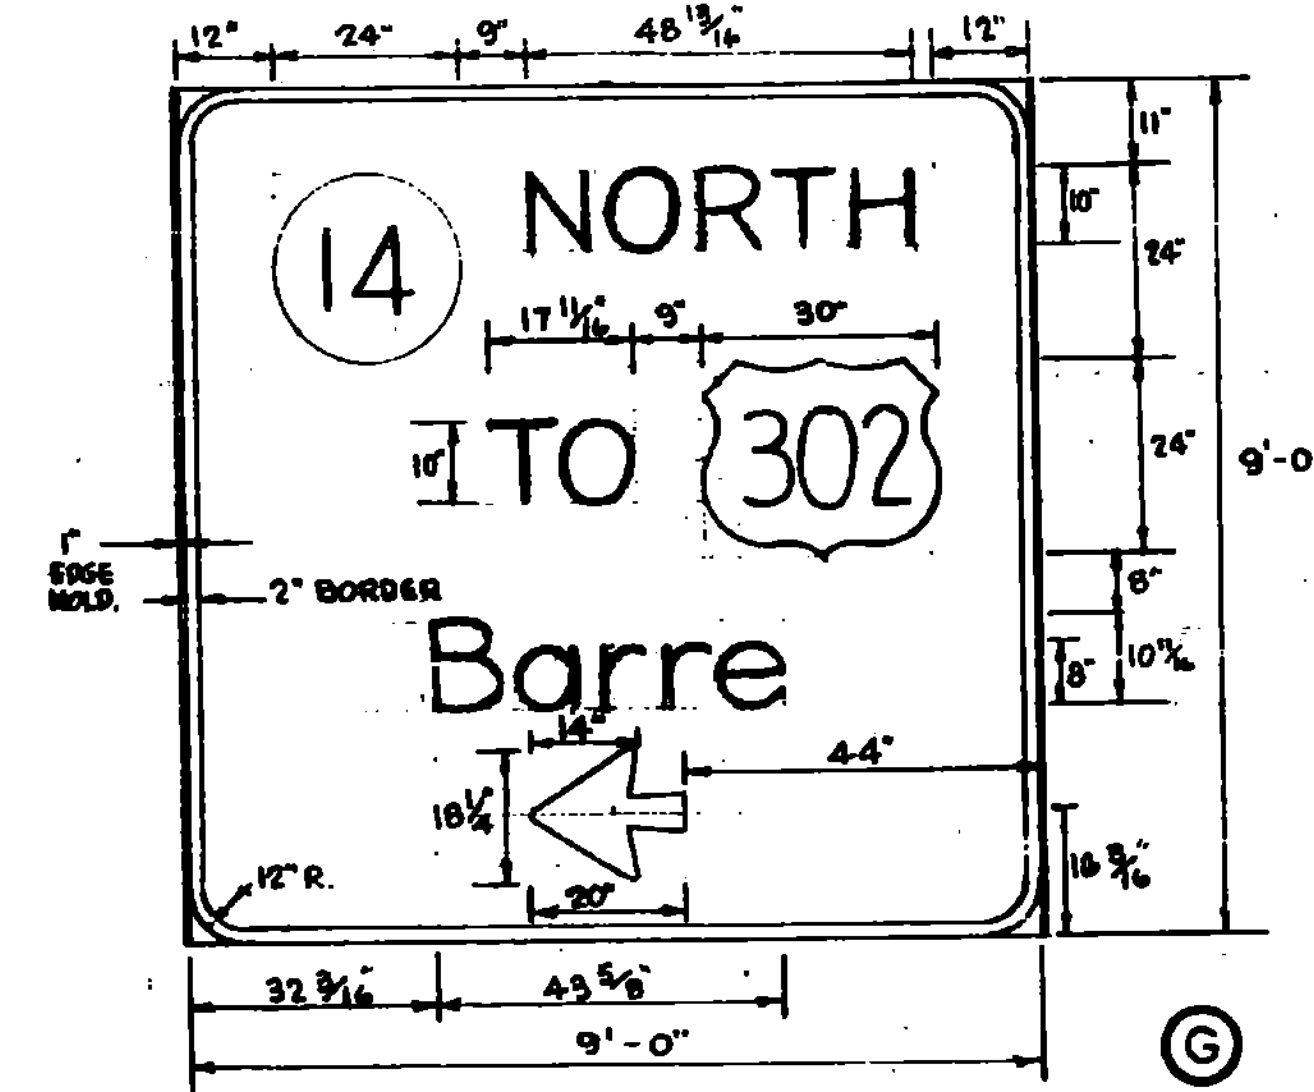


TEXTS:
 19 1/2"
 FOOD I 3" E SERIES
 15"
 GAS I 3" E SERIES
 22 7/8"
 LODGING I 3" C SERIES
 23 1/2"
 CAMPING I 3" C SERIES

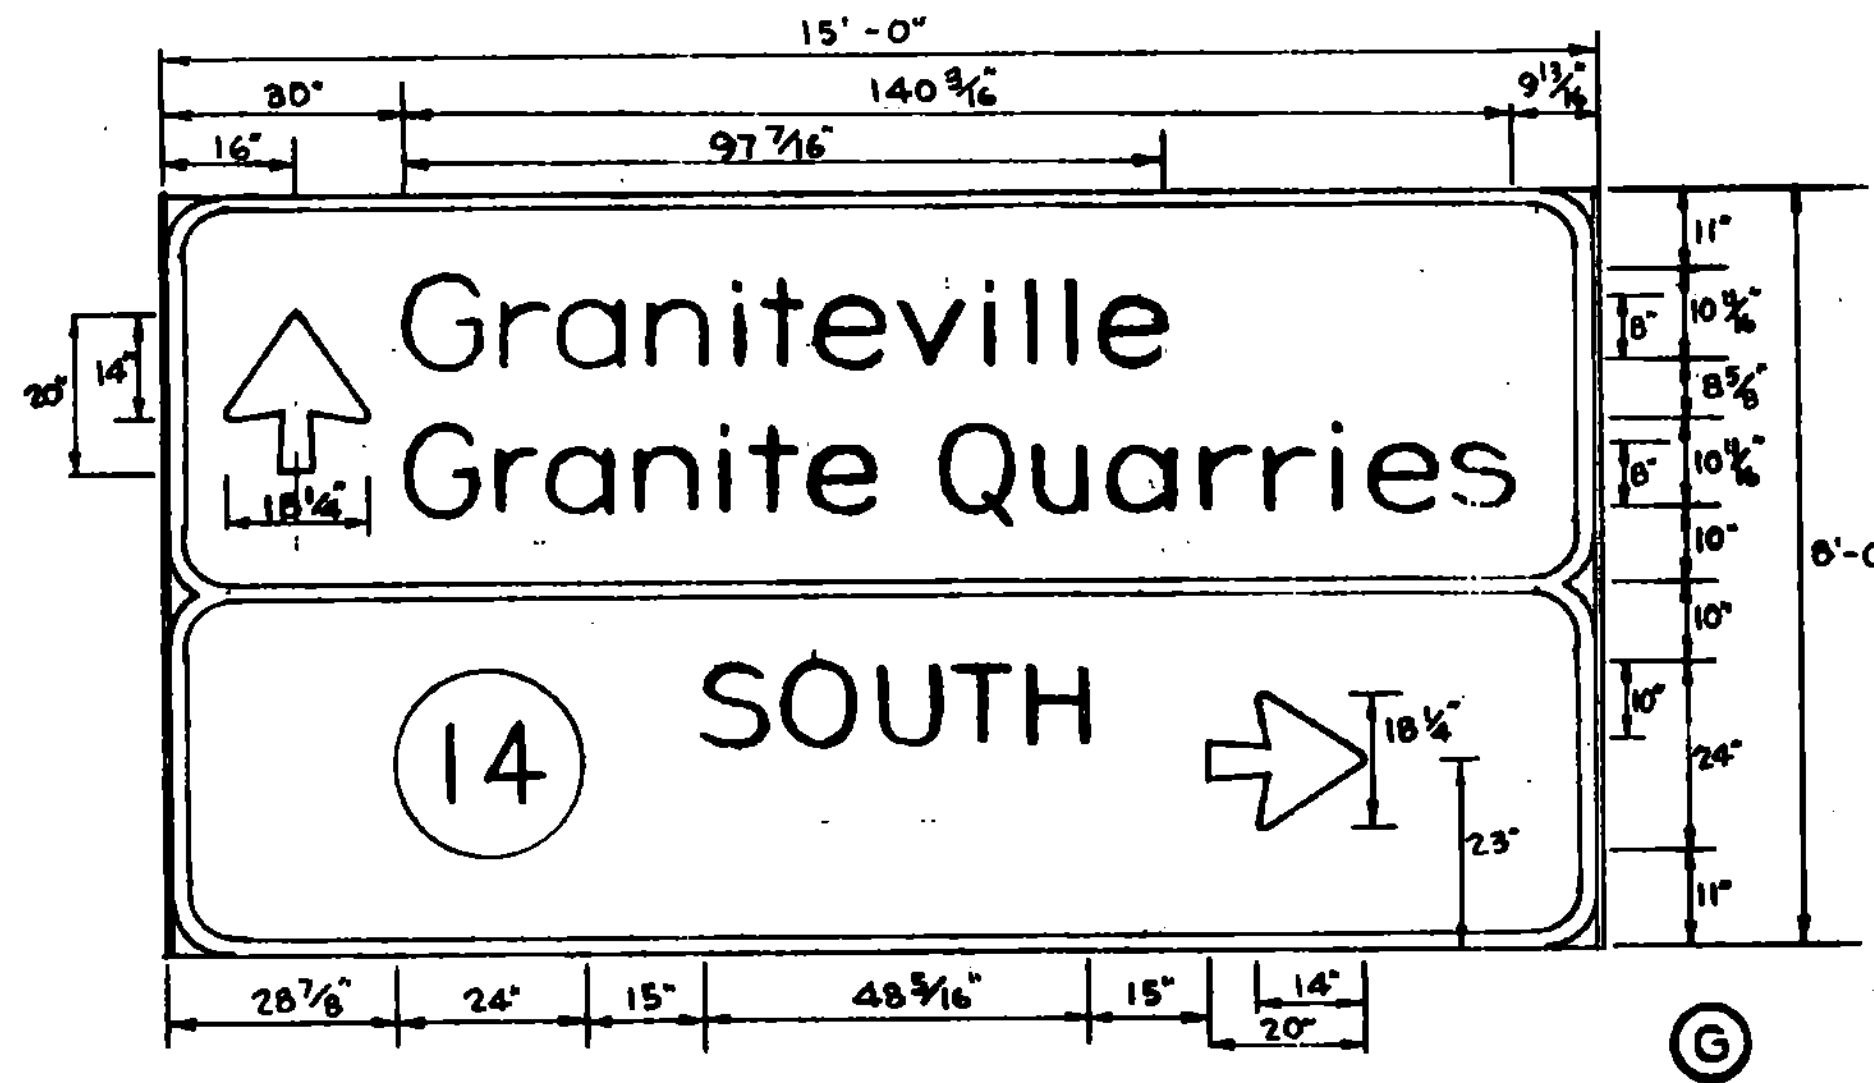

COLOR (REFLECTORIZED)
 TEXT AND ARROWS - WHITE
 BACKGROUND - BLUE
 Refer to Std. Sht. E-23
 for materials and other
 specifications

(S)

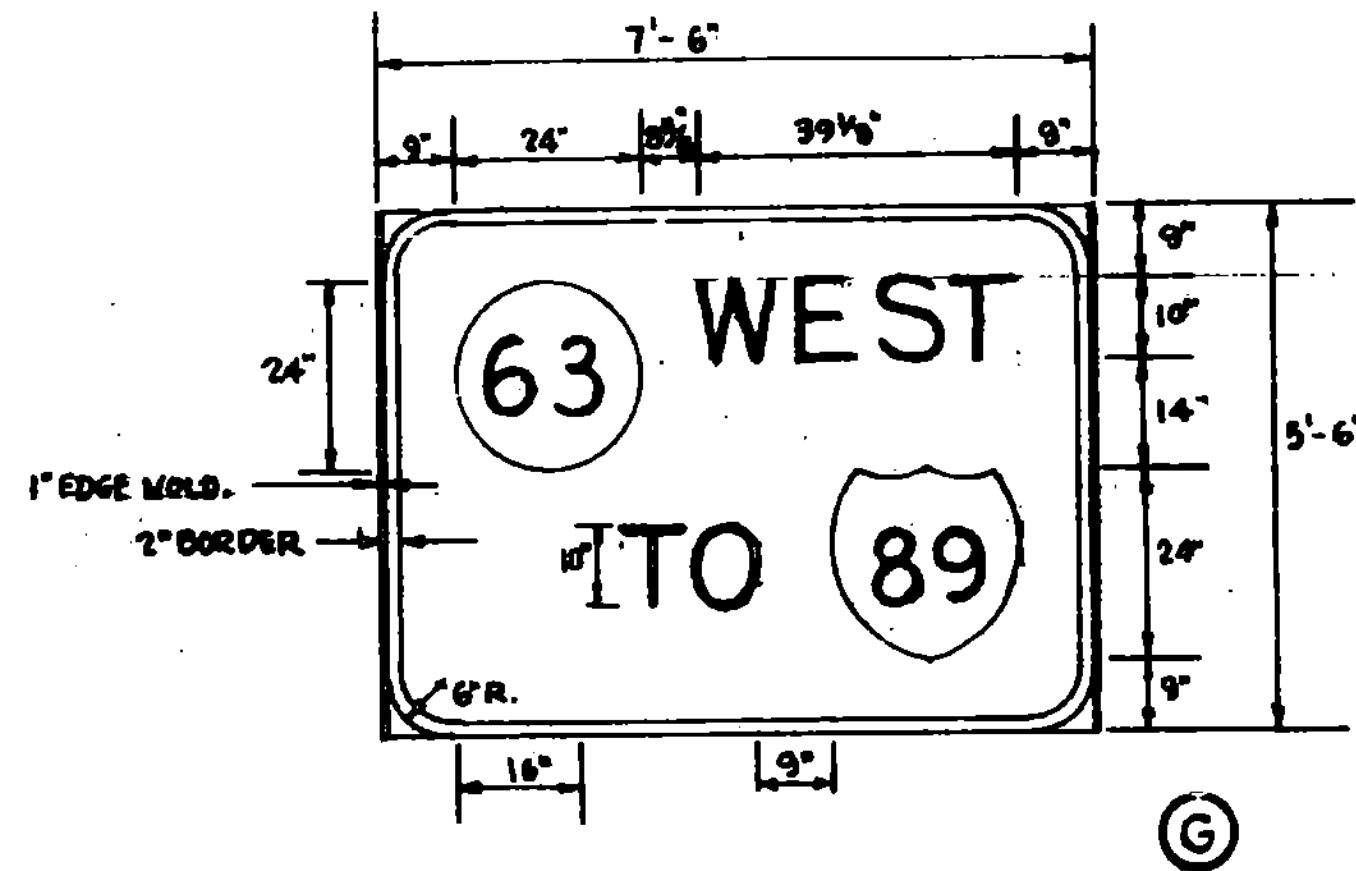

LEGEND

- (G) GUIDE SIGN
- (S) SERVICES SIGN
- (W) WARNING SIGN

SEE STANDARD SHTS. E-14, E-19 AND
 E-23 FOR APPROPRIATE COLORS, MATERIALS
 AND OTHER DETAILS.

SIGN DETAIL SHEET

CHECKED BY: BERLIN - BARRE DATE: _____
 PROJ. NO. STATEWIDE F-SFTY (85) NO. _____
 TRAFFIC SHEET NO. 543 SHEET 97 OF 200