


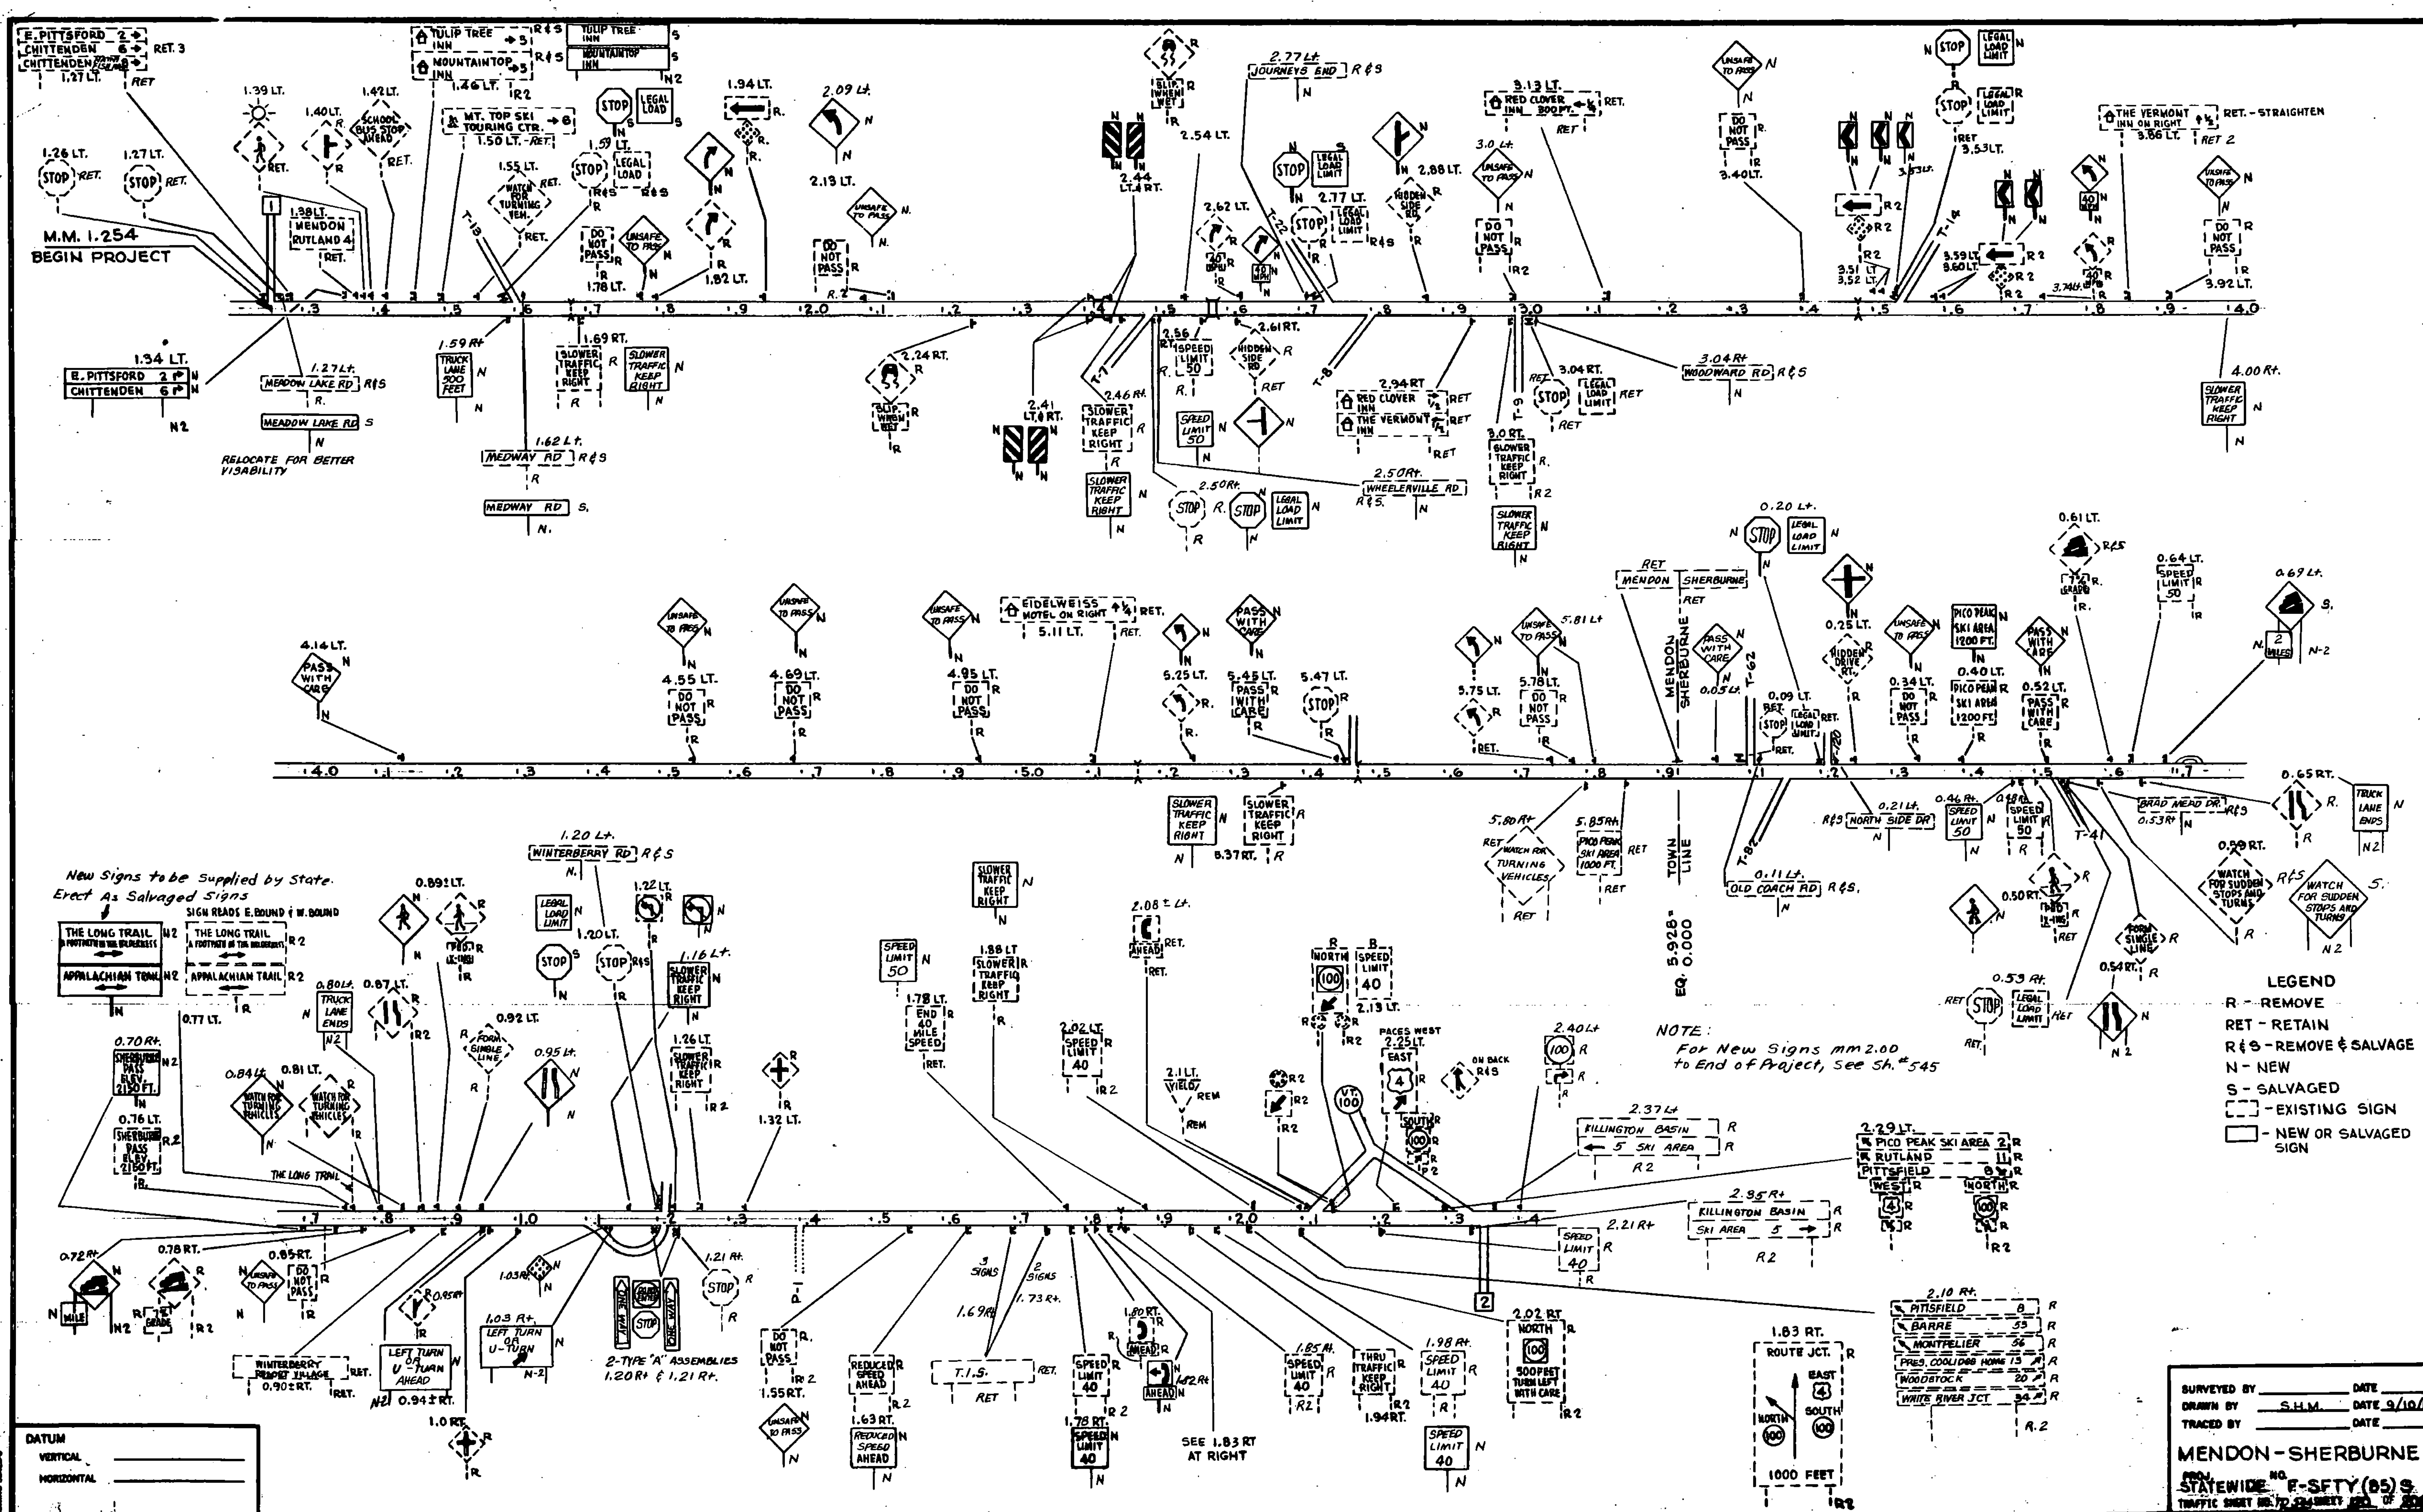

SURVEYED BY _____ DATE _____
 DRAWN BY S.H.M. DATE 9/10/85
 TRACED BY _____ DATE _____

MENDON-SHERBURNE
 STATEWIDE F-SFTY (85) S
 TRAFFIC SIGN REPAIR SURVEY OF 200