


PROJECT DESCRIPTION AND LOCATION

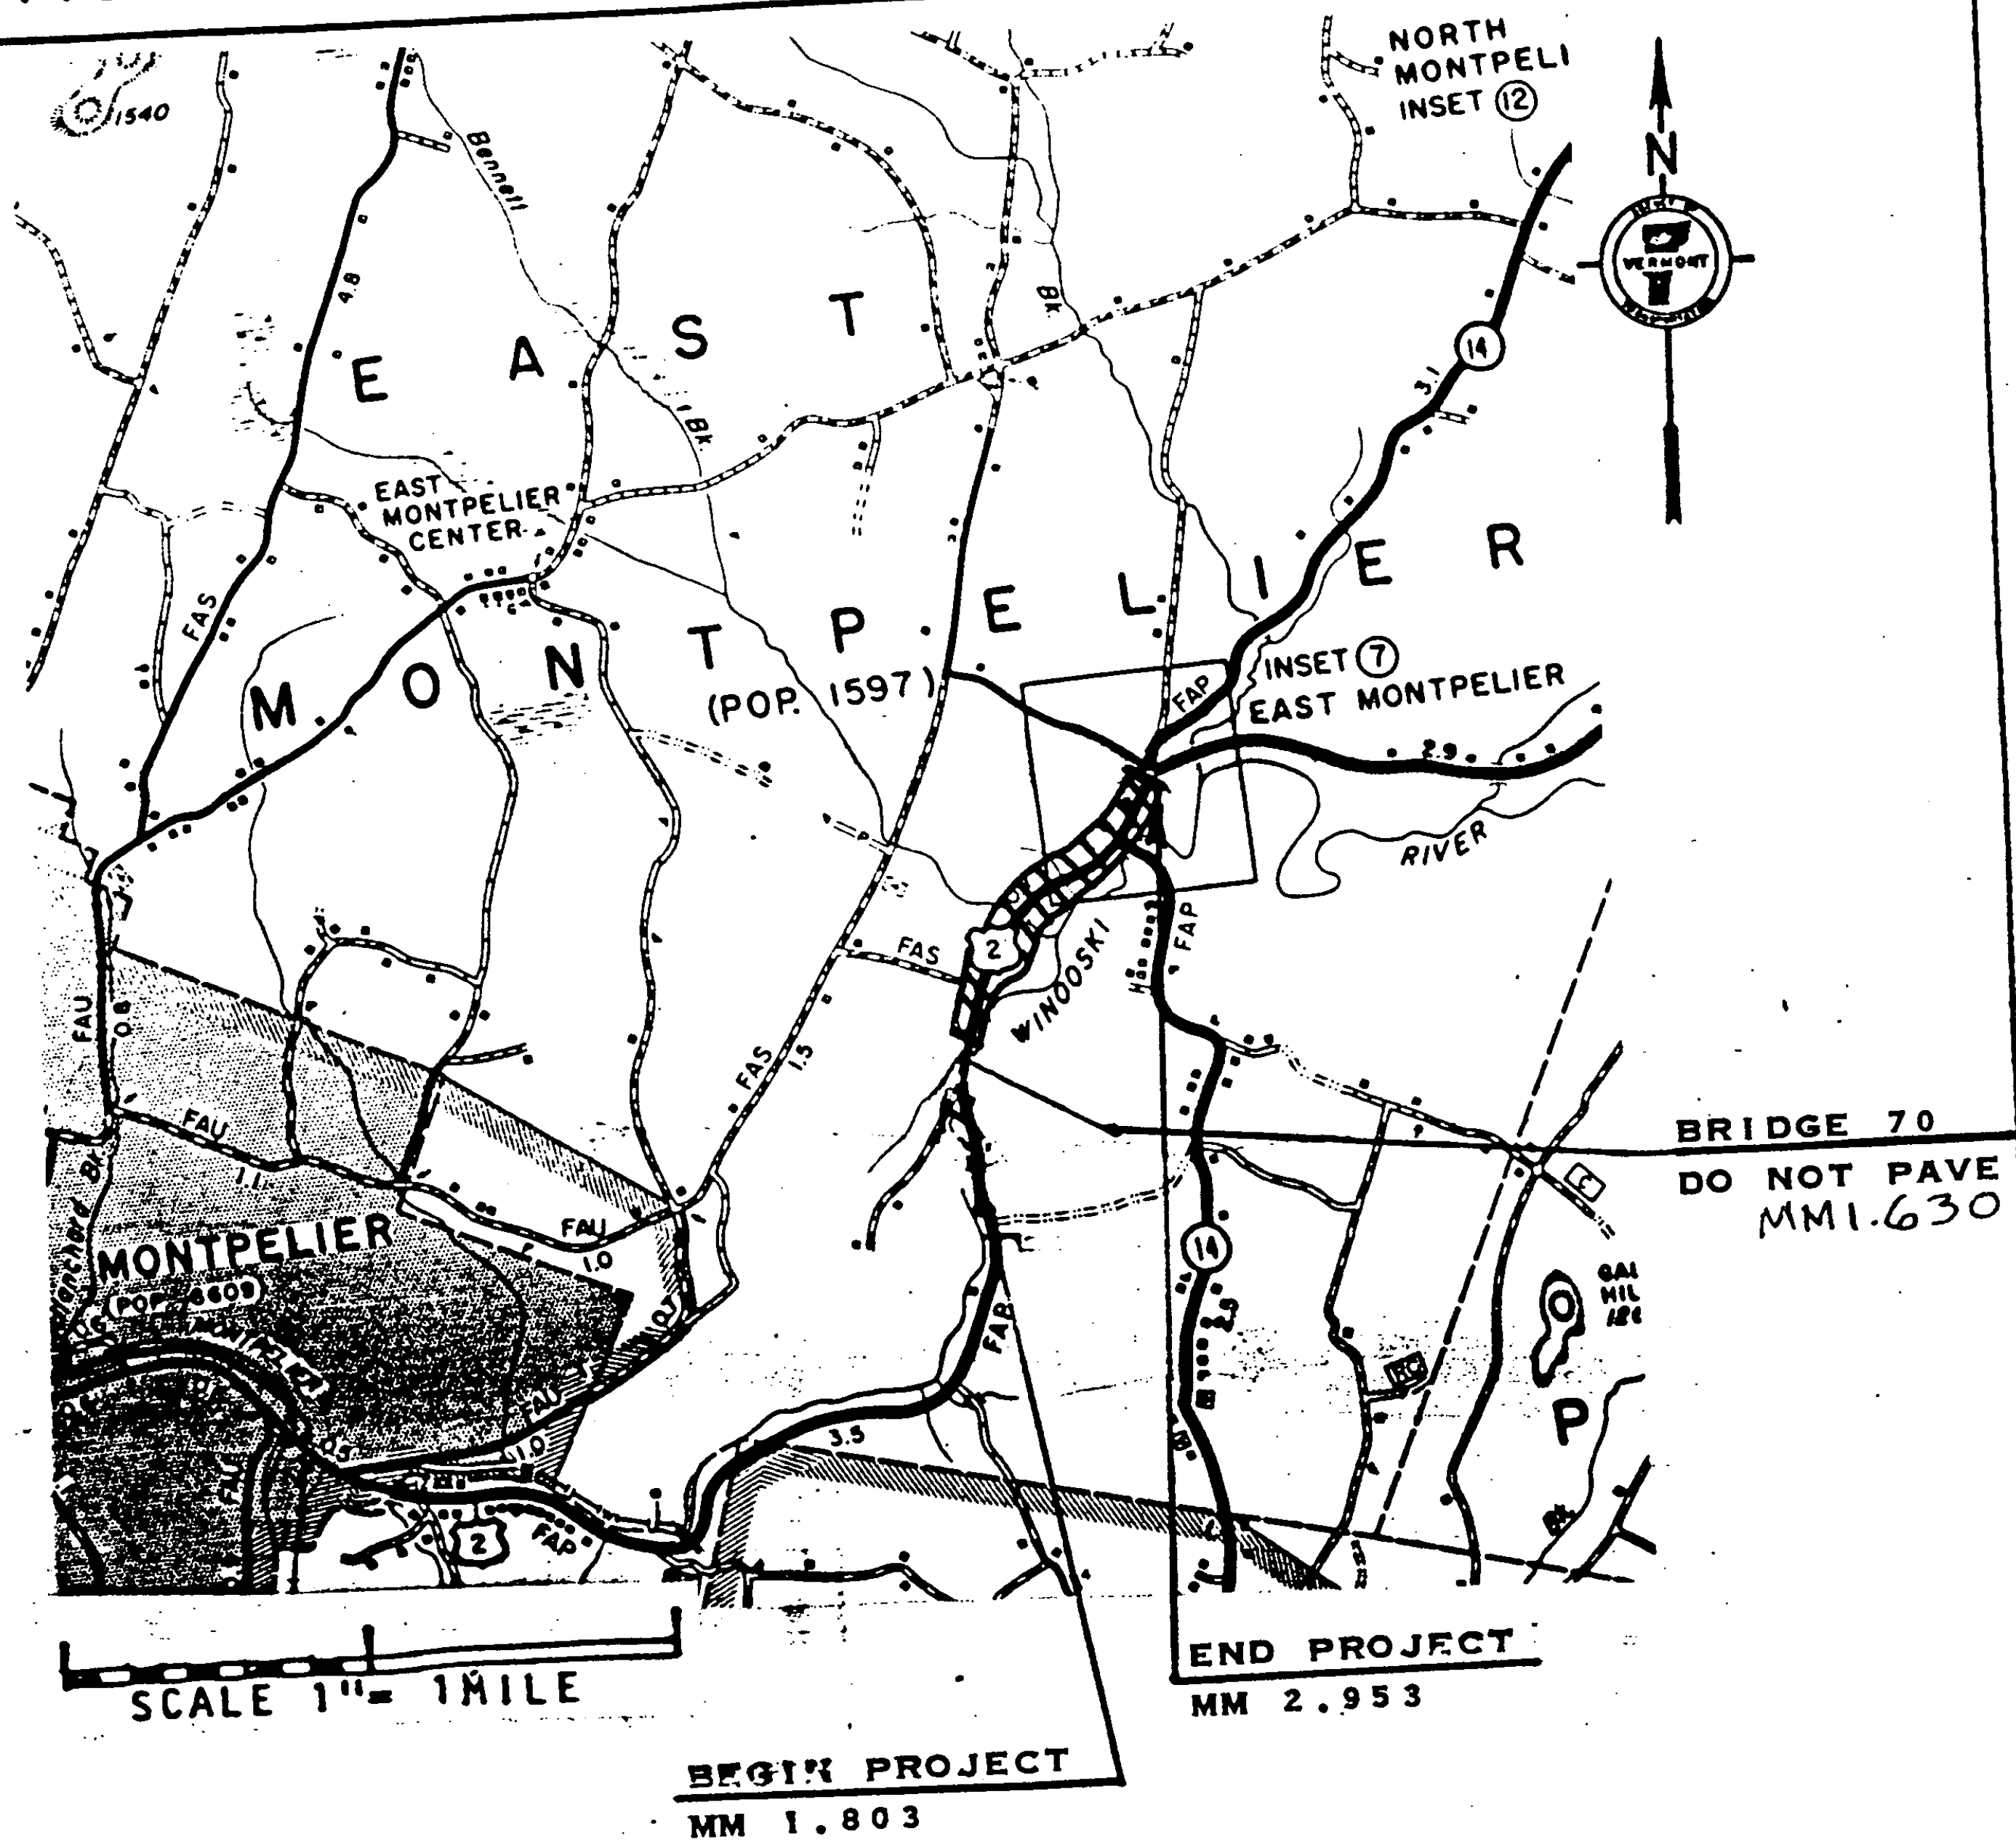

US2-BEGINNING IN EAST MONTPELIER AT MM 1.803 AND EXTENDING
NORTHERLY 1.150 MILES TO MM 2.953, THE JUNCTION OF US 2
AND VT 14

LENGTH OF PROJECT
1.150 MILES
6072 FEET

PROJECT EAST MONTPELIER

NO. HMA 2615
SHEET 5 OF 20 SHEETS