


TYPICAL SECTIONS & DESIGN DATA

ITEM 406.25 BITUMINOUS CONCRETE PAVEMENT
LEVELING COURSE TYPE III OR IV (327 TONS/MILE)
AS DIRECTED BY THE ENGINEER
1 1/2" WEARING COURSE TYPE III (#1/4)

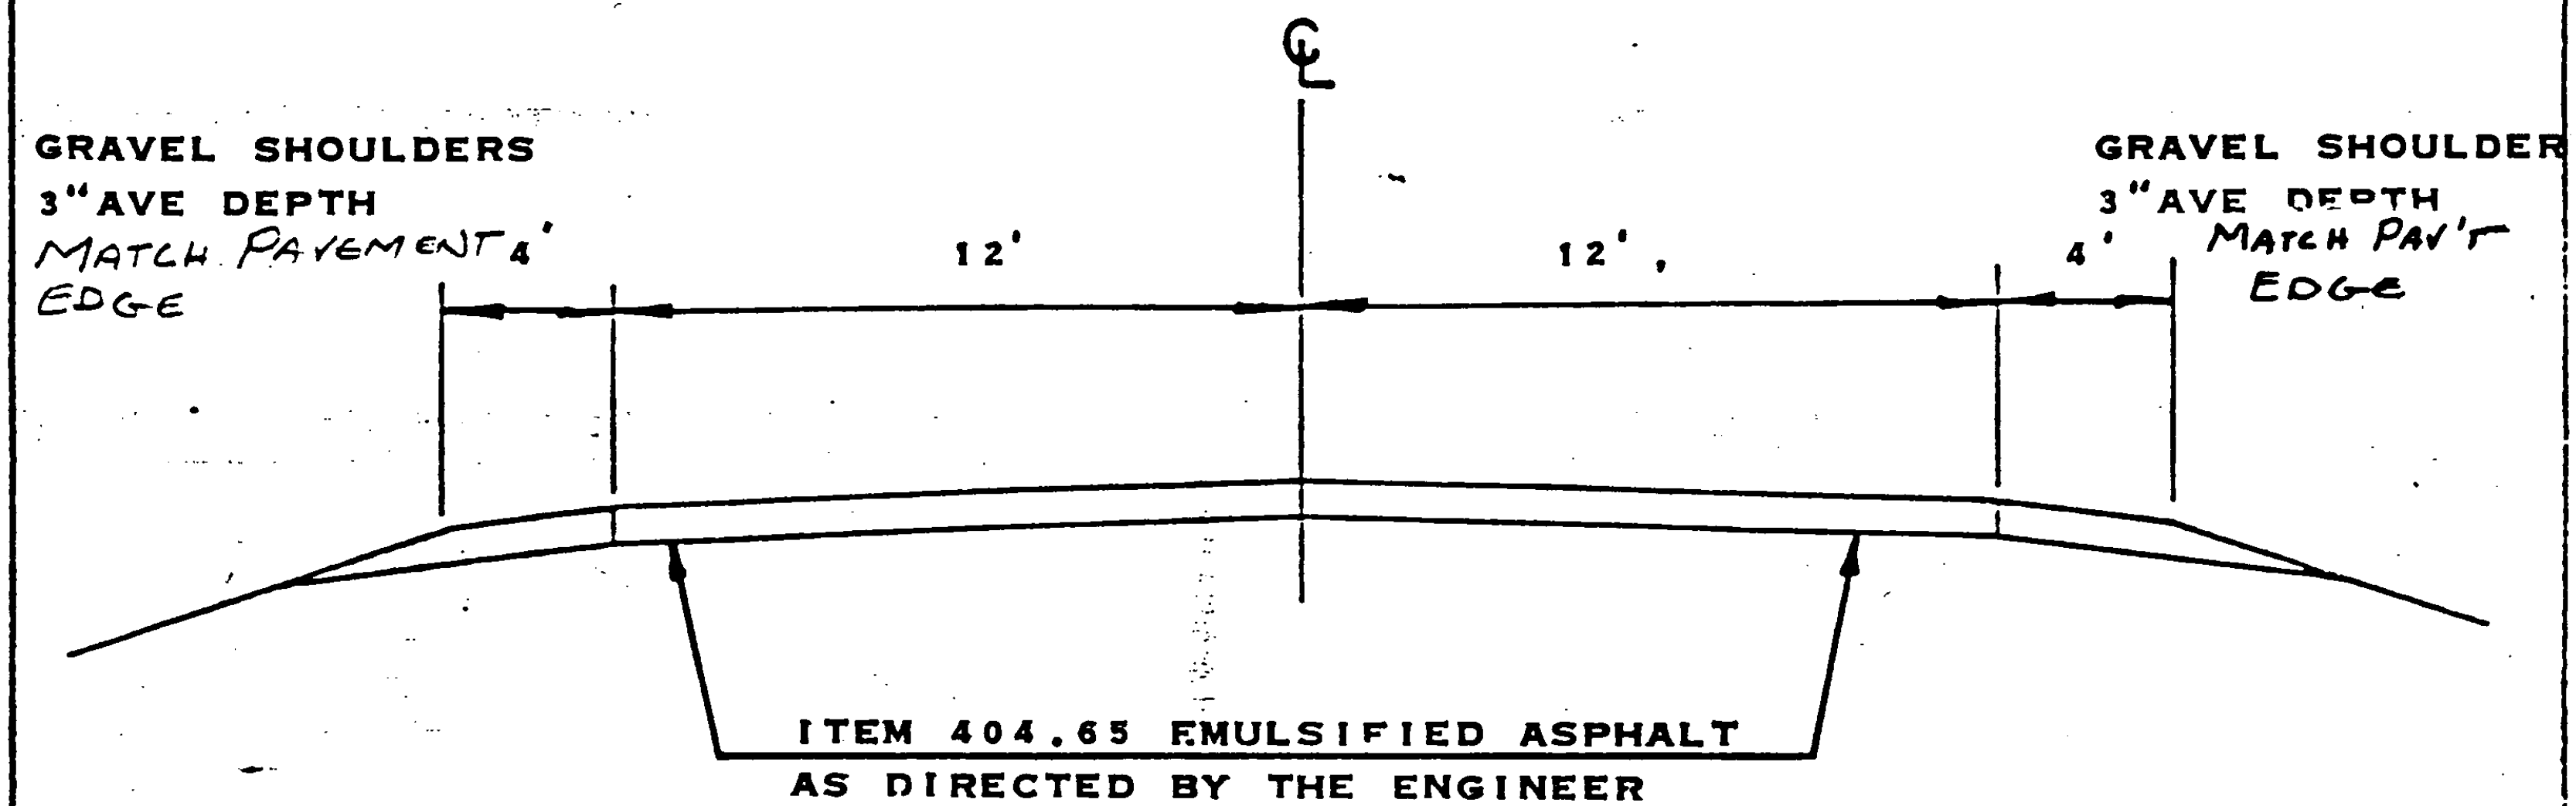

1980 ADT 5260
V 50

NOHMA 2615

PROJECT EAST MONTPELIER-

SHEET 6 OF 20 SHEETS